FED. ROAD DIST. NO.	STATE	FED. AID PROJ. NO.	FISCAL YEAR	SHEET NO.	TOTAL SHEETS
HAWAII	HAW.	I-HI-1(174):16	1982	1	70

INDEX TO DRAWINGS

	SHEET NO.	DESCRIPTION
	1	TITLE SHEET
	2	TYPICAL SECTION
	3	RAMP IF - PLAN
	4	RAMP IF - TAPER PLAN
	5	RAMP IF - PROFILE & SUPERELEVATION
	6	DETAILS - ROADWAY & DRAINAGE
*	7	CUSHION BARRIER
**	8-11	STANDARD DETAILS
	12	SIGN / STRIPING
	13-17	LIGHTING
***	18-59	RAMP IF - STRUCTURE
	60-68	LANDSCAPING
	69-70	CROSS SECTION

ADDED PLAN SHEETS SUPPLEMENTARY TO THIS PROJECT.
* 7S-1 ; ** 11S-1, 11S-2 ;
*** C.O. 27S-1

STATE OF HAWAII

DEPARTMENT OF TRANSPORTATION
HIGHWAYS DIVISION

HONOLULU, HAWAII

"AS-BUILT"

PLANS FOR

CONSTRUCTION OF A PORTION OF

INTERSTATE ROUTE H-1

AIRPORT INTERCHANGE

RAMP IF

FEDERAL AID INTERSTATE PROJECT I-HI-1(174):16

DISTRICT OF HONOLULU
ISLAND OF OAHU

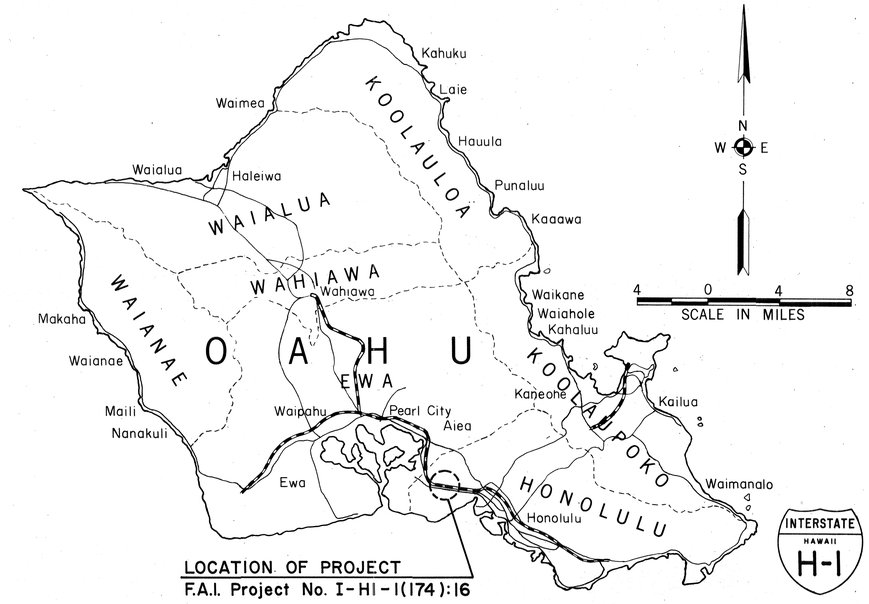

DESIGN CLASSIFICATION

DESIGN ADT (1994)	102,675
DHV	11 %
D	60/40
T	5 %
V	60 M.P.H.

SCALES:

PLANS	HOR.	1" = 50'
PROFILES	HOR.	1" = 50'
	VER.	1" = 10'
DETAIL ROADWAY PLANS	HOR.	1" = 20'
CROSS SECTIONS	HOR.	1" = 10'
	VER.	1" = 5'

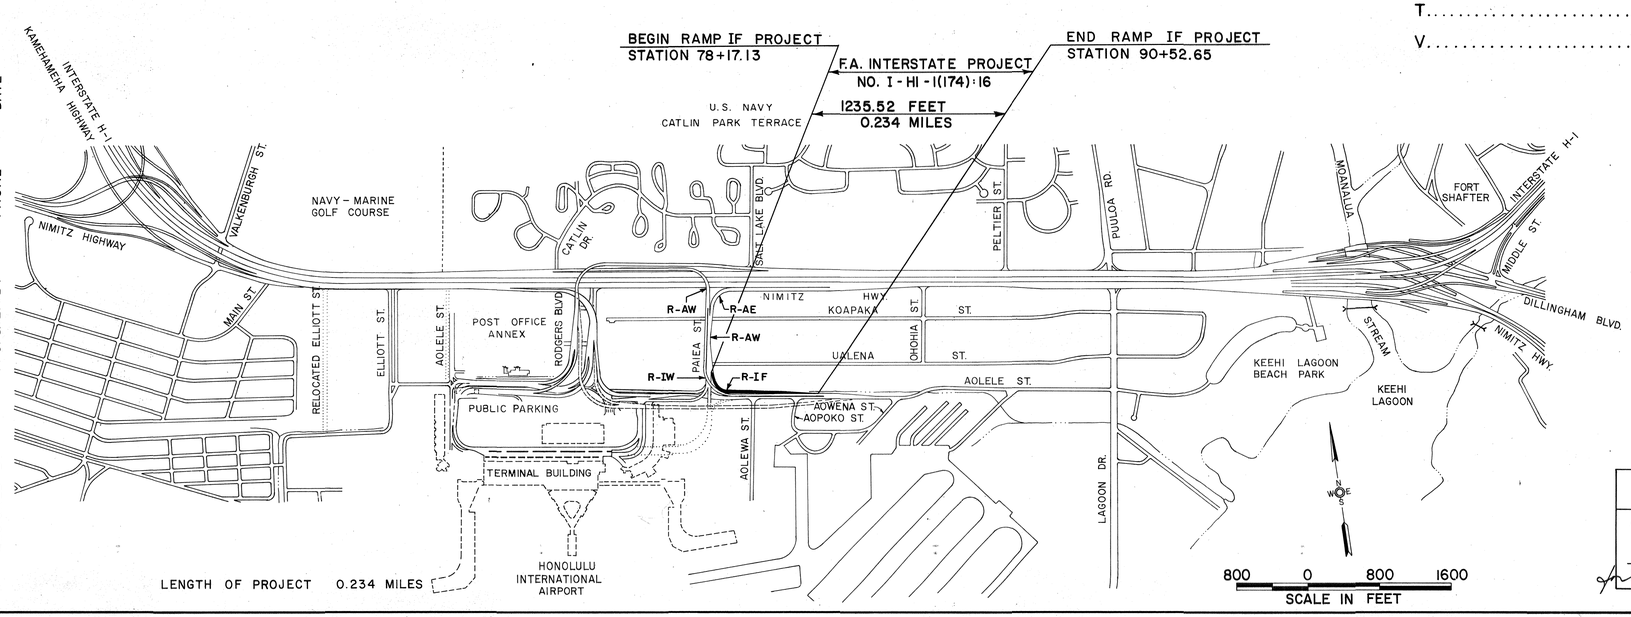

LENGTH OF PROJECT 0.234 MILES

CHANGES MADE DURING CONSTRUCTION HAVE BEEN INCORPORATED ON THESE PLANS EXCEPT CHANGES IN THE ORIGINAL THEORETICAL QUANTITIES. FOR ACTUAL QUANTITIES, REFER TO PROJECT LEDGER AND/OR COMPUTATION BOOK.

Kelvin Akazawa
for RESIDENT ENGINEER — 1-30-87 DATE

DEPARTMENT OF TRANSPORTATION FEDERAL HIGHWAY ADMINISTRATION	
APPROVED:	
DIVISION ADMINISTRATOR	9/30/82 DATE

DEPARTMENT OF TRANSPORTATION STATE OF HAWAII	
APPROVED:	
Ryokichi Higashionna DIR. OF TRANSPORTATION	9/28/82 DATE

9/29/82	521-3051	CLAUDE INAKE	URS / N-M
DATE	PHONE	P. S. & E. BY	DESIGNED BY

DD 7-8-22