FED. ROAD DIST. NO.	STATE	FED. AID PROJ. NO.	FISCAL YEAR	SHEET NO.	TOTAL SHEETS
HAWAII	HAW.	HPR-0010 (~~6~~) 7 U-1, U-2, U-~~3~~ 5 6 7	1985	1	10

INDEX TO DRAWINGS

SHEET NO.	DESCRIPTION
1	TITLE SHEET
2-6	INSTALLATION OF SPEED MONITORING SYSTEMS AT VARIOUS LOCATIONS
7	TYPICAL INSTALLATION ALL ISLANDS
8-10	STANDARD DETAILS

STATE OF HAWAII

DEPARTMENT OF TRANSPORTATION

HIGHWAYS DIVISION

"AS-BUILT"

PLANS FOR

INSTALLATION OF SPEED MONITORING SYSTEMS AT VARIOUS LOCATIONS

FEDERAL AID PROJECT NO. HPR-0010 (~~6~~) 7 UNIT ~~1~~ 5 (ISLAND OF OAHU)
FEDERAL AID PROJECT NO. HPR-0010 (~~6~~) 7 UNIT ~~2~~ 6 (ISLAND OF HAWAII)
FEDERAL AID PROJECT NO. HPR-0010 (~~6~~) 7 UNIT ~~3~~ 7 (ISLAND OF MAUI)

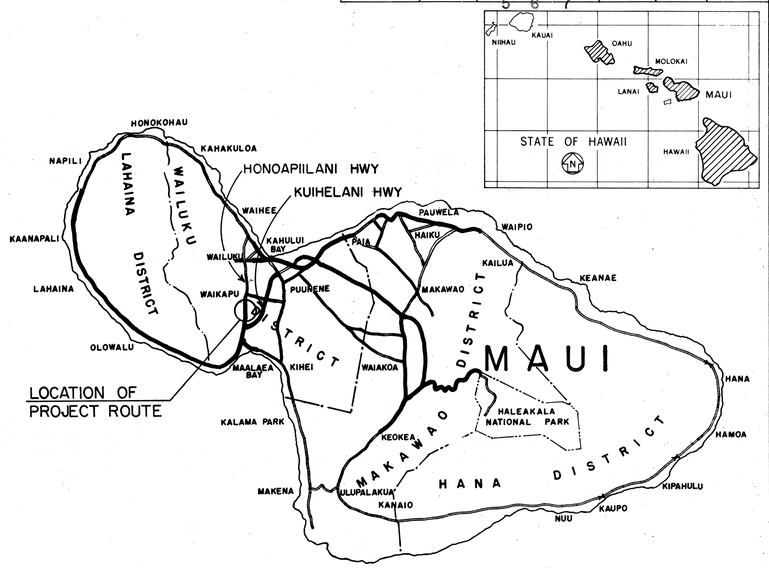

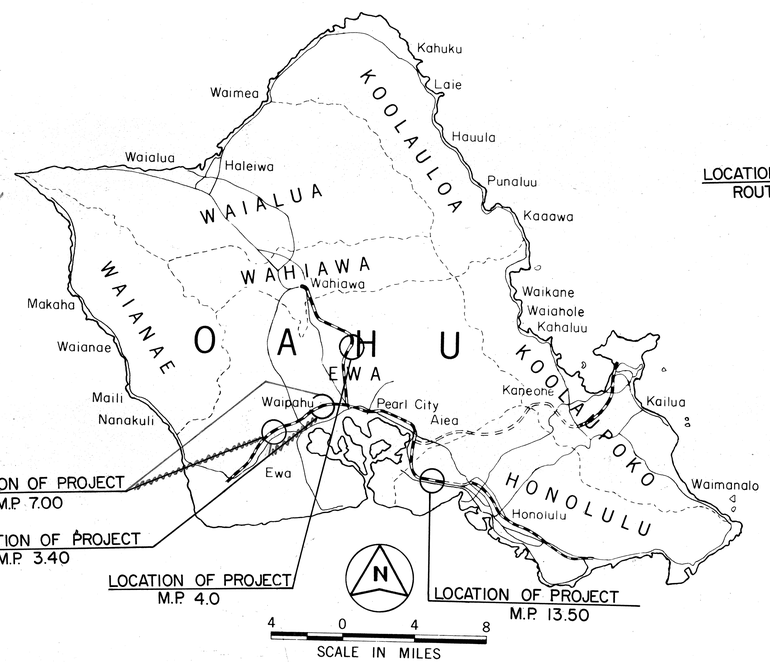

FEDERAL AID
PROJECT NO. HPR-0010 (~~6~~) 7 UNIT ~~1~~ 5
DISTRICT OF EWA

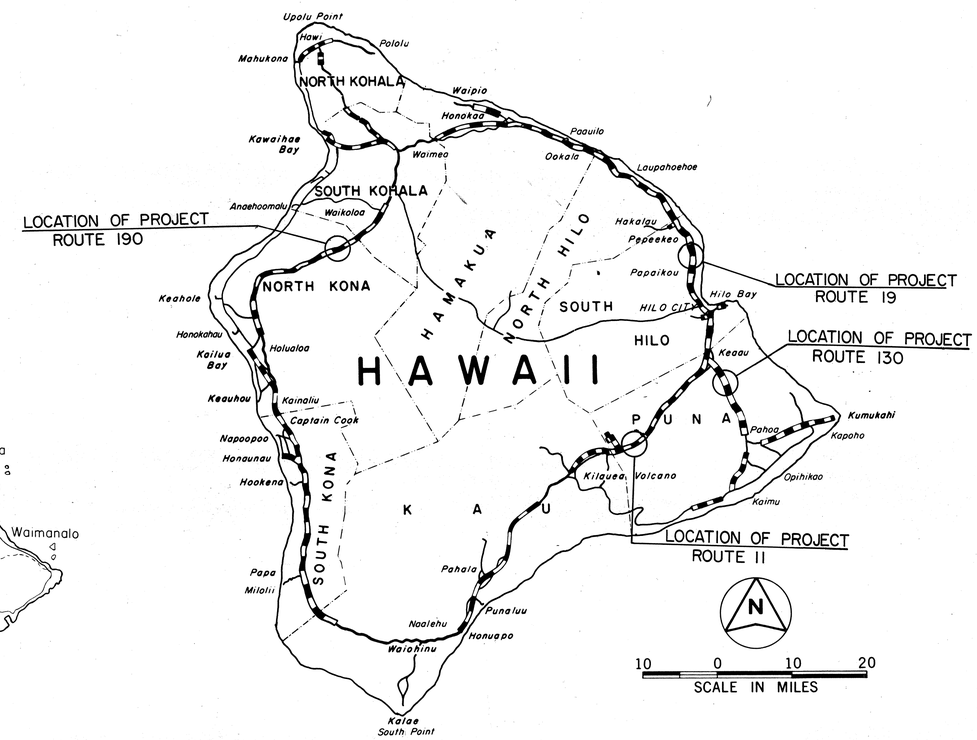

FEDERAL AID
PROJECT NO. HPR-0010 (~~6~~) 7 UNIT ~~2~~ 6
DISTRICTS OF SOUTH HILO, PUNA AND NORTH KONA

N
5 0 5 10
SCALE IN MILES

FEDERAL AID
PROJECT NO. HPR-0010 (~~6~~) 7 UNIT ~~3~~ 7
DISTRICT OF WAILUKU

CHANGES MADE DURING CONSTRUCTION HAVE BEEN INCORPORATED ON THESE PLANS EXCEPT CHANGES IN THE ORIGINAL THEORETICAL QUANTITIES. FOR ACTUAL QUANTITIES, REFER TO PROJECT LEDGER AND/OR COMPUTATION BOOK.

Manuel J. Silva RESIDENT ENGINEER, MAUI	28 JUN 85 DATE
Phil Almeastre RESIDENT ENGINEER, OAHU	2/19/86 DATE
Barry Timum RESIDENT ENGINEER, HAWAII	3-10-86 DATE

DEPARTMENT OF TRANSPORTATION FEDERAL HIGHWAY ADMINISTRATION	
APPROVED: for DIVISION ADMINISTRATOR	10/3/84 DATE

DEPARTMENT OF TRANSPORTATION STATE OF HAWAII	
APPROVED: DIR. OF TRANSPORTATION	9/12/84 DATE

HWY-TE DESIGNED BY
A. YAMAGUCHI P. S. & E. BY
548-4125 PHONE
SEPT. 1984 DATE

C-6-6