| FED. ROAD DIST. NO. | STATE | FED. AID PROJ. NO. | FISCAL YEAR | SHEET NO. | TOTAL SHEETS |
|---|---|---|---|---|---|
| HAWAII | HAW. | IR-HI-1(196) | 1986 | 1 | 22 |

INDEX TO DRAWINGS


| SHEET NO. | DESCRIPTION |
|---|---|
| 1 | TITLE SHEET |
| 2 | GENERAL NOTES |
| 3 | TYPICAL SECTIONS AND DETAILS |
| 4 | PLAN |
| 5 | PAVEMENT GRADE PLAN |
| 6-9 C.O.6 S-1 | MISCELLANEOUS AND STANDARD ROADWAY DETAILS |
| 10-11 | DRAINAGE DETAILS |
| 12-16 | HIGHWAY LIGHTING AND INERTIAL BARRIER SYSTEM DETAILS |
| 17-22 | SIGNING AND PAVEMENT MARKING PLAN AND DETAILS |


TOTAL SHEET COUNT AFTER "AS BUILT" POSTINGS: 23 SHEETS.

STATE OF HAWAII

DEPARTMENT OF TRANSPORTATION
HIGHWAYS DIVISION
HONOLULU, HAWAII
"AS-BUILT"
PLANS FOR

# INTERSTATE ROUTE H-1
## HALAWA INTERCHANGE
# RESURFACING SETTLEMENT AREA IN VICINITY OF ALOHA STADIUM

FED. AID INTERSTATE PROJ. NO. IR-HI-1(196)

DISTRICT OF EWA
ISLAND OF OAHU

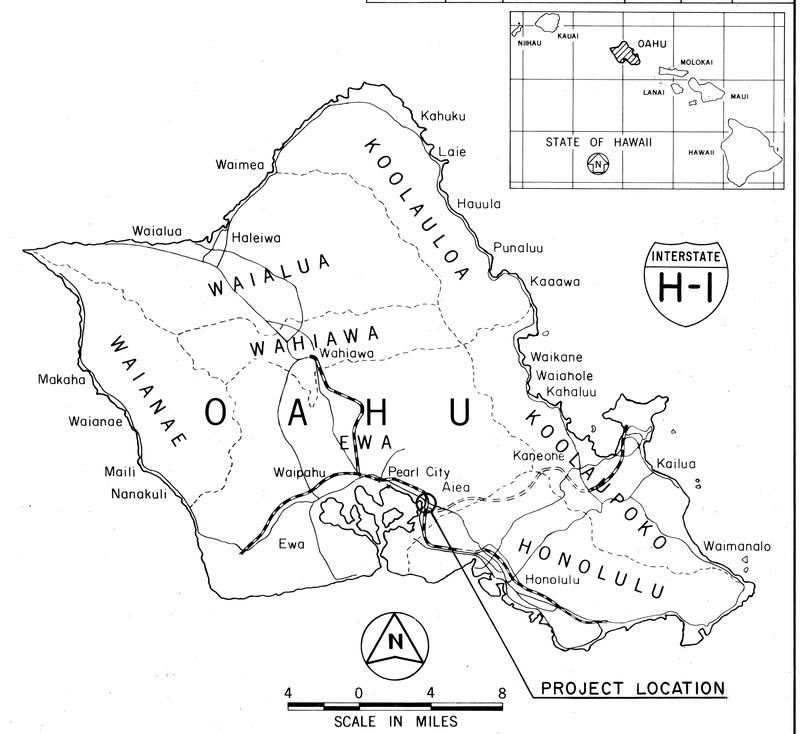


FEDERAL AID INTERSTATE PROJECTS PREVIOUSLY CONSTRUCTED OR UNDER CONSTRUCTION

CHANGES MADE DURING CONSTRUCTION HAVE BEEN INCORPORATED ON THESE PLANS EXCEPT CHANGES IN THE ORIGINAL THEORETICAL QUANTITIES. FOR ACTUAL QUANTITIES, REFER TO PROJECT LEDGER AND/OR COMPUTATION BOOK.

Philbert Alencastre 11/26/86
RESIDENT ENGINEER DATE

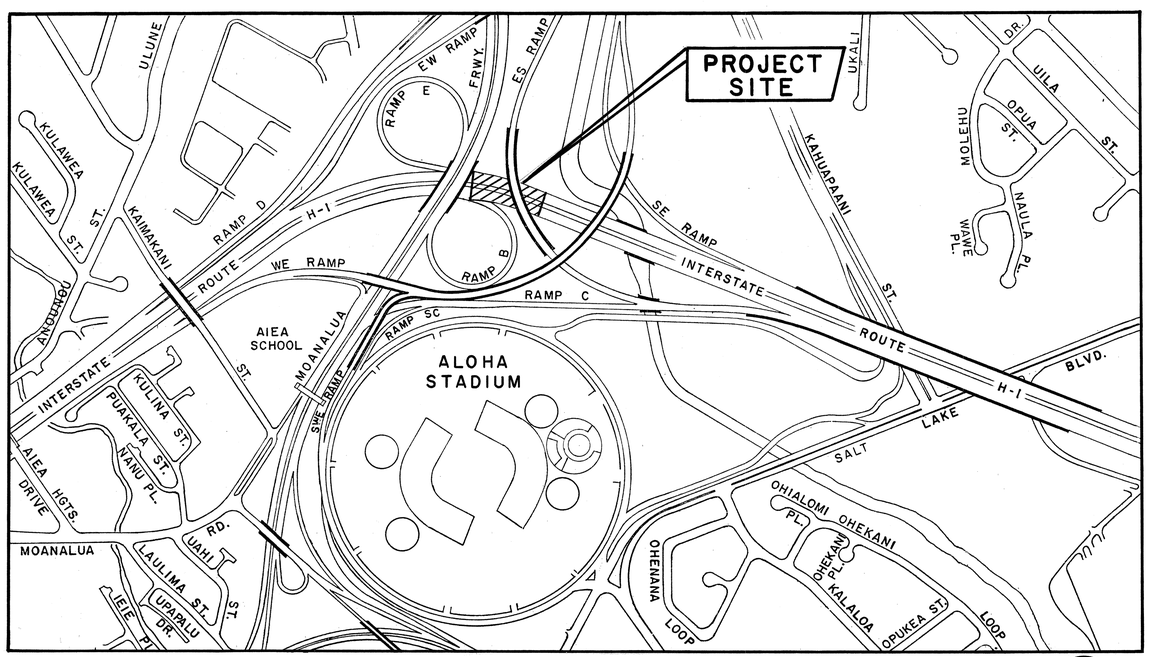


LAYOUT PLAN
LENGTH OF PROJECT: 0.085 MI.

| DEPARTMENT OF TRANSPORTATION FEDERAL HIGHWAY ADMINISTRATION | |
|---|---|
| APPROVED: | |
| for DIVISION ADMINISTRATOR | 10/9/85 DATE |

| DEPARTMENT OF TRANSPORTATION STATE OF HAWAII | |
|---|---|
| APPROVED: | |
| for DIR. OF TRANSPORTATION | 9/17/85 DATE |

ROY NAGASAKO — DESIGNED BY
ROY NAGASAKO — P. S. & E. BY
548-2456 — PHONE
SEPT. 1985 — DATE