


FED. ROAD DIST. NO.	STATE	PROJ. NO.	FISCAL YEAR	SHEET NO.	TOTAL SHEETS
HAWAII	HAW.	HIJ-01-89M	1989	5	9

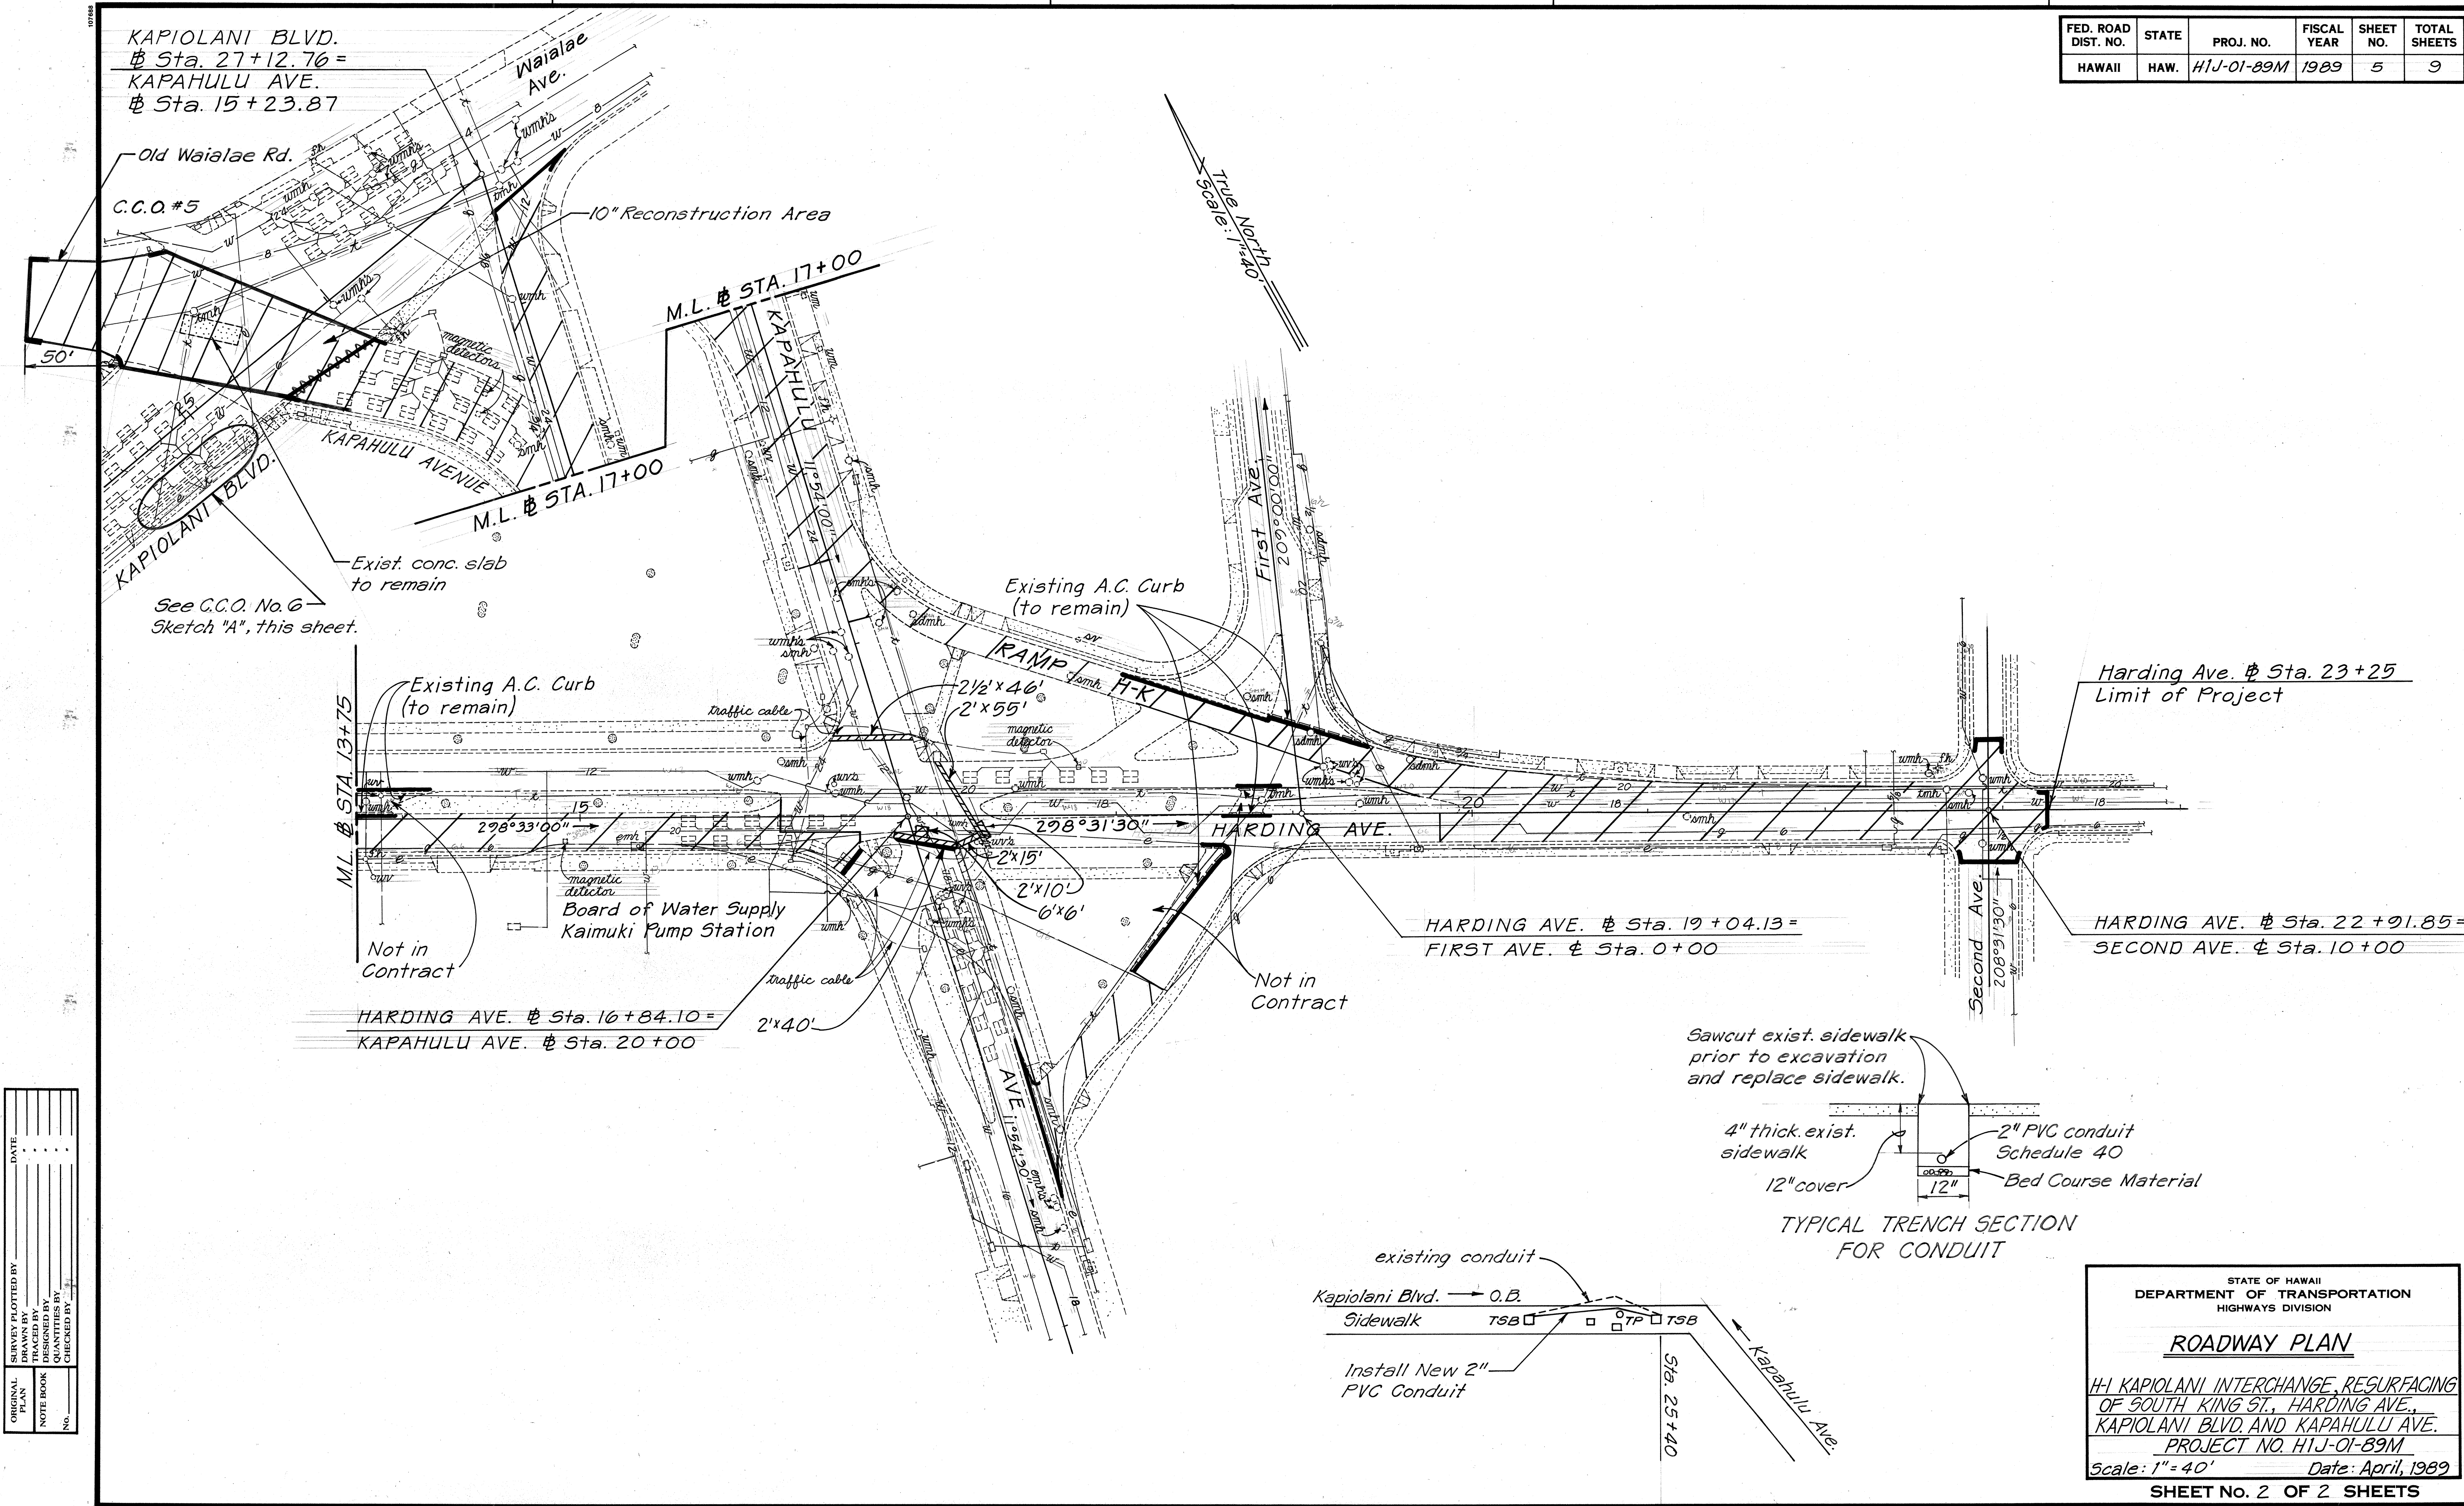

DATE	_____
SURVEY PLOTTED BY	_____
DRAWN BY	_____
DESIGNED BY	_____
QUANTITIES BY	_____
CHECKED BY	_____
ORIGINAL PLAN	_____
NOTE BOOK	_____
NO.	_____

STATE OF HAWAII
DEPARTMENT OF TRANSPORTATION
HIGHWAYS DIVISION

ROADWAY PLAN
HI KAPIOLANI INTERCHANGE, RESURFACING
OF SOUTH KING ST., HARDING AVE.,
KAPIOLANI BLVD. AND KAPAHULU AVE.
PROJECT NO. HIJ-01-89M
Scale: 1" = 40' Date: April, 1989
SHEET No. 2 OF 2 SHEETS