


| FED. ROAD DIST. NO. | STATE | FED. AID PROJ. NO. | FISCAL YEAR | SHEET NO. | TOTAL SHEETS |
|---|---|---|---|---|---|
| HAWAII | HAW. | HIC-01-90 | 1991 | 77 | 109 |

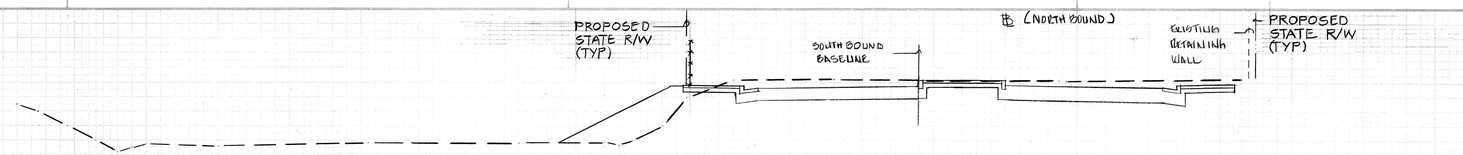


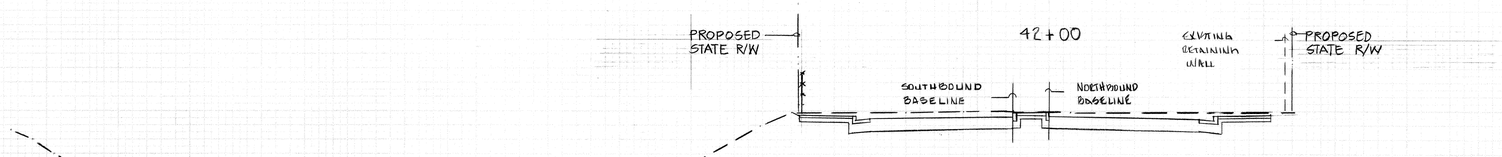

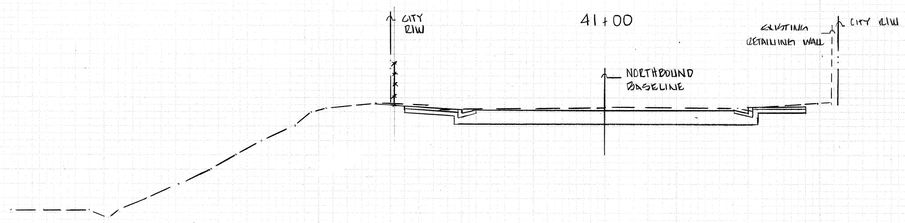




40+13.21 ℄

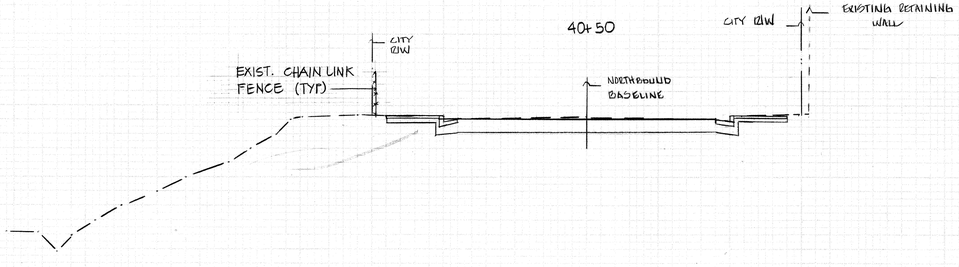CROSS SECTION NOTES:

1. BETWEEN STATION 40+13.21 TO 41+00, CROSS SECTIONS ARE DRAWN BASED ON THE NORTHBOUND BASELINE

2. BETWEEN STATIONS: 41+50 TO 53+50, CROSS SECTIONS ARE DRAWN IN TWO PARTS. PART 1 IS BASED ON THE SOUTHBOUND BASELINE, & IS DRAWN TO THE WEST MEDIAN CURB. PART TWO IS BASED ON THE NORTHBOUND BASELINE AND IS DRAWN FROM THE WEST MEDIAN CURB.

3. BETWEEN STATIONS: 54+11.04 SOUTHBOUND = 53+90.50 NORTHBOUND TO 58+99.30 SOUTHBOUND = 58+78.76 NORTHBOUND, CROSS SECTIONS ARE DRAWN BASED ON THE NORTHBOUND BASELINE WITH EQUIVALENT SOUTHBOUND STATIONS.

PAIWA ST. EXTENSION

SCALE: 1" = 10' HORZ
1" = 10' VERT

FINAL SURVEY — DATE, BY, SURVEYED, PLOTTED, TEMPLATE, NOTE BOOK, AREAS, AREAS CHECKED, NO.

ORIGINAL SURVEY — DATE, BY, SURVEYED, PLOTTED, TEMPLATE, NOTE BOOK, AREAS, AREAS CHECKED, NO.

84732

| FED. ROAD DIST. NO. | STATE | FED. AID PROJ. NO. | FISCAL YEAR | SHEET NO. | TOTAL SHEETS |
|---|---|---|---|---|---|
| HAWAII | HAW. | HIC-01-90 | 1991 | 78 | 109 |

FINAL SURVEY — NO. — NOTE BOOK — SURVEYED — PLOTTED — TEMPLATE — AREAS — AREAS CHECKED — BY — DATE

ORIGINAL SURVEY — NO. — NOTE BOOK — SURVEYED — PLOTTED — TEMPLATE — AREAS — AREAS CHECKED — BY — DATE

℄ (NORTHBOUND)

SOUTHBOUND BASELINE

NAUPLINE

NORTHBOUND BASELINE

130 120 110

45+00

SEE RAMP "C" FOR CONT.

SOUTHBOUND BASELINE

NORTH BOUND BASELINE

SEE RAMP "B" FOR CONT.

130 120 110

SEE RAMP "C" FOR CONT.

44+50

SOUTHBOUND BASELINE

NORTHBOUND BASELINE

120 110

PROPOSED STATE R/W

SOUTHBOUND BASELINE

44+00

NORTHBOUND BASELINE

PROPOSED STATE R/W

120 110

PROPOSED STATE R/W

SOUTHBOUND BASELINE

43+50

NORTHBOUND BASELINE

EXISTING RETAINING WALL

PROPOSED STATE R/W

120 110

PROPOSED STATE R/W (TYP)

NEW 6 FT. HI CHAIN LINK FENCE (TYP)

SOUTHBOUND BASELINE

43+00

NORTHBOUND BASELINE

EXISTING RETAINING WALL

PROPOSED STATE R/W (TYP)

120 110

42+50

180 170 160 150 140 130 120 110 100 90 80 70 60 50 40 30 20 10 ℄ 10 20 30 40 50 60 70 80 90 100 110 120

## PAIWA ST. EXTENSION


SCALE: 1" = 10' HORZ
1" = 10' VERT.

84732

| FED. ROAD DIST. NO. | STATE | FED. AID PROJ. NO. | FISCAL YEAR | SHEET NO. | TOTAL SHEETS |
|---|---|---|---|---|---|
| HAWAII | HAW. | HIC - 01 - 90 | 1991 | 79 | 109 |

FINAL SURVEY — NOTE BOOK — NO. — SURVEYED — PLOTTED — TEMPLATE — AREAS — AREAS CHECKED — BY — DATE

ORIGINAL SURVEY — NOTE BOOK — NO. — SURVEYED — PLOTTED — TEMPLATE — AREAS — AREAS CHECKED — BY — DATE

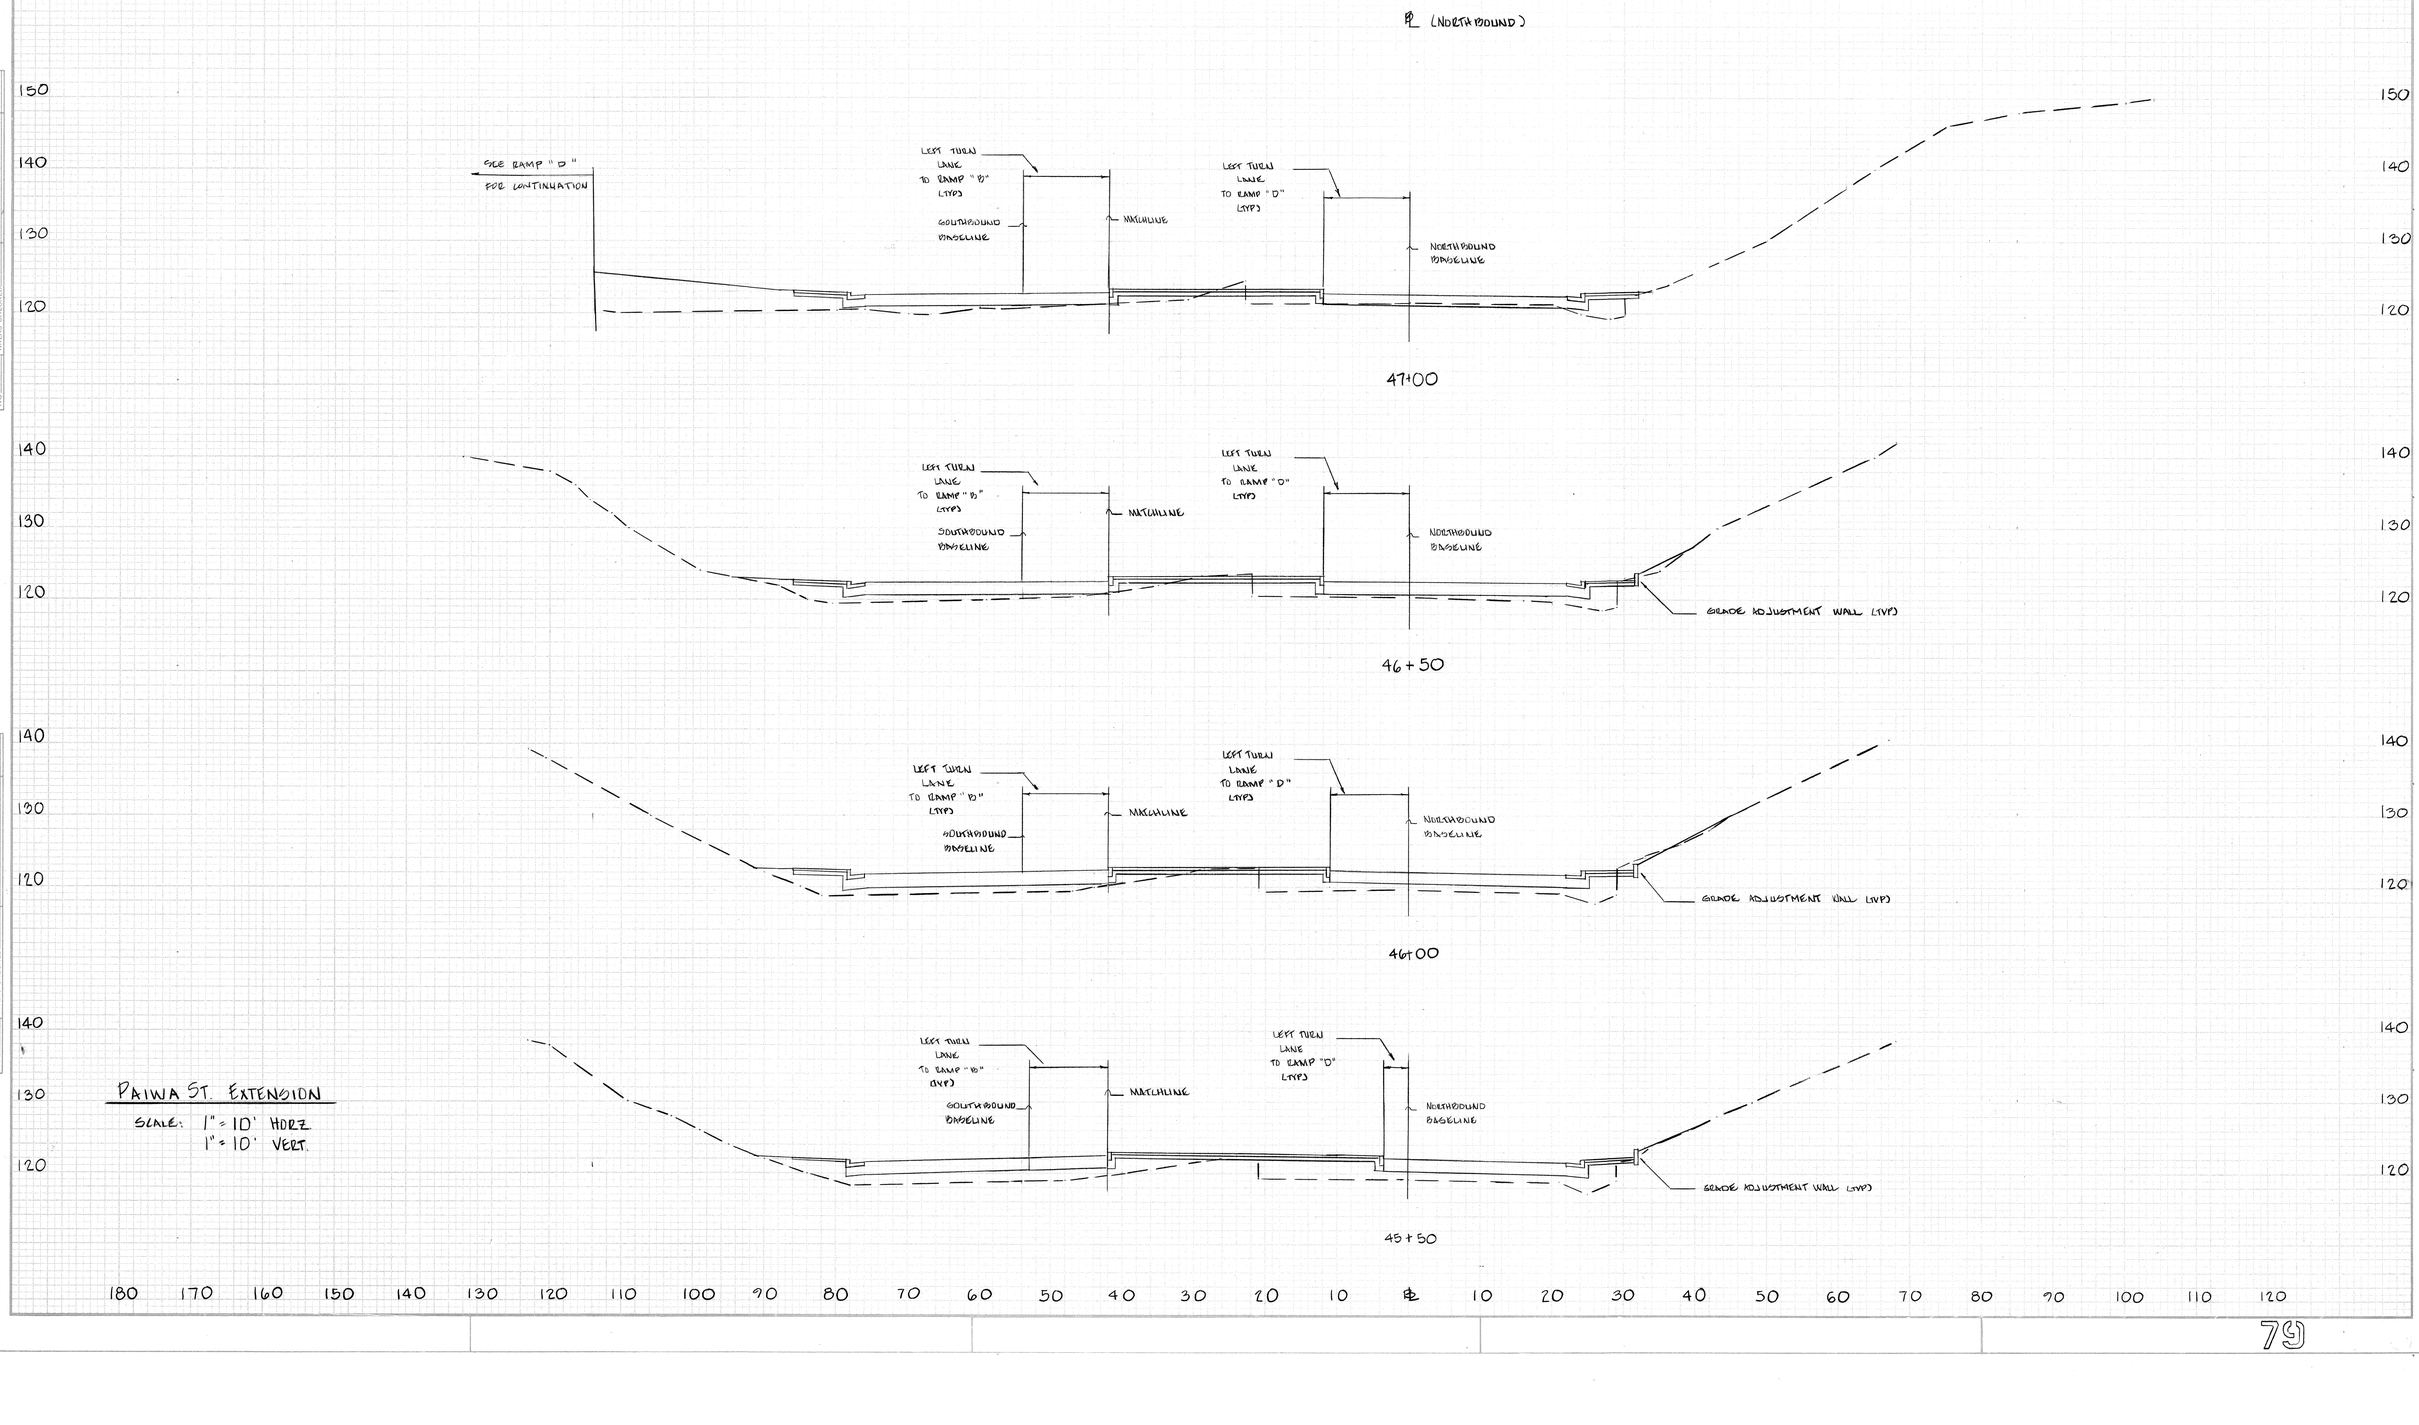


PAIWA ST. EXTENSION


SCALE: 1" = 10' HORZ
1" = 10' VERT.

84732


| FED. ROAD DIST. NO. | STATE | FED. AID PROJ. NO. | FISCAL YEAR | SHEET NO. | TOTAL SHEETS |
|---|---|---|---|---|---|
| HAWAII | HAW. | HIC - 01 - 90 | 1991 | 80 | 109 |

FINAL SURVEY — NOTE BOOK NO. — SURVEYED — PLOTTED — TEMPLATE — AREAS — AREAS CHECKED — BY — DATE


ORIGINAL SURVEY — NOTE BOOK NO. — SURVEYED — PLOTTED — TEMPLATE — AREAS — AREAS CHECKED — BY — DATE

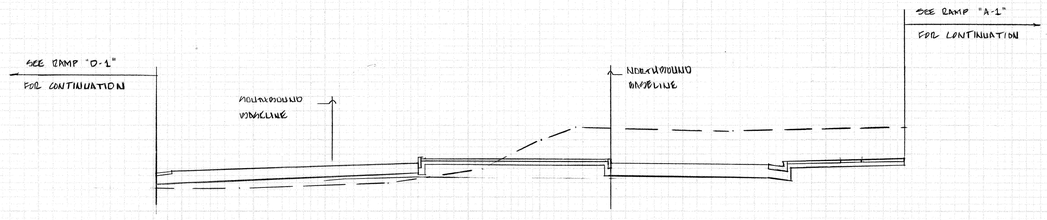



48+71 IC NB ONLY

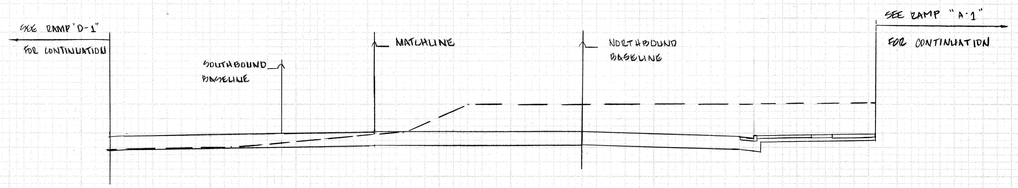


48+50

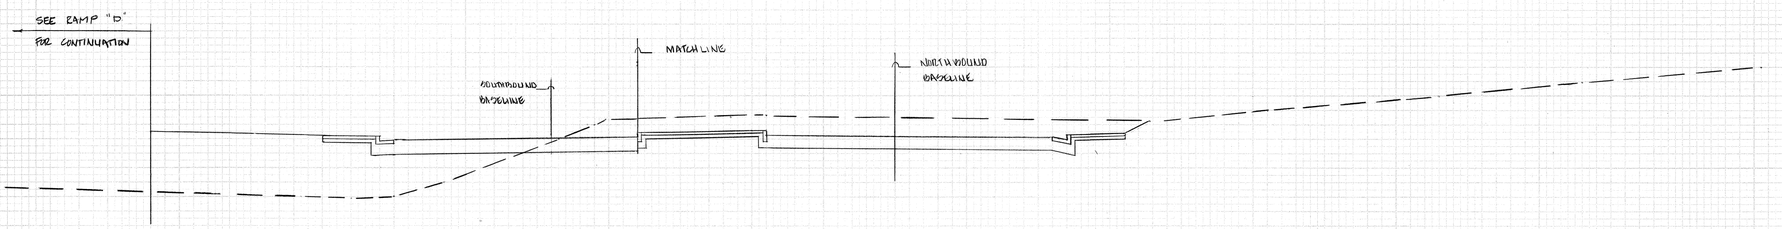


48+00

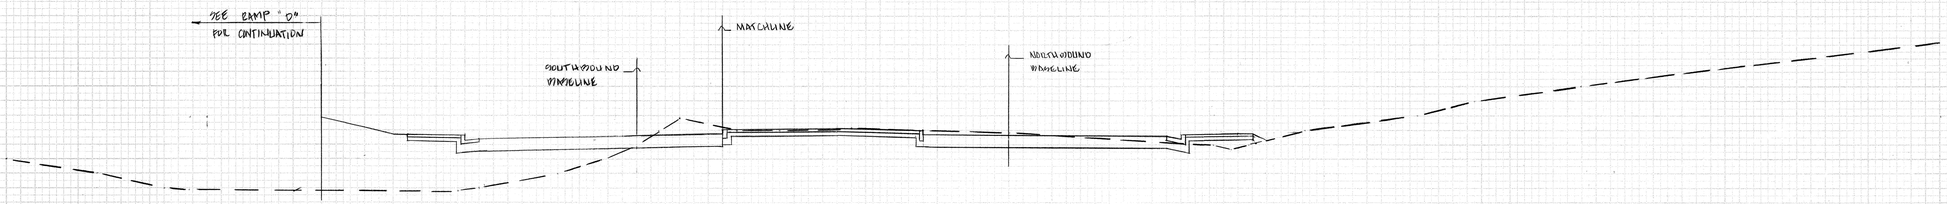


47+50

PAIWA ST. EXTENSION

SCALE: 1" = 10' HORZ.
1" = 10' VERT.

180 170 160 150 140 130 120 110 100 90 80 70 60 50 40 30 20 10 ℄ 10 20 30 40 50 60 70 80 90 100 110 120


(80)

84732

| FED. ROAD DIST. NO. | STATE | FED. AID PROJ. NO. | FISCAL YEAR | SHEET NO. | TOTAL SHEETS |
|---|---|---|---|---|---|
| HAWAII | HAW. | HIC-01-90 | 1991 | 81 | 109 |

FINAL SURVEY — NOTE BOOK ____ ND ____ — SURVEYED ____ PLOTTED ____ TEMPLATE ____ AREAS ____ CROSS CHECKED ____ — BY ____ DATE ____

ORIGINAL SURVEY — NOTE BOOK ____ ND ____ — SURVEYED ____ PLOTTED ____ TEMPLATE ____ AREAS ____ CROSS CHECKED ____ — BY ____ DATE ____

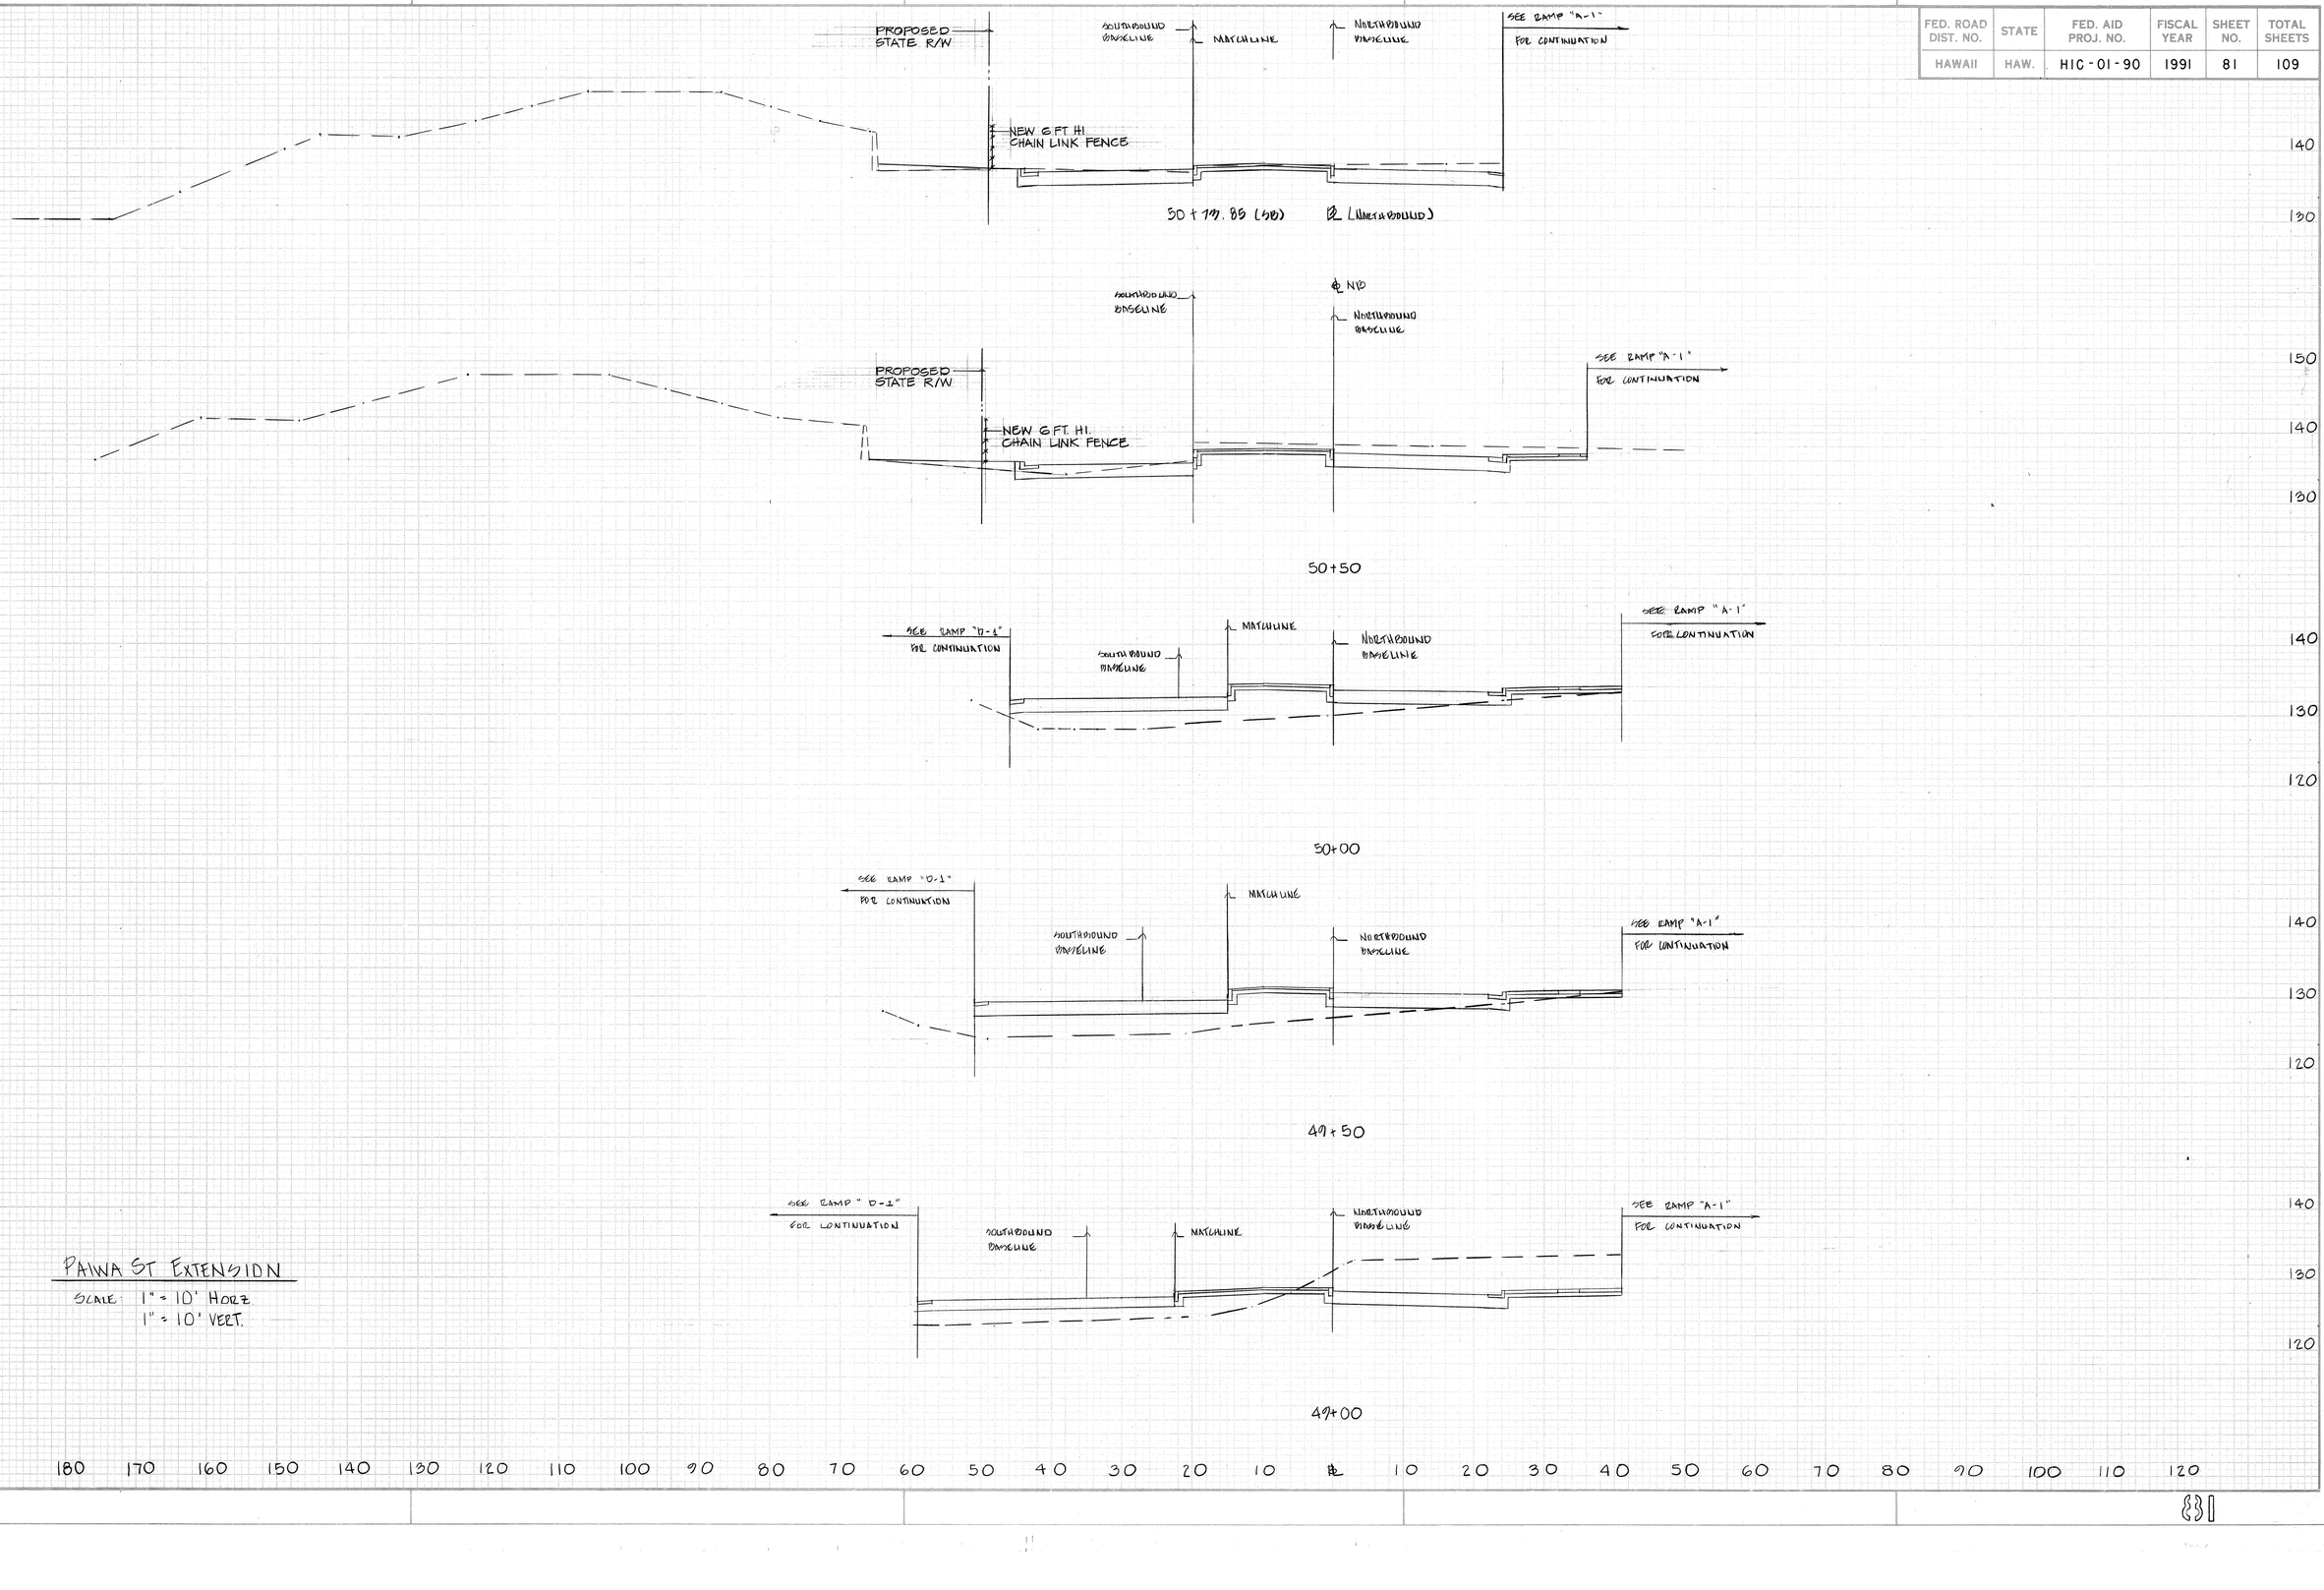


## PAIWA ST EXTENSION


SCALE: 1" = 10' HORZ.
1" = 10' VERT.

84732

| FED. ROAD DIST. NO. | STATE | FED. AID PROJ. NO. | FISCAL YEAR | SHEET NO. | TOTAL SHEETS |
|---|---|---|---|---|---|
| HAWAII | HAW. | HIC-01-90 | 1991 | 82 | 109 |

FINAL SURVEY — SURVEYED, PLOTTED, TEMPLATE, AREAS, CHECKED — NOTE BOOK — NO. — BY — DATE

ORIGINAL SURVEY — SURVEYED, PLOTTED, TEMPLATE, AREAS, CHECKED — NOTE BOOK — NO. — BY — DATE

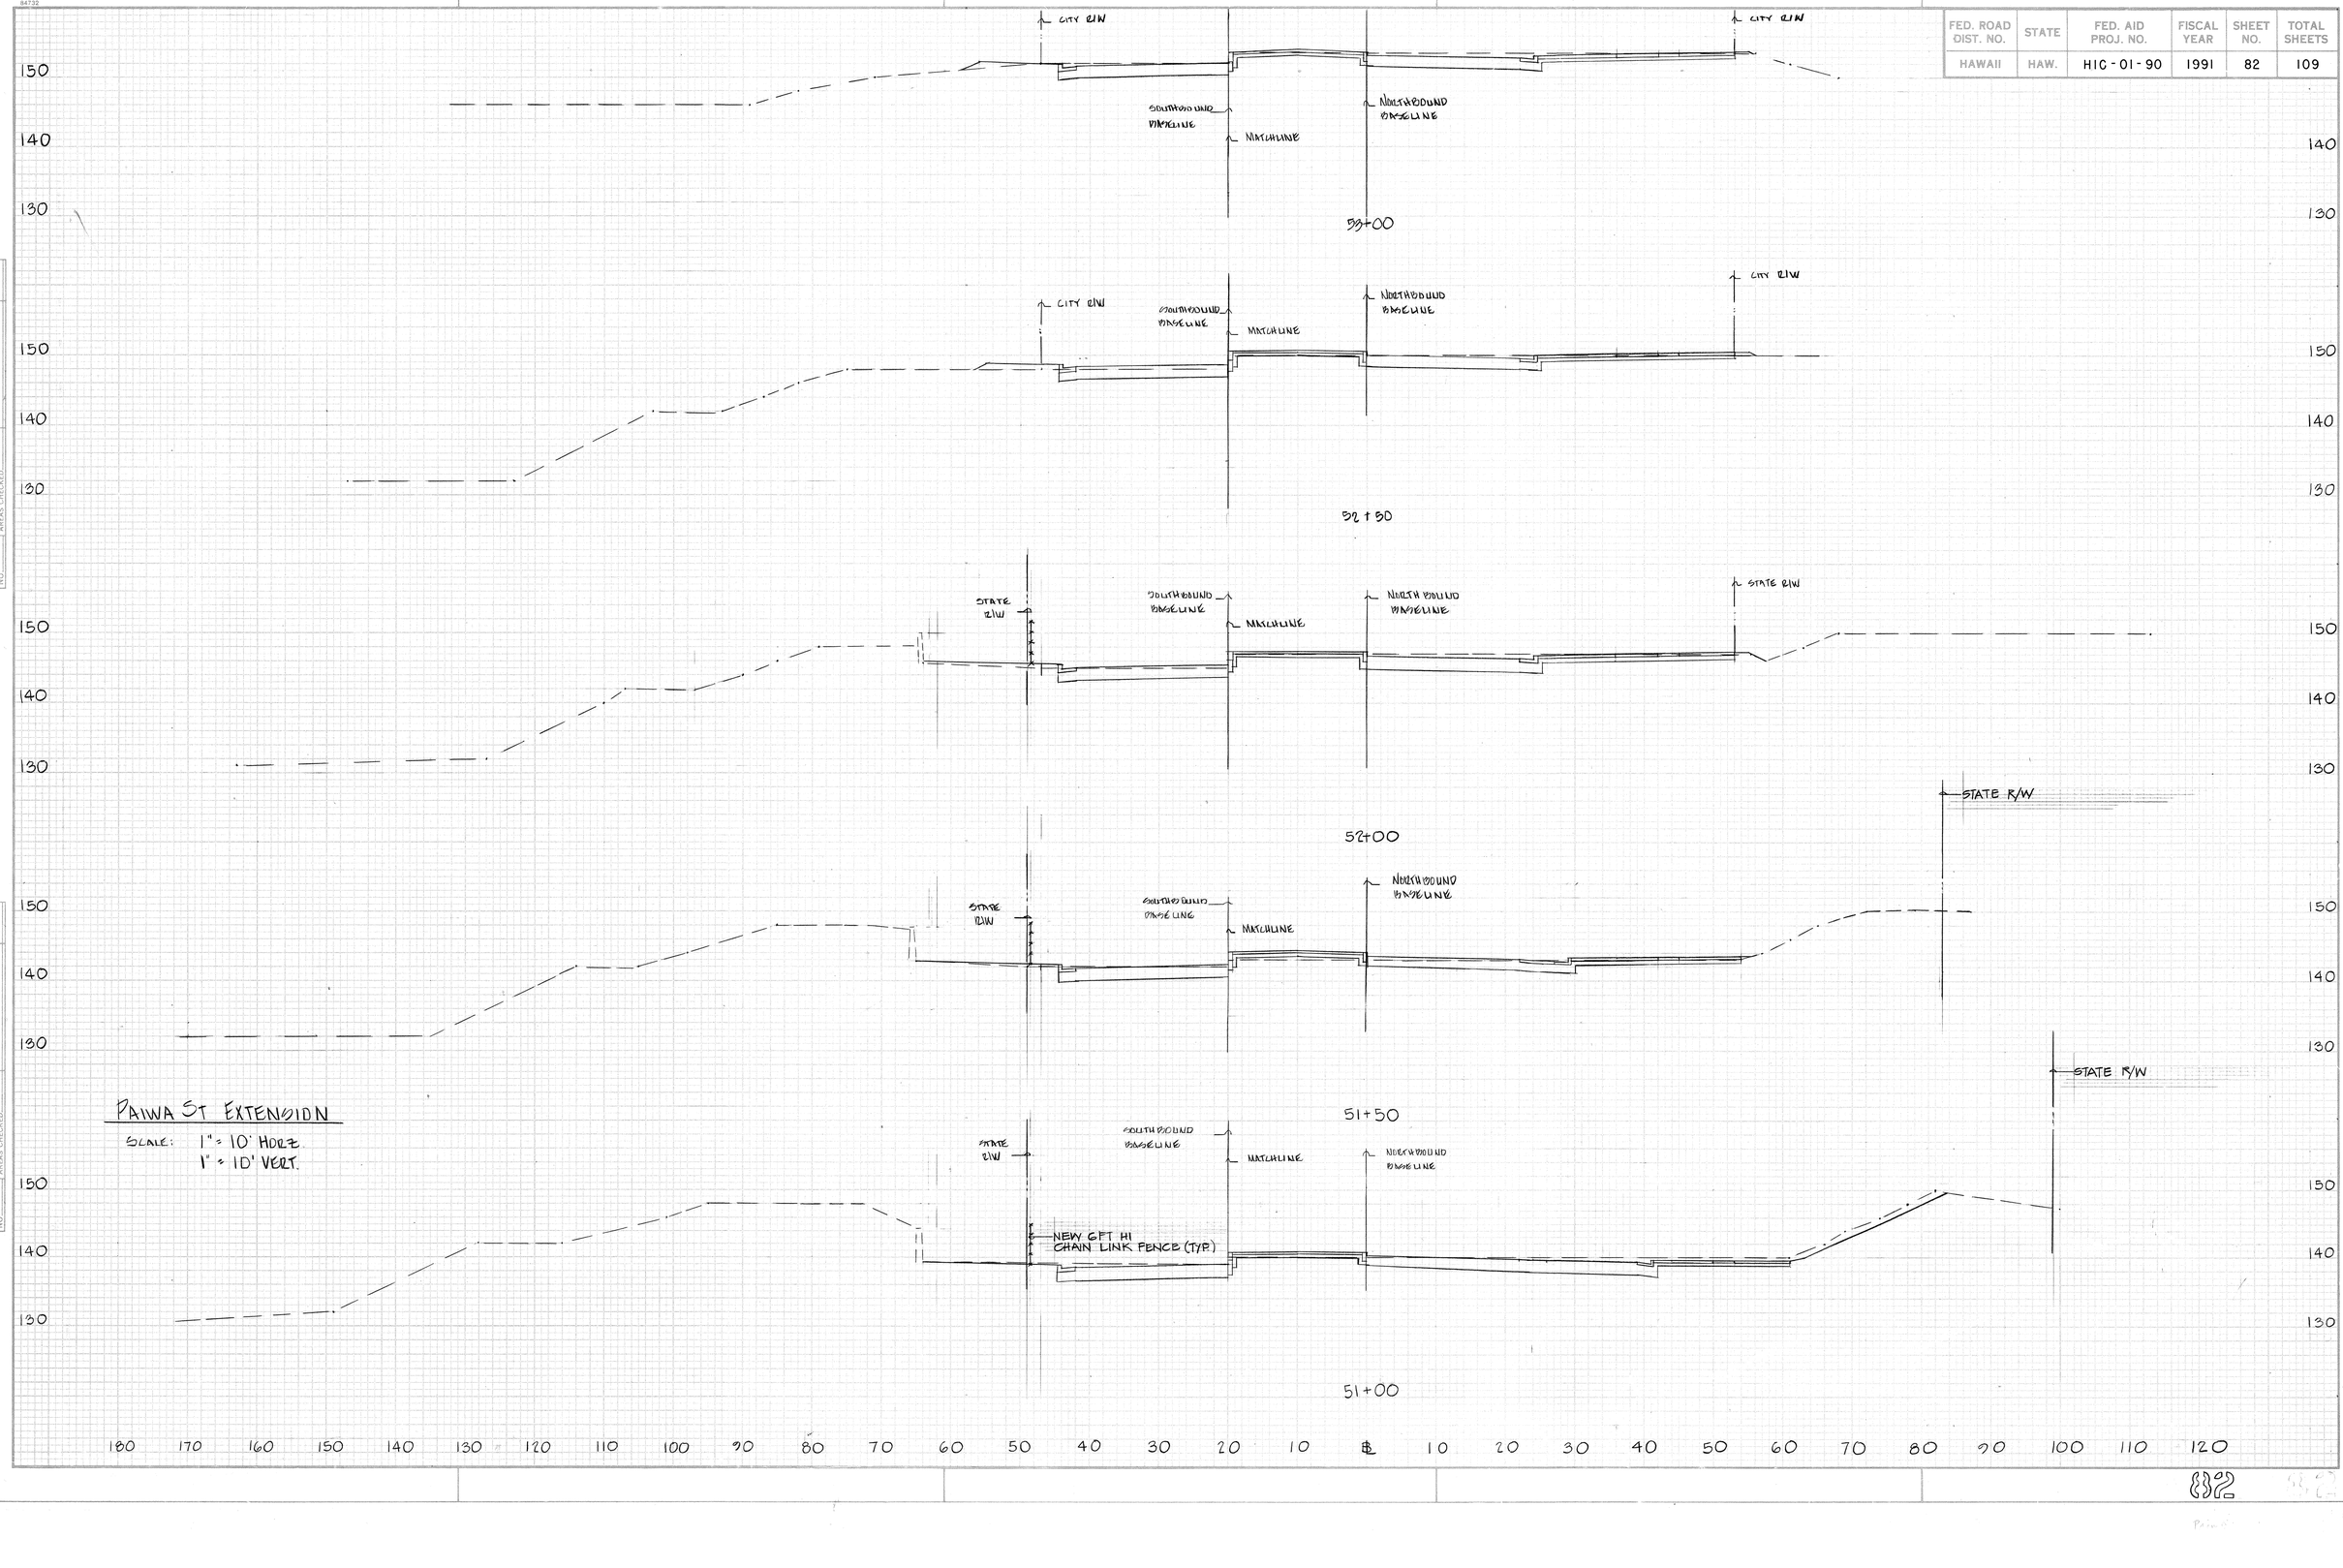


PAIWA ST EXTENSION


SCALE: 1" = 10' HORZ.
1" = 10' VERT.

84732

| FED. ROAD DIST. NO. | STATE | FED. AID PROJ. NO. | FISCAL YEAR | SHEET NO. | TOTAL SHEETS |
|---|---|---|---|---|---|

FINAL SURVEY — NOTE BOOK — NO. — SURVEYED — PLOTTED — TEMPLATE — AREAS CHECKED — BY — DATE

ORIGINAL SURVEY — NOTE BOOK — NO. — SURVEYED — PLOTTED — TEMPLATE — AREAS CHECKED — BY — DATE

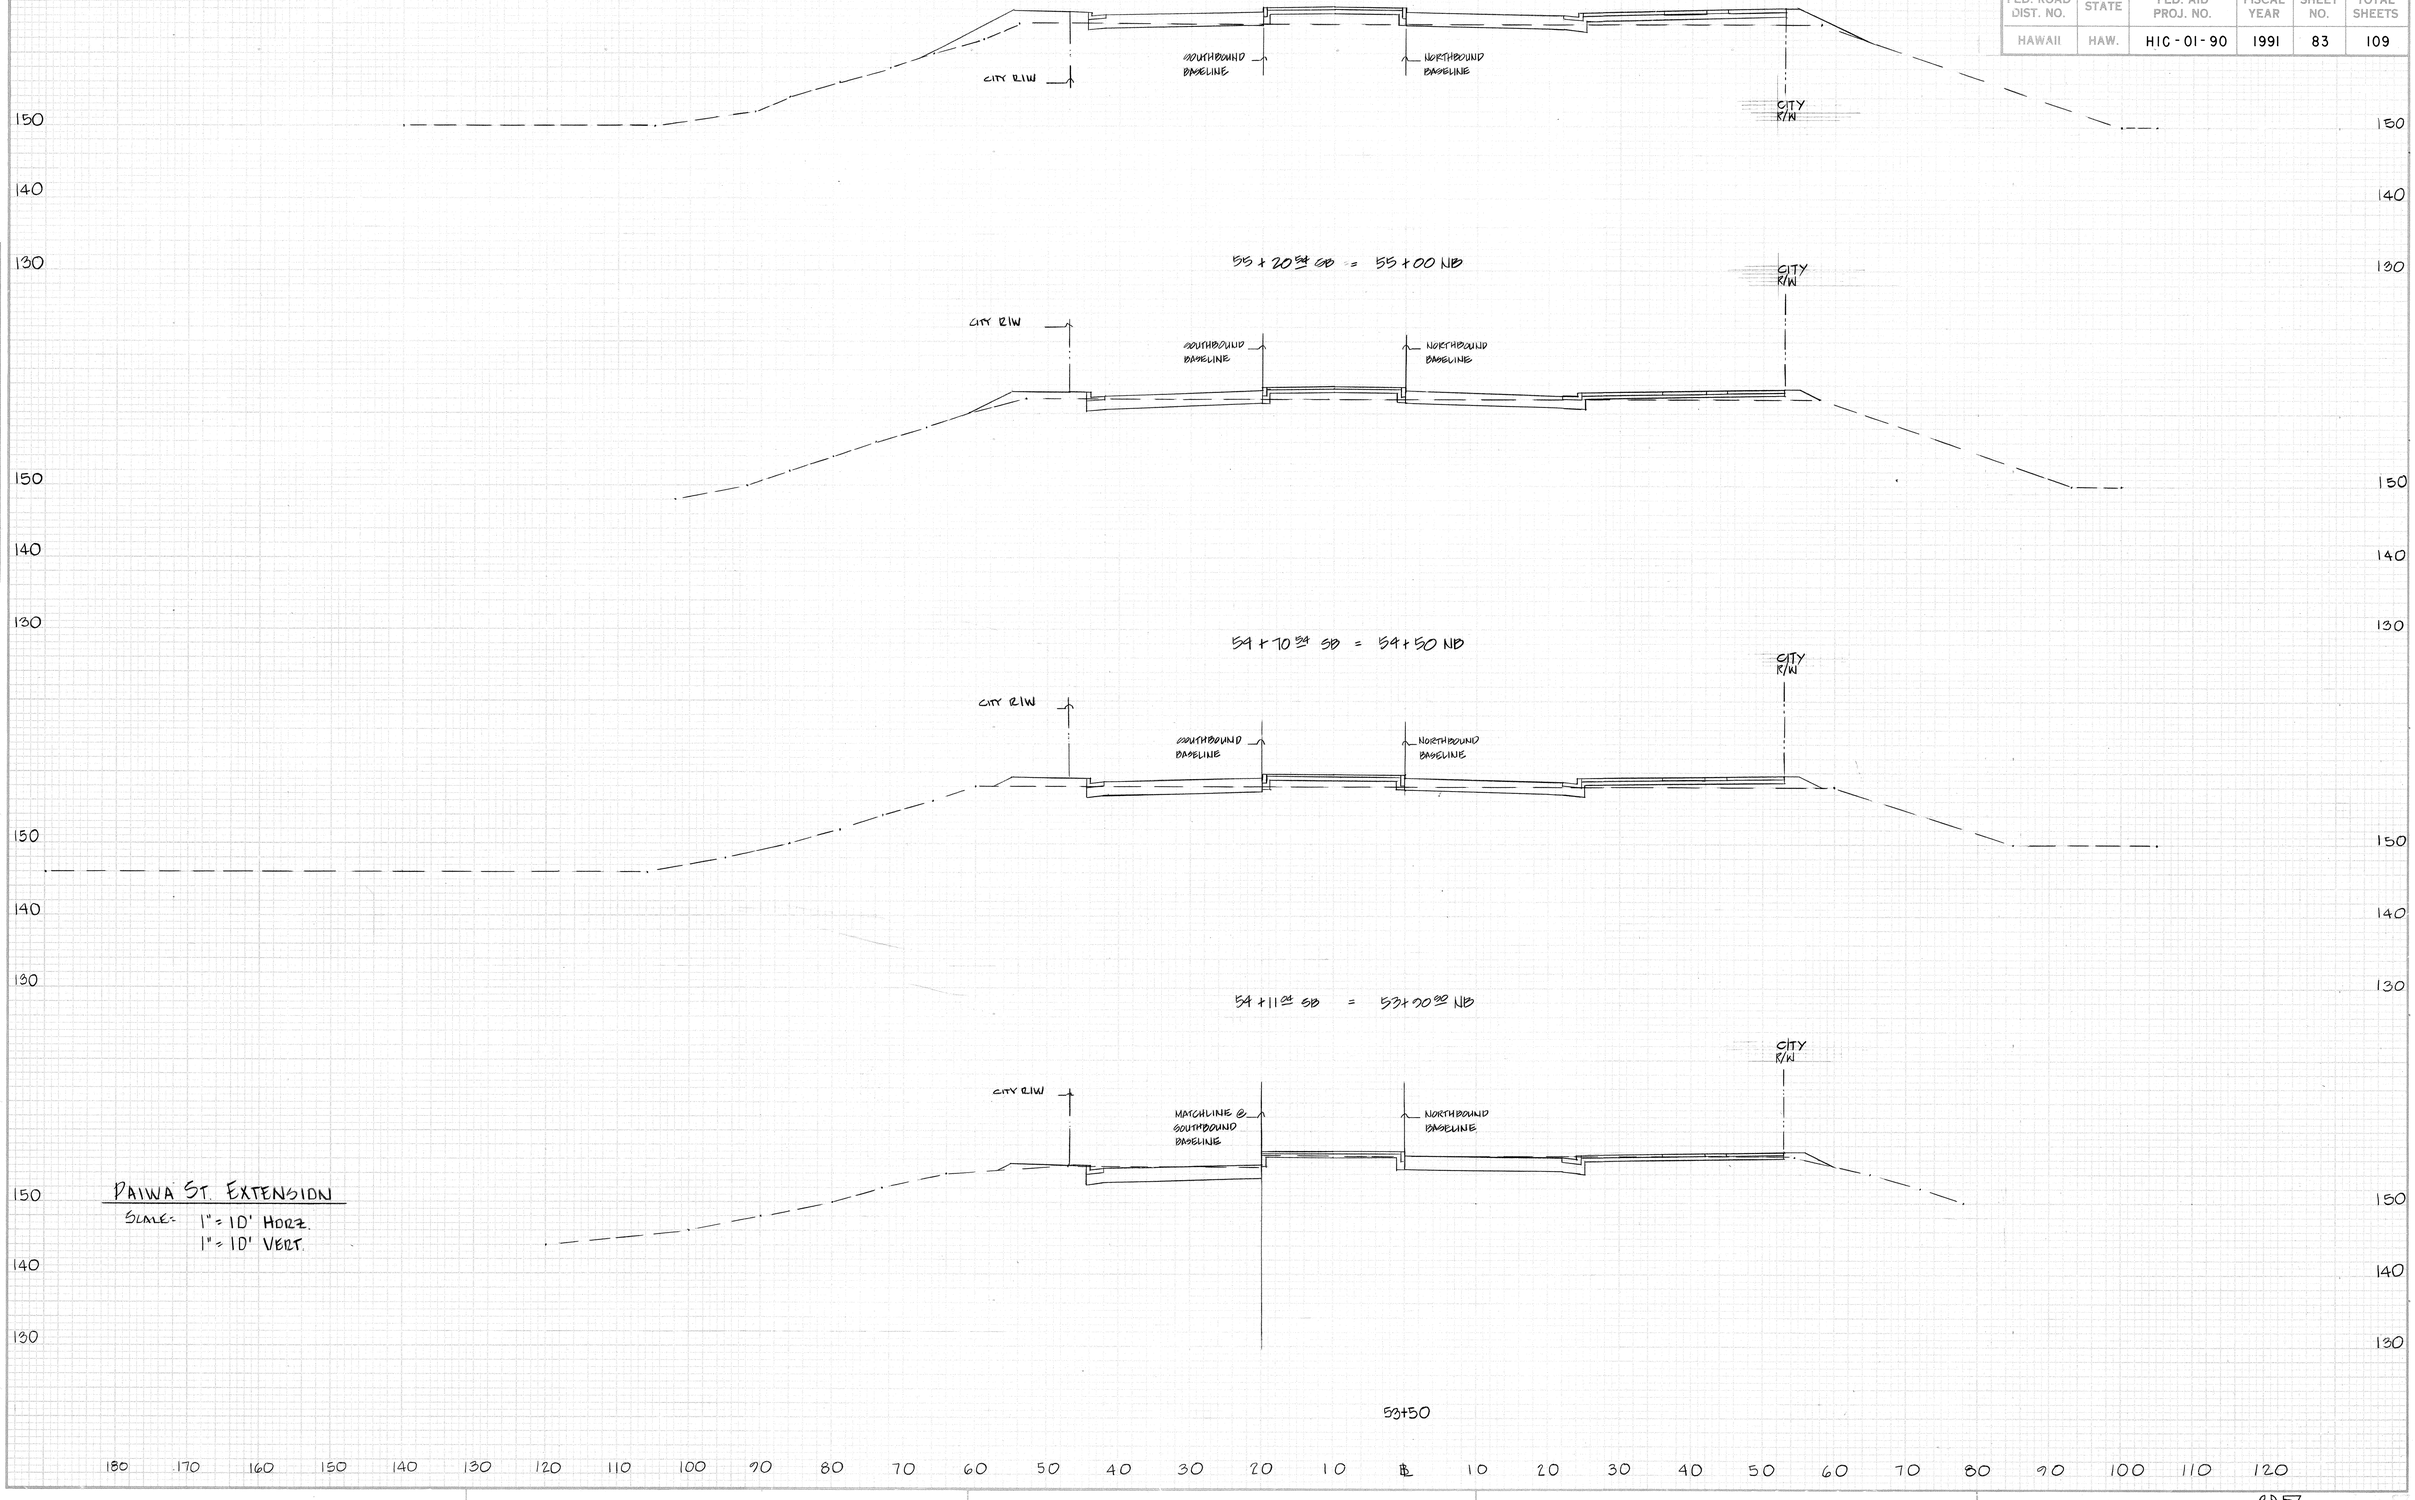


PAIWA ST. EXTENSION


SCALE: 1" = 10' HORZ.
1" = 10' VERT.

84732

| FED. ROAD DIST. NO. | STATE | FED. AID PROJ. NO. | FISCAL YEAR | SHEET NO. | TOTAL SHEETS |
|---|---|---|---|---|---|

FINAL SURVEY — NOTE BOOK — NO. — SURVEYED — PLOTTED — TEMPLATE — AREAS — CROSS CHECKED — BY — DATE

ORIGINAL SURVEY — NOTE BOOK — NO. — SURVEYED — PLOTTED — TEMPLATE — AREAS — CROSS CHECKED — BY — DATE

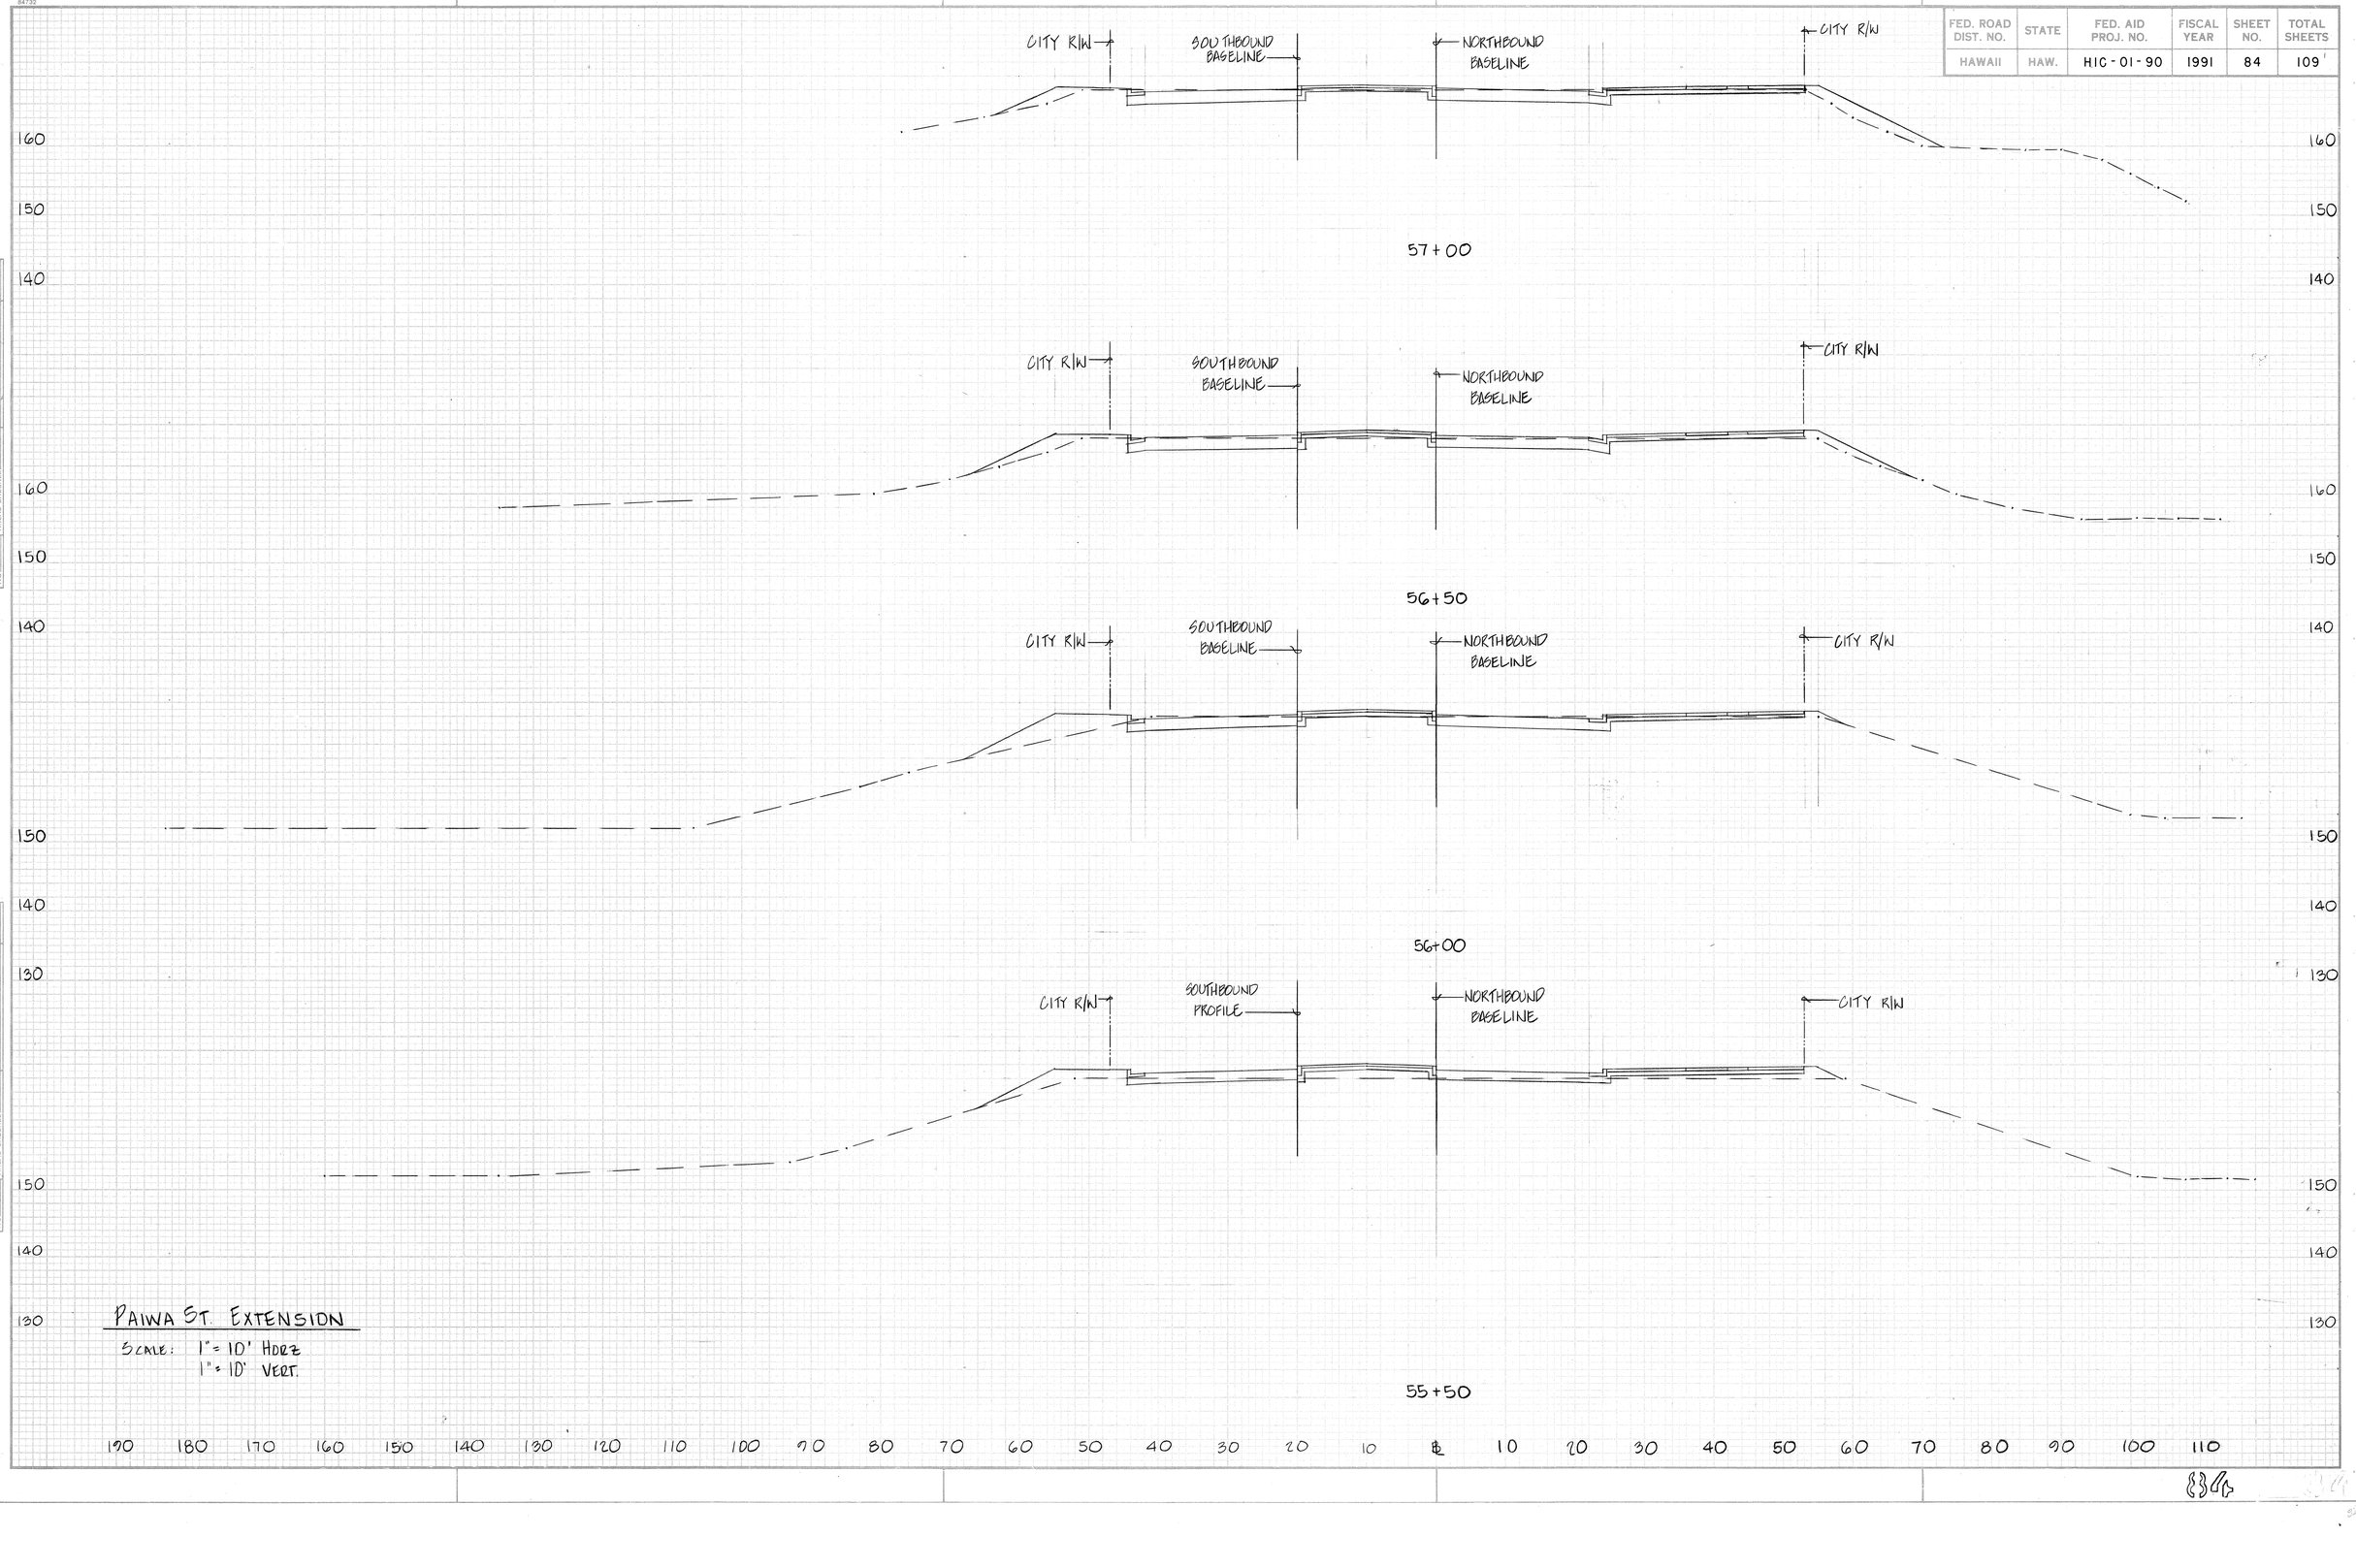


PAIWA ST. EXTENSION


SCALE: 1" = 10' HORZ
1" = 10' VERT.

84

84732

| FED. ROAD DIST. NO. | STATE | FED. AID PROJ. NO. | FISCAL YEAR | SHEET NO. | TOTAL SHEETS |
|---|---|---|---|---|---|

FINAL SURVEY
NOTE BOOK
NO.
SURVEYED
PLOTTED
TEMPLATE
AREAS
AREAS CHECKED
BY
DATE

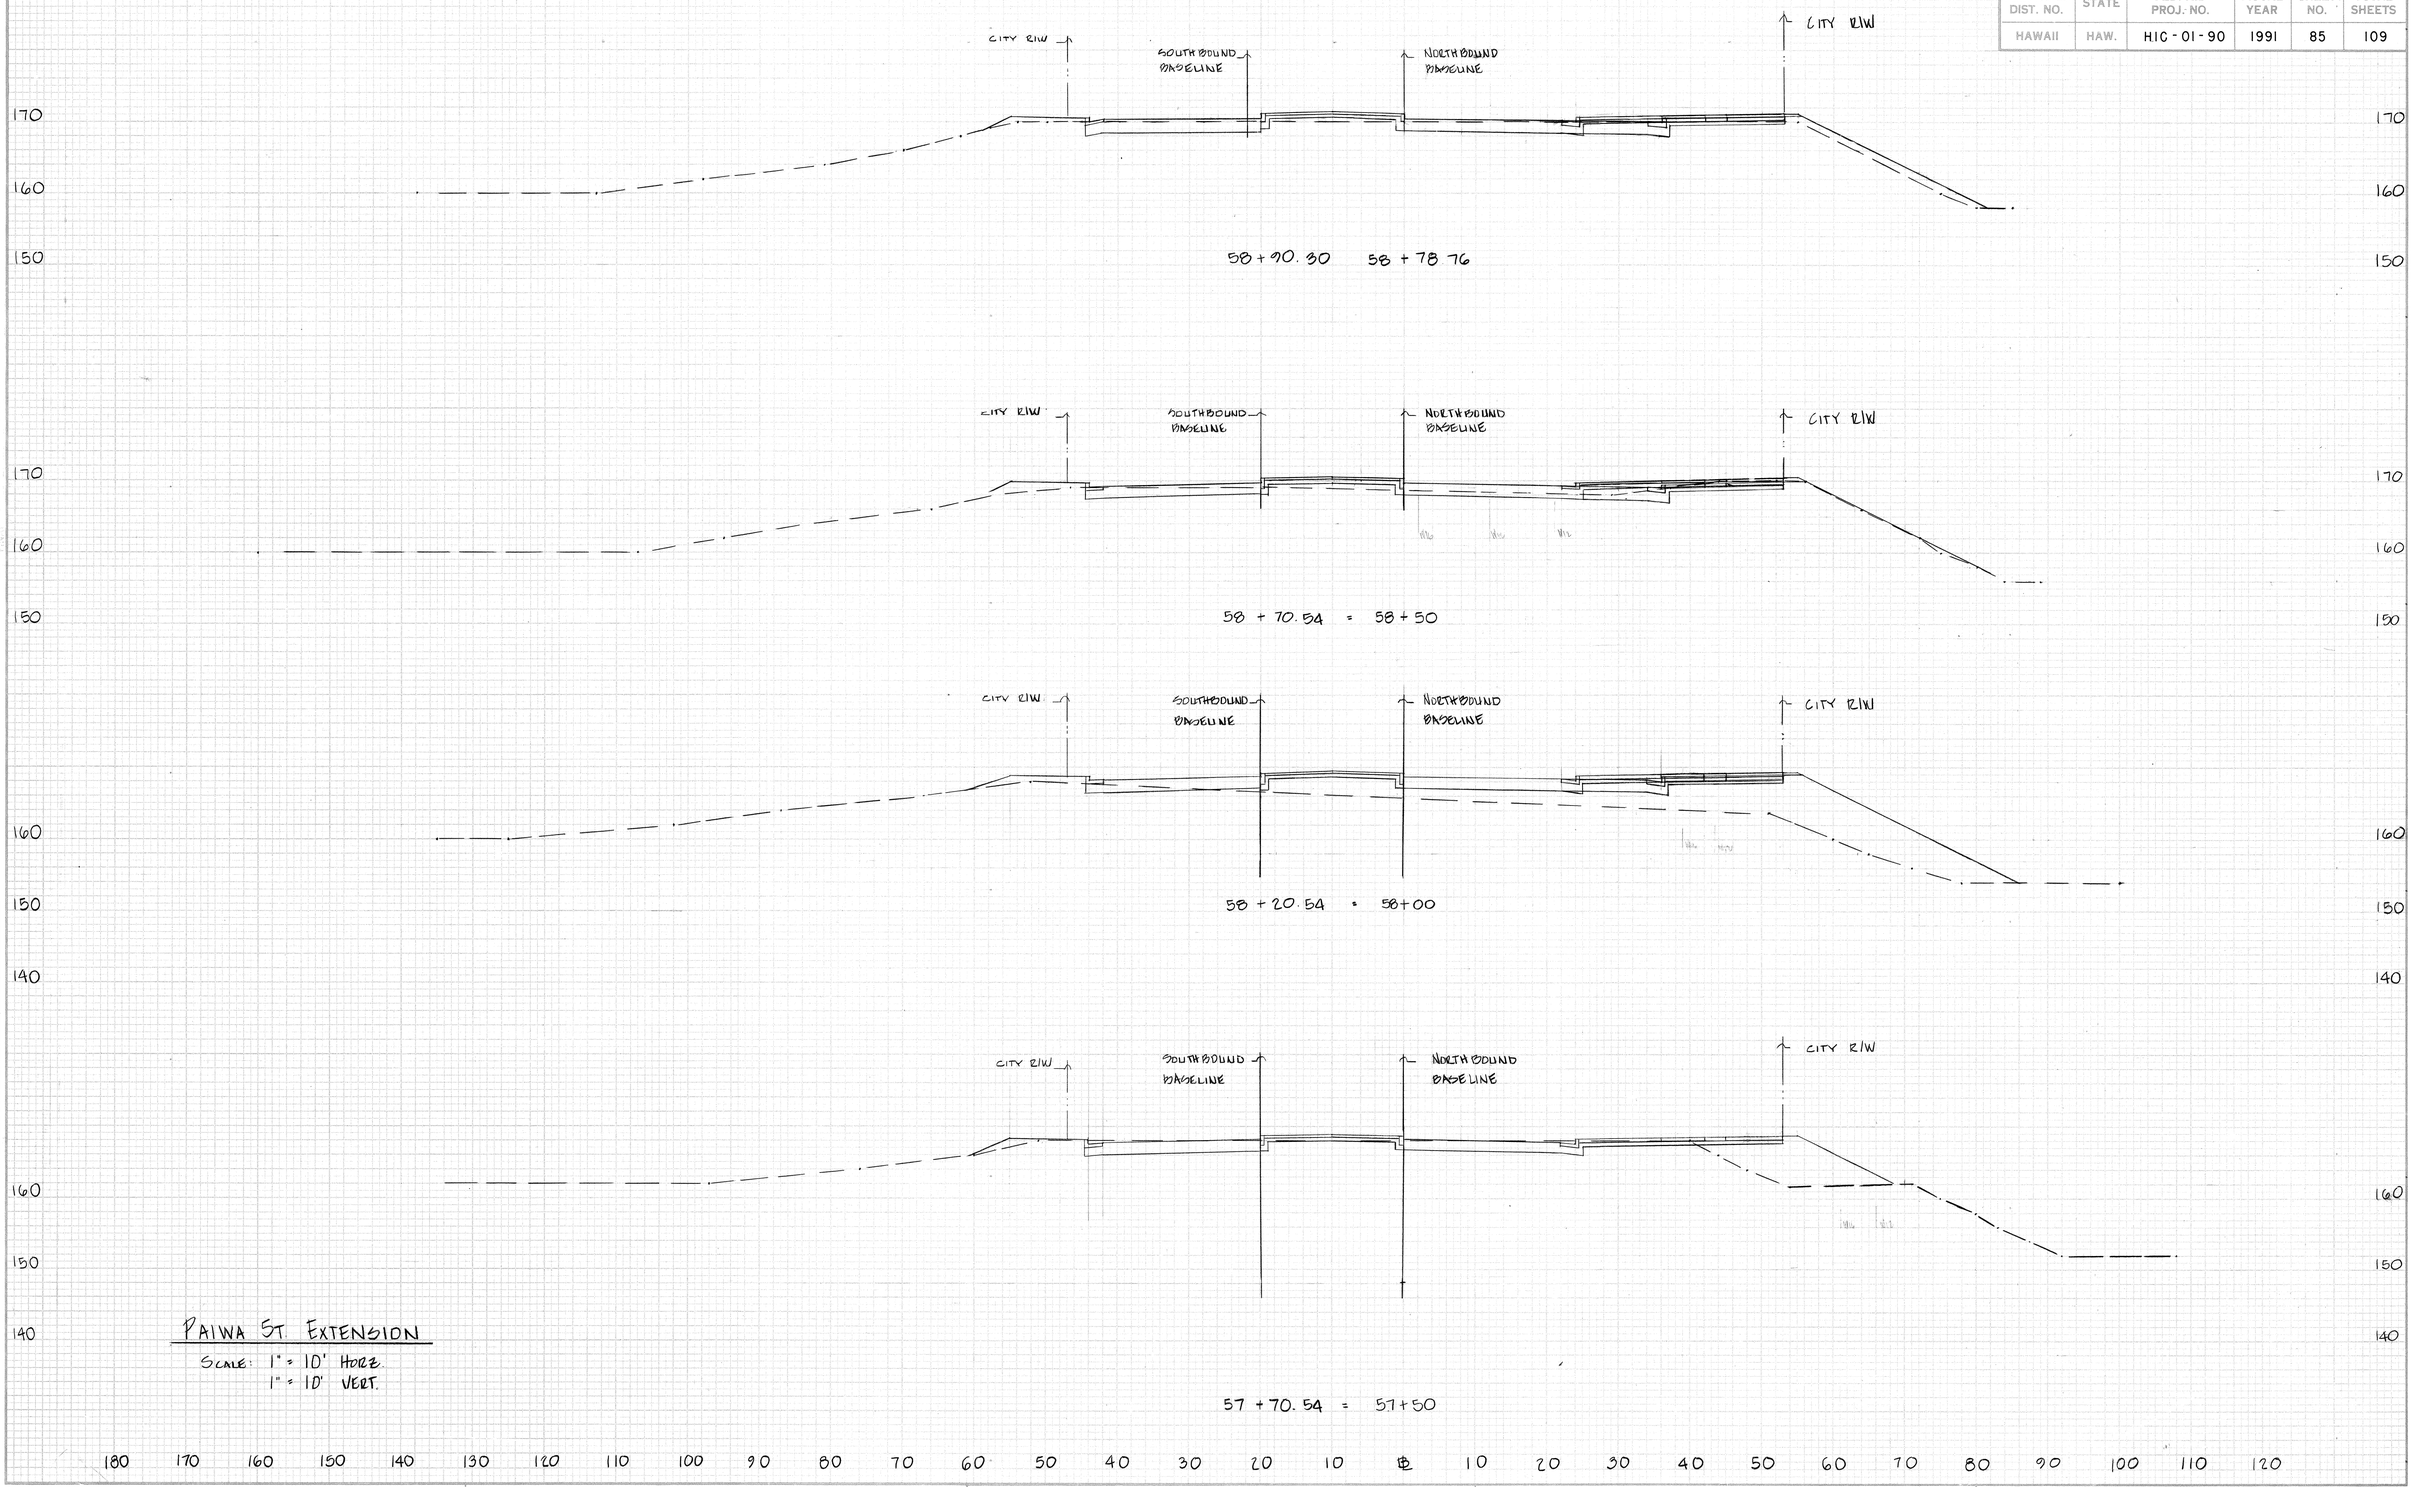


ORIGINAL SURVEY
NOTE BOOK
NO.
SURVEYED
PLOTTED
TEMPLATE
AREAS
AREAS CHECKED
BY
DATE

## PAIWA ST. EXTENSION


SCALE: 1" = 10' HORZ.
1" = 10' VERT.


84732

| FED. ROAD DIST. NO. | STATE | FED. AID PROJ. NO. | FISCAL YEAR | SHEET NO. | TOTAL SHEETS |
|---|---|---|---|---|---|

FINAL SURVEY — NOTE BOOK — NO. — BY — DATE — SURVEYED — PLOTTED — TEMPLATE — AREAS — AREAS CHECKED

ORIGINAL SURVEY — NOTE BOOK — NO. — BY — DATE — SURVEYED — PLOTTED — TEMPLATE — AREAS — AREAS CHECKED

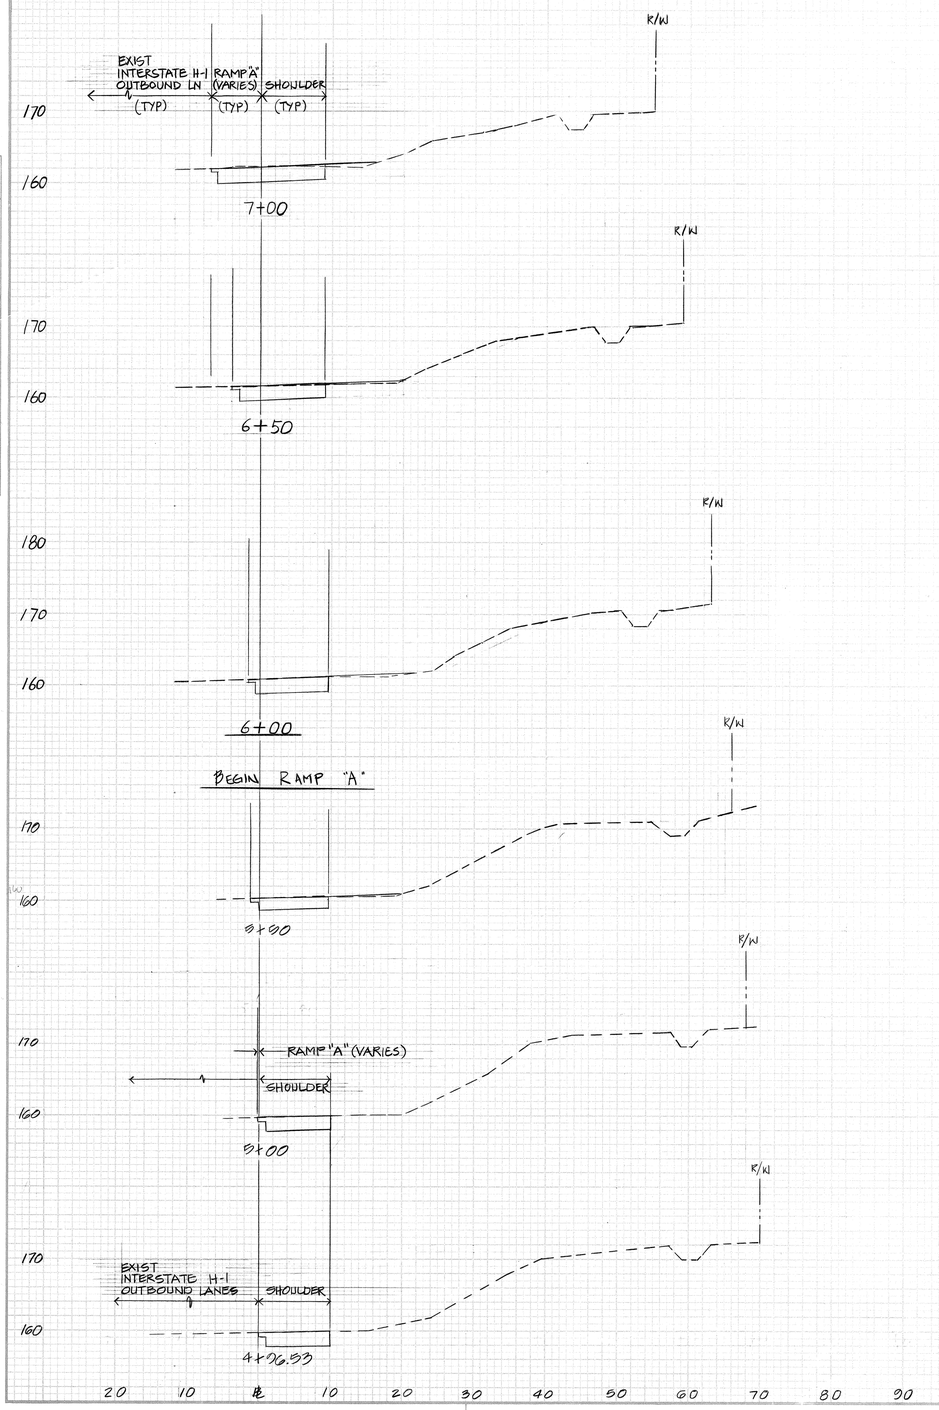

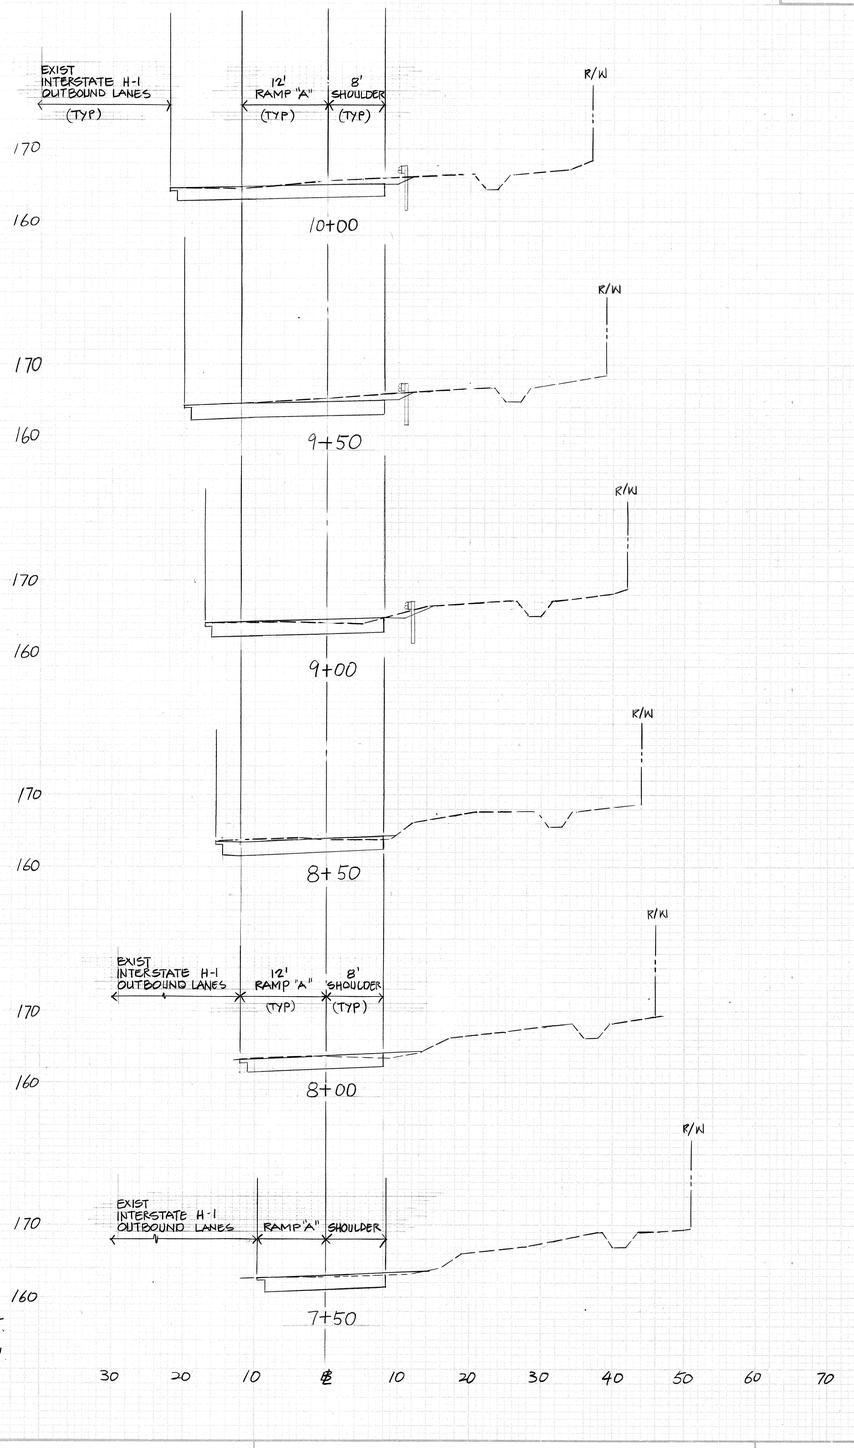




RAMP "A"
SCALE: 1": 10' VERT.
1": 10' HORI.

84732

| FED. ROAD DIST. NO. | STATE | FED. AID PROJ. NO. | FISCAL YEAR | SHEET NO. | TOTAL SHEETS |
|---|---|---|---|---|---|
| HAWAII | HAW. | HIC-01-90 | 1991 | 87 | 109 |
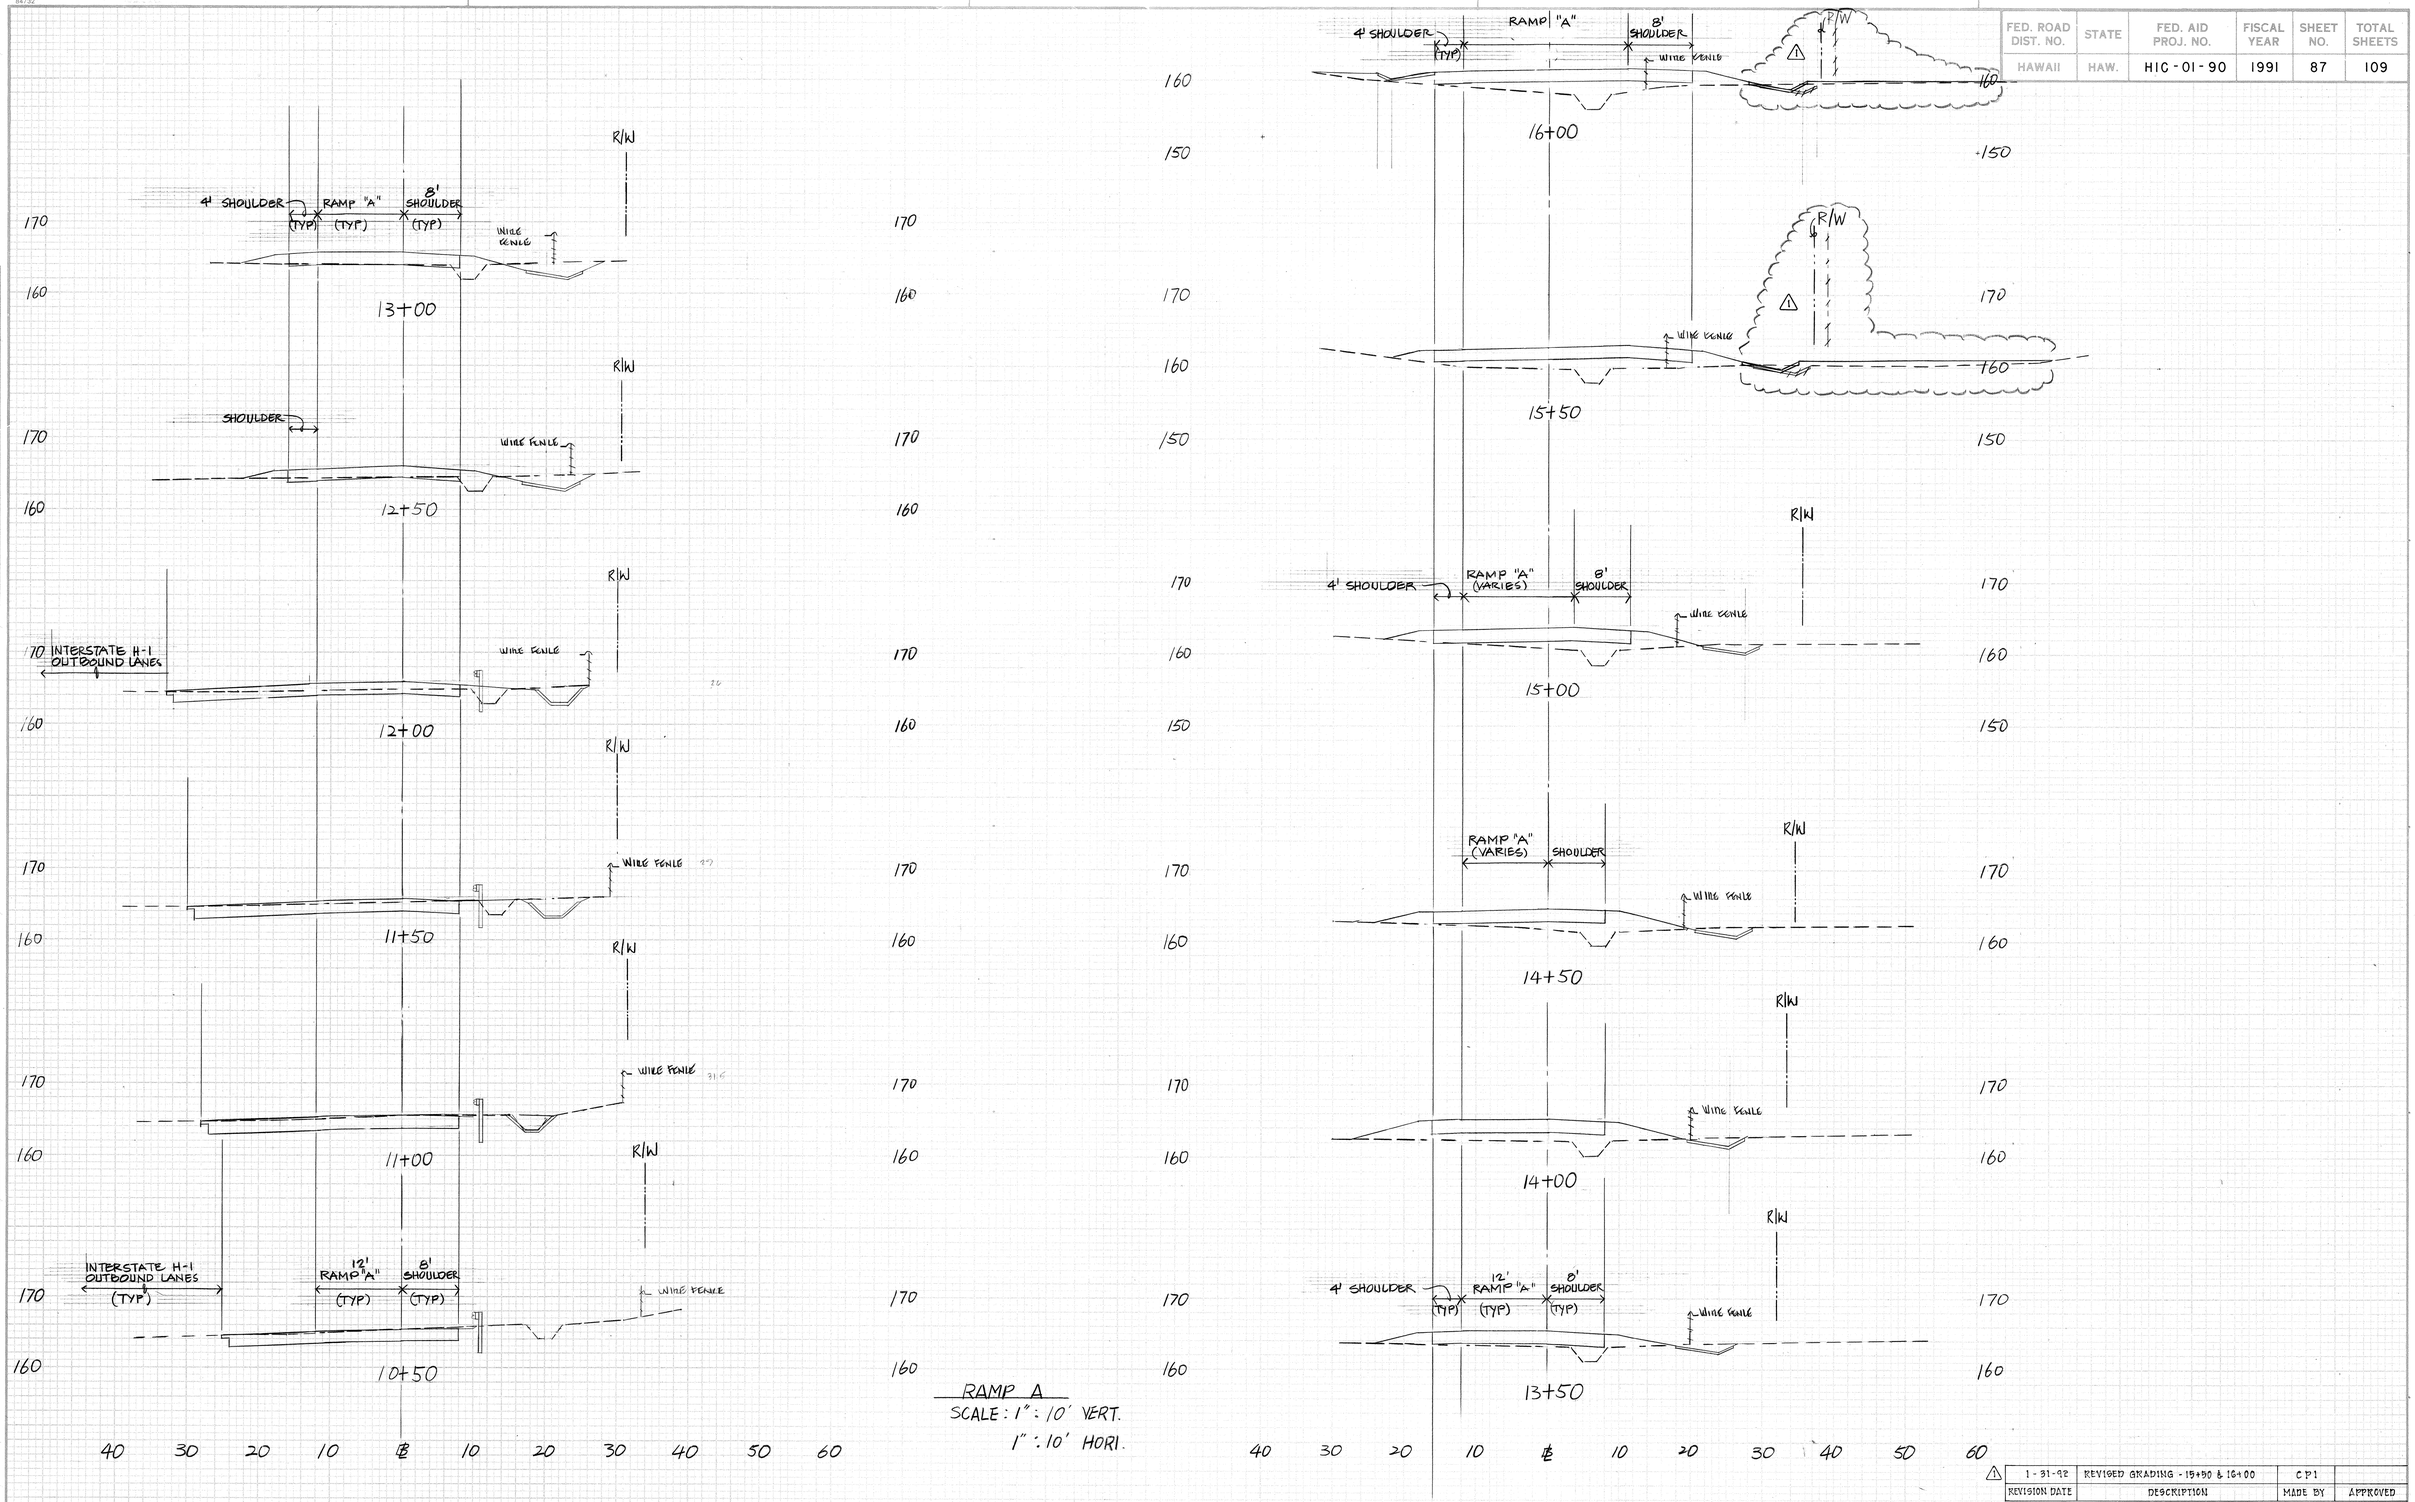
| FINAL SURVEY | ORIGINAL SURVEY |
|---|---|
| NOTE BOOK | NOTE BOOK |
| NO. | NO. |
| SURVEYED | SURVEYED |
| PLOTTED | PLOTTED |
| TEMPLATE | TEMPLATE |
| AREAS | AREAS |
| AREAS CHECKED | AREAS CHECKED |
| BY | BY |
| DATE | DATE |




RAMP A

SCALE: 1" : 10' VERT.

1" : 10' HORI.


| REVISION DATE | DESCRIPTION | MADE BY | APPROVED |
|---|---|---|---|
| 1-31-92 | REVISED GRADING - 15+50 & 16+00 | CP1 | |


84732

| FED. ROAD DIST. NO. | STATE | FED. AID PROJ. NO. | FISCAL YEAR | SHEET NO. | TOTAL SHEETS |
|---|---|---|---|---|---|

FINAL SURVEY — NOTE BOOK — NO. — BY — DATE — SURVEYED — PLOTTED — TEMPLATE — AREAS — AREAS CHECKED

ORIGINAL SURVEY — NOTE BOOK — NO. — BY — DATE — SURVEYED — PLOTTED — TEMPLATE — AREAS — AREAS CHECKED

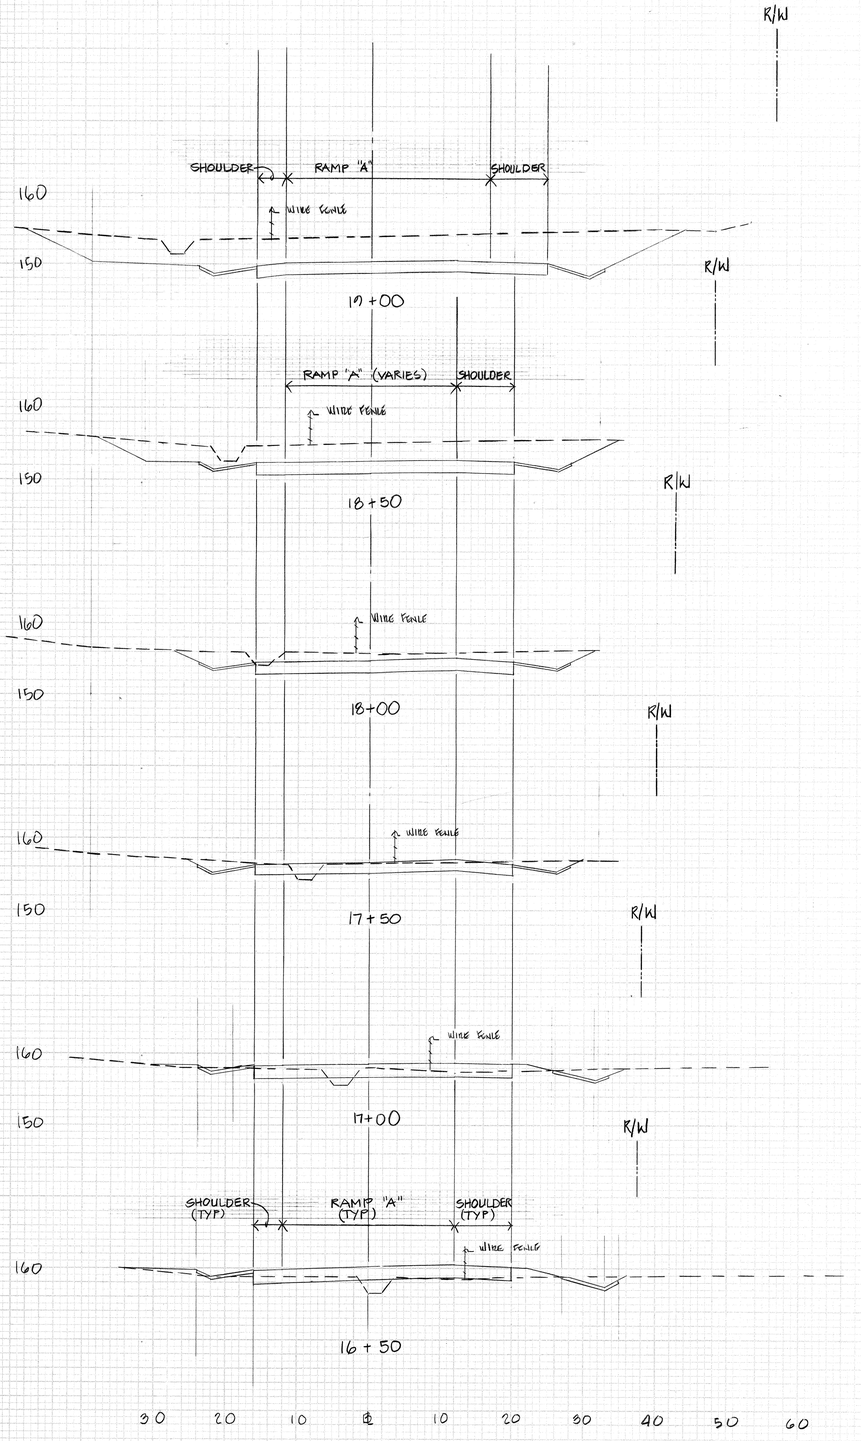

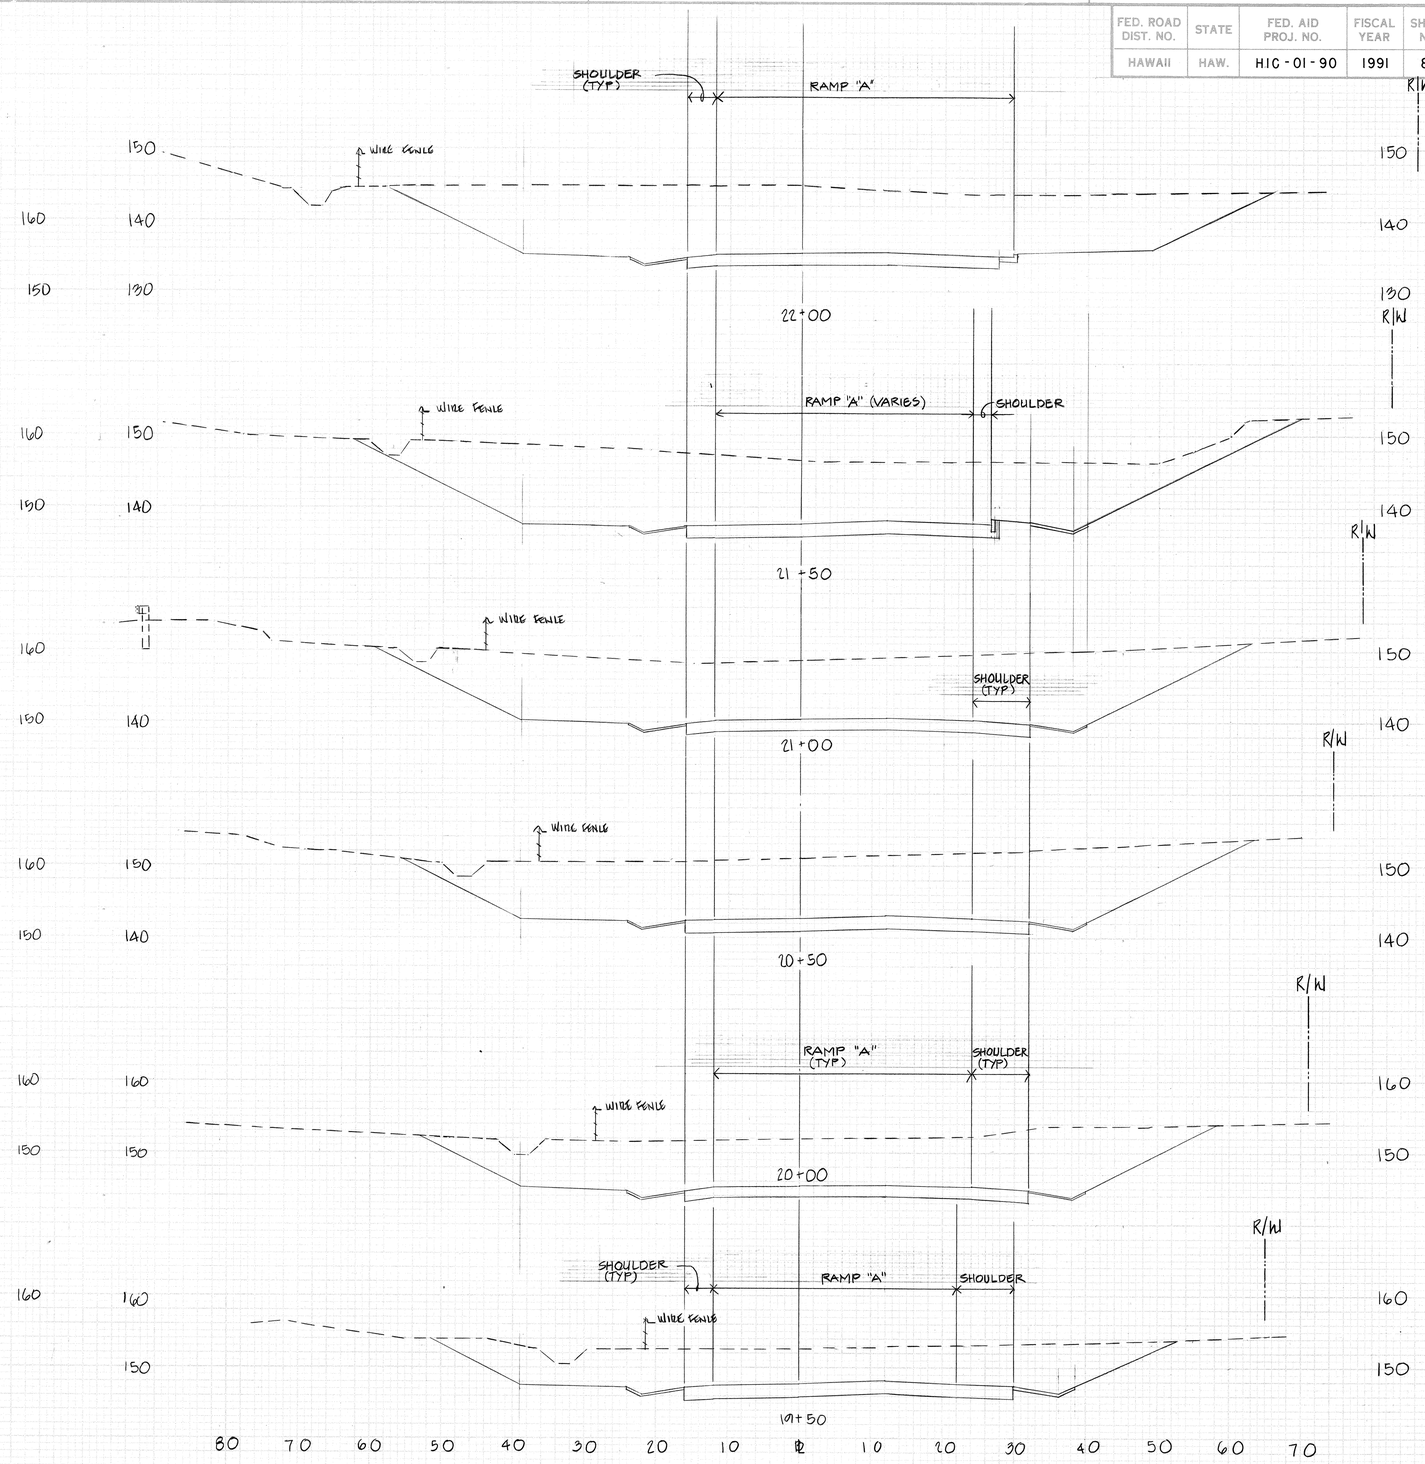84732

| FED. ROAD DIST. NO. | STATE | FED. AID PROJ. NO. | FISCAL YEAR | SHEET NO. | TOTAL SHEETS |
|---|---|---|---|---|---|
| HAWAII | HAW. | HIG-01-90 | 1991 | 89 | 109 |

FINAL SURVEY — NOTE BOOK — NO. — SURVEYED — PLOTTED — TEMPLATE — AREAS — AREAS CHECKED — BY — DATE


ORIGINAL SURVEY — NOTE BOOK — NO. — SURVEYED — PLOTTED — TEMPLATE — AREAS — AREAS CHECKED — BY — DATE

84732

| FED. ROAD DIST. NO. | STATE | FED. AID PROJ. NO. | FISCAL YEAR | SHEET NO. | TOTAL SHEETS |
|---|---|---|---|---|---|
| HAWAII | HAW. | HIC-01-90 | 1991 | 90 | 109 |

FINAL SURVEY — NOTE BOOK — NO. — SURVEYED — PLOTTED — TEMPLATE — AREAS — AREAS CHECKED — BY — DATE

ORIGINAL SURVEY — NOTE BOOK — NO. — SURVEYED — PLOTTED — TEMPLATE — AREAS — AREAS CHECKED — BY — DATE

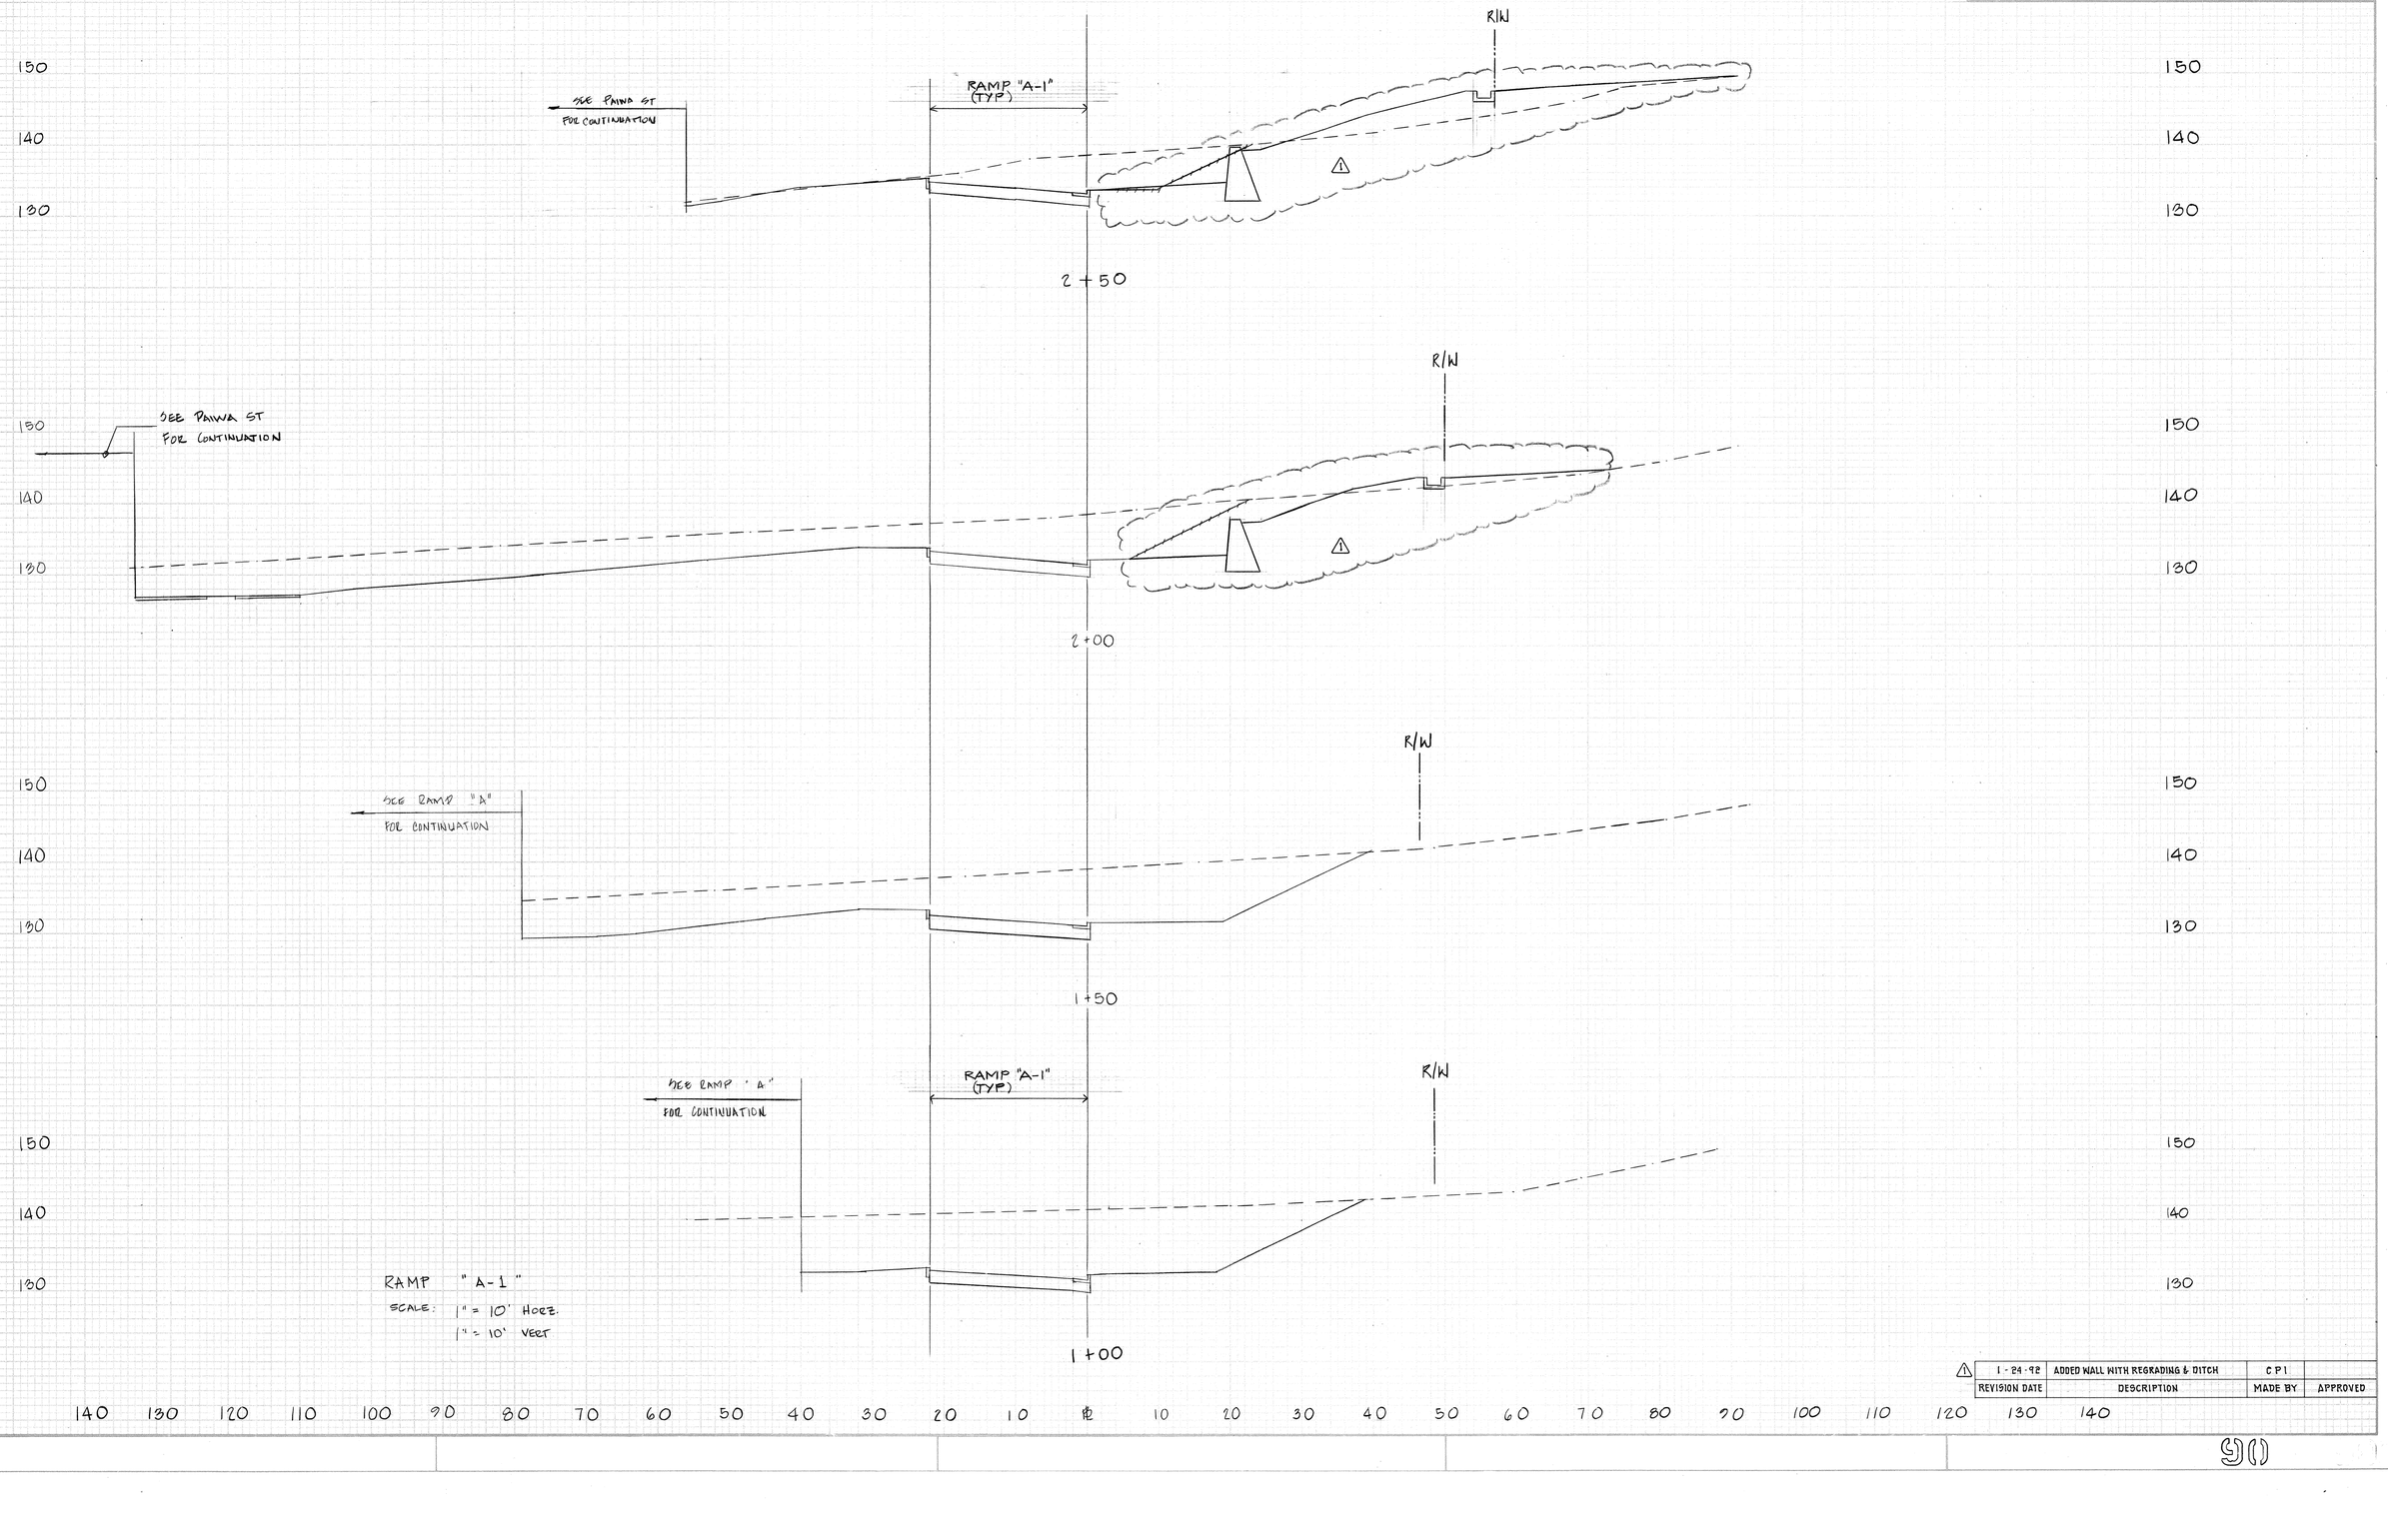


| ⚠ | 1-24-92 | ADDED WALL WITH REGRADING & DITCH | CPI | |
|---|---|---|---|---|
| | REVISION DATE | DESCRIPTION | MADE BY | APPROVED |


90

84732

| FED. ROAD DIST. NO. | STATE | FED. AID PROJ. NO. | FISCAL YEAR | SHEET NO. | TOTAL SHEETS |
|---|---|---|---|---|---|
| HAWAII | HAW. | HIC-01-90 | 1991 | 91 | 109 |

| FINAL SURVEY | DATE | BY |
|---|---|---|
| SURVEYED | | |
| PLOTTED | | |
| TEMPLATE | | |
| AREAS | | |
| NOTE BOOK | | |
| NO. | AREAS CHECKED | |

| ORIGINAL SURVEY | DATE | BY |
|---|---|---|
| SURVEYED | | |
| PLOTTED | | |
| TEMPLATE | | |
| AREAS | | |
| NOTE BOOK | | |
| NO. | AREAS CHECKED | |

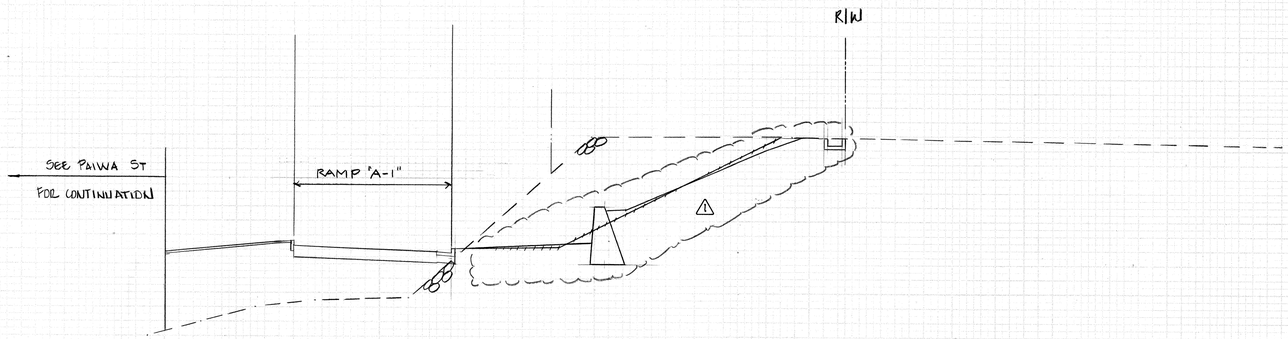



RAMP "A-1"


SCALE: 1" = 10' HORZ
1" = 10' VERT

120 110 100 90 80 70 60 50 40 30 20 10 ℄ 10 20 30 40 50 60 70 80 90 100 110 120

| ⚠ | 1-84-92 | ADDED WALL WITH REGRADING & DITCH | CP1 | |
|---|---|---|---|---|
| | REVISION DATE | DESCRIPTION | MADE BY | APPROVED |

| FED. ROAD DIST. NO. | STATE | FED. AID PROJ. NO. | FISCAL YEAR | SHEET NO. | TOTAL SHEETS |
|---|---|---|---|---|---|
| HAWAII | HAW. | HIC-01-90 | 1991 | 92 | 109 |

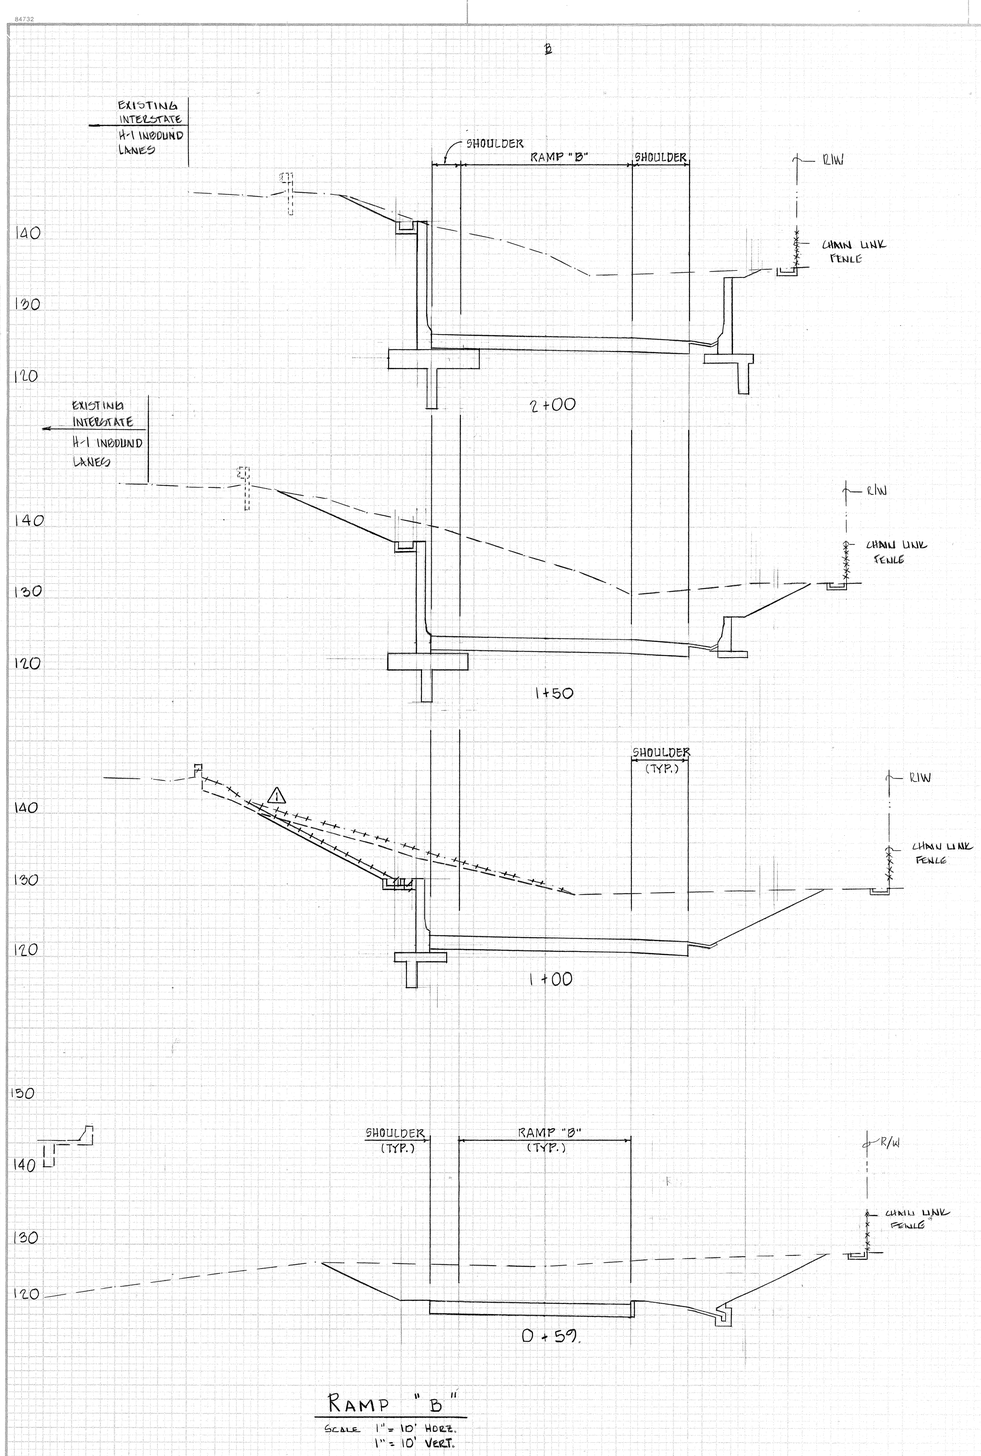

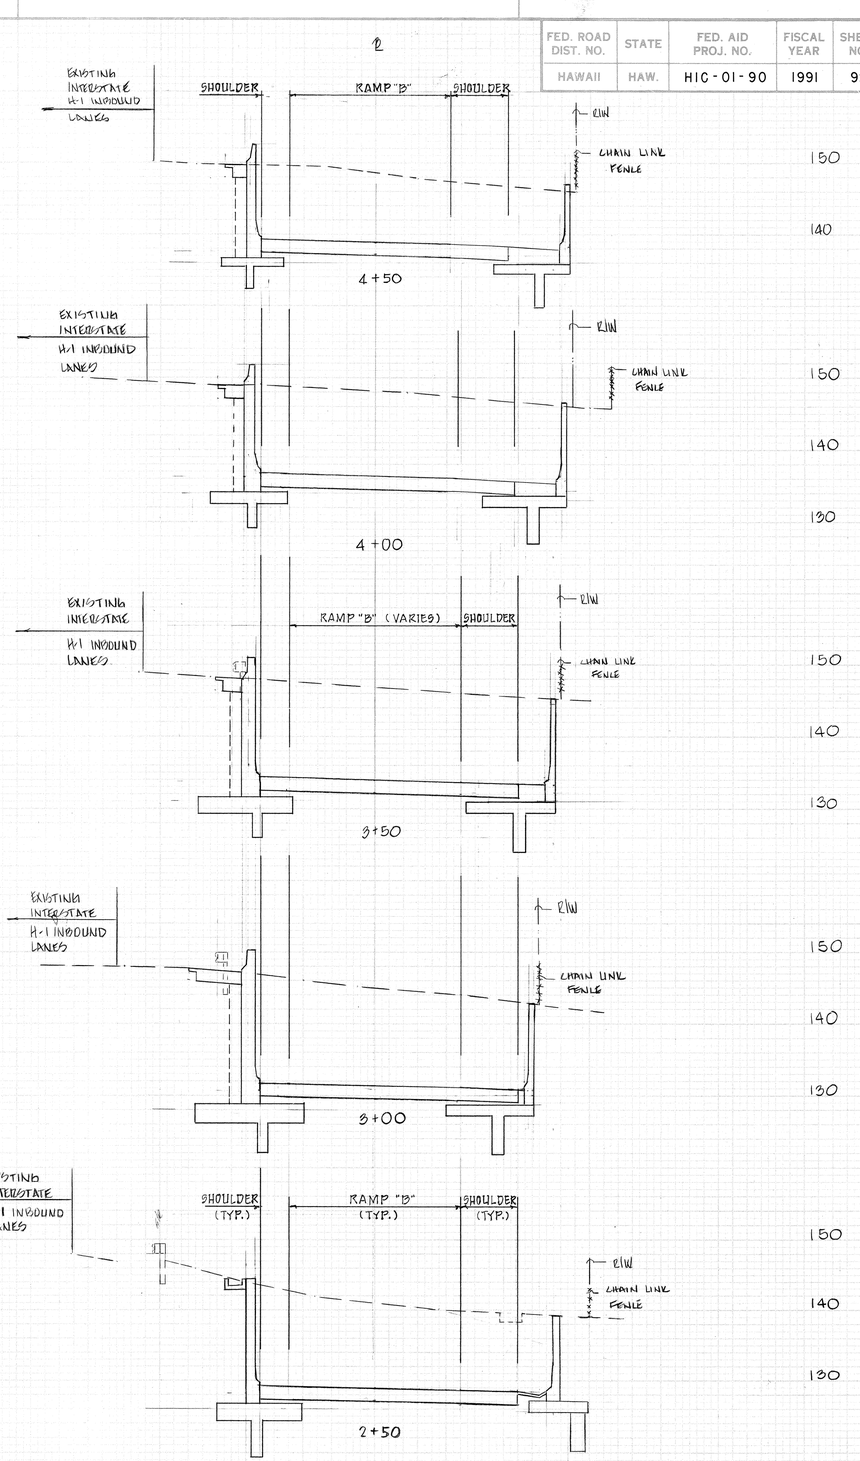




| 12-18-91 | REVISED GRADING @ 1+00 | GPI | |
|---|---|---|---|
| REVISION DATE | DESCRIPTION | MADE BY | APPROVED |

FINAL SURVEY / ORIGINAL SURVEY — BY / DATE — SURVEYED. PLOTTED. TEMPLATE. AREAS CHECKED. NOTE BOOK NO.


92
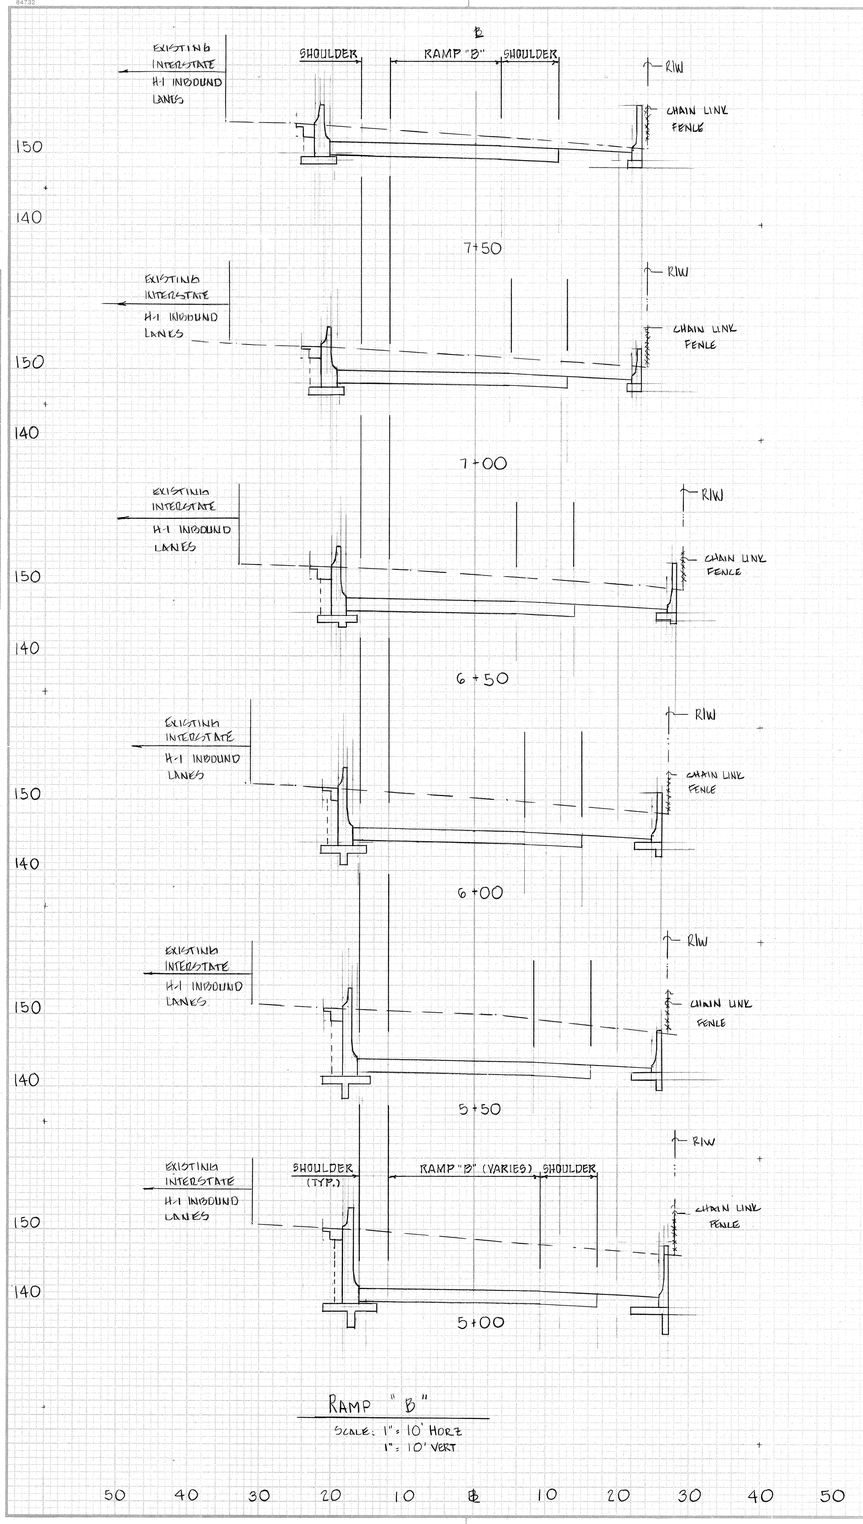
| FED. ROAD DIST. NO. | STATE | FED. AID PROJ. NO. | FISCAL YEAR | SHEET NO. | TOTAL SHEETS |
|---|---|---|---|---|---|
| HAWAII | HAW. | HIC-01-90 | 1991 | 93 | 109 |




RAMP "B"

SCALE: 1" = 10' HORZ
1" = 10' VERT

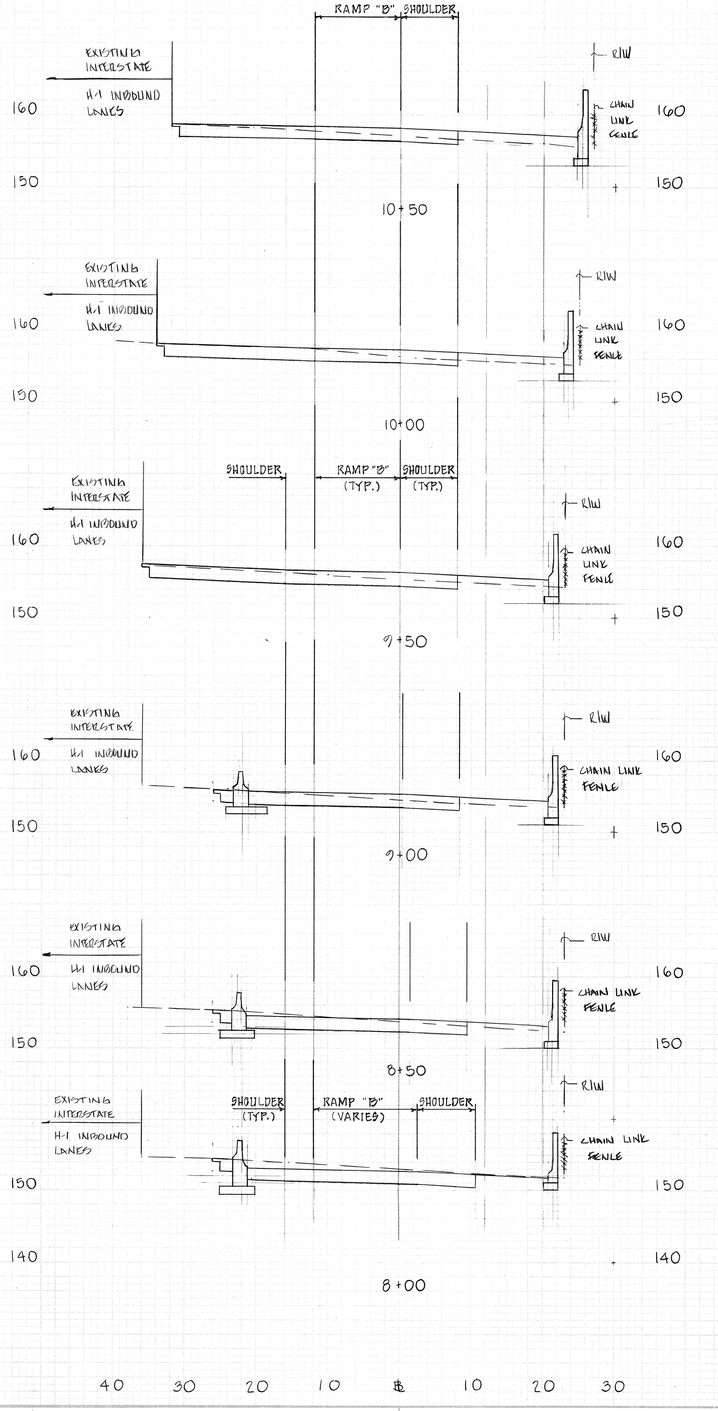


97

84732

| FED. ROAD DIST. NO. | STATE | FED. AID PROJ. NO. | FISCAL YEAR | SHEET NO. | TOTAL SHEETS |
|---|---|---|---|---|---|
| HAWAII | HAW. | HIC-01-90 | 1991 | 94 | 109 |

FINAL SURVEY — NOTE BOOK — NO. — SURVEYED — PLOTTED — TEMPLATE — AREAS CHECKED — BY — DATE


ORIGINAL SURVEY — NOTE BOOK — NO. — SURVEYED — PLOTTED — TEMPLATE — AREAS CHECKED — BY — DATE


84732


| FED. ROAD DIST. NO. | STATE | FED. AID PROJ. NO. | FISCAL YEAR | SHEET NO. | TOTAL SHEETS |
|---|---|---|---|---|---|
| HAWAII | HAW. | HIC-01-90 | 1991 | 95 | 109 |

FINAL SURVEY — NOTE BOOK — NO. — SURVEYED — PLOTTED — TEMPLATE — AREAS — AREAS CHECKED — BY — DATE

ORIGINAL SURVEY — NOTE BOOK — NO. — SURVEYED — PLOTTED — TEMPLATE — AREAS — AREAS CHECKED — BY — DATE

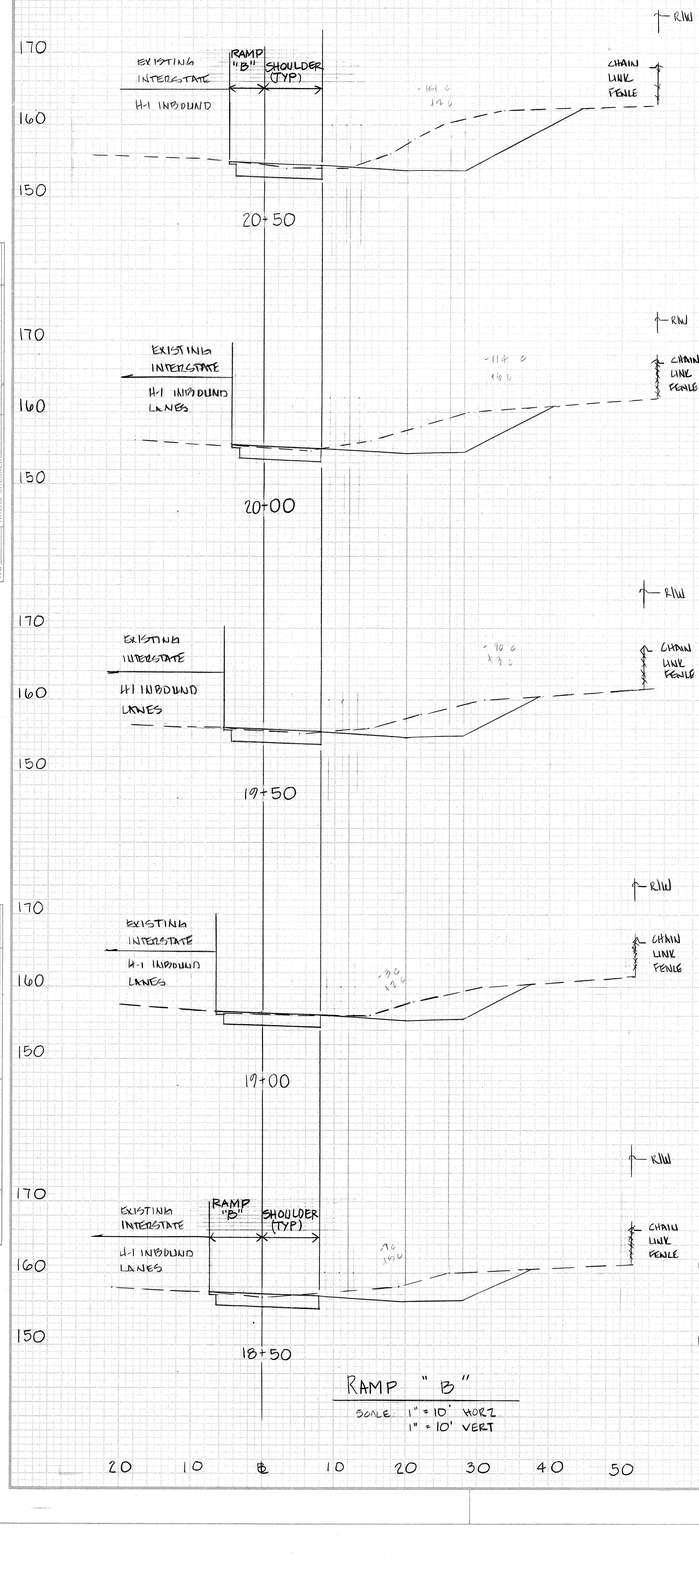

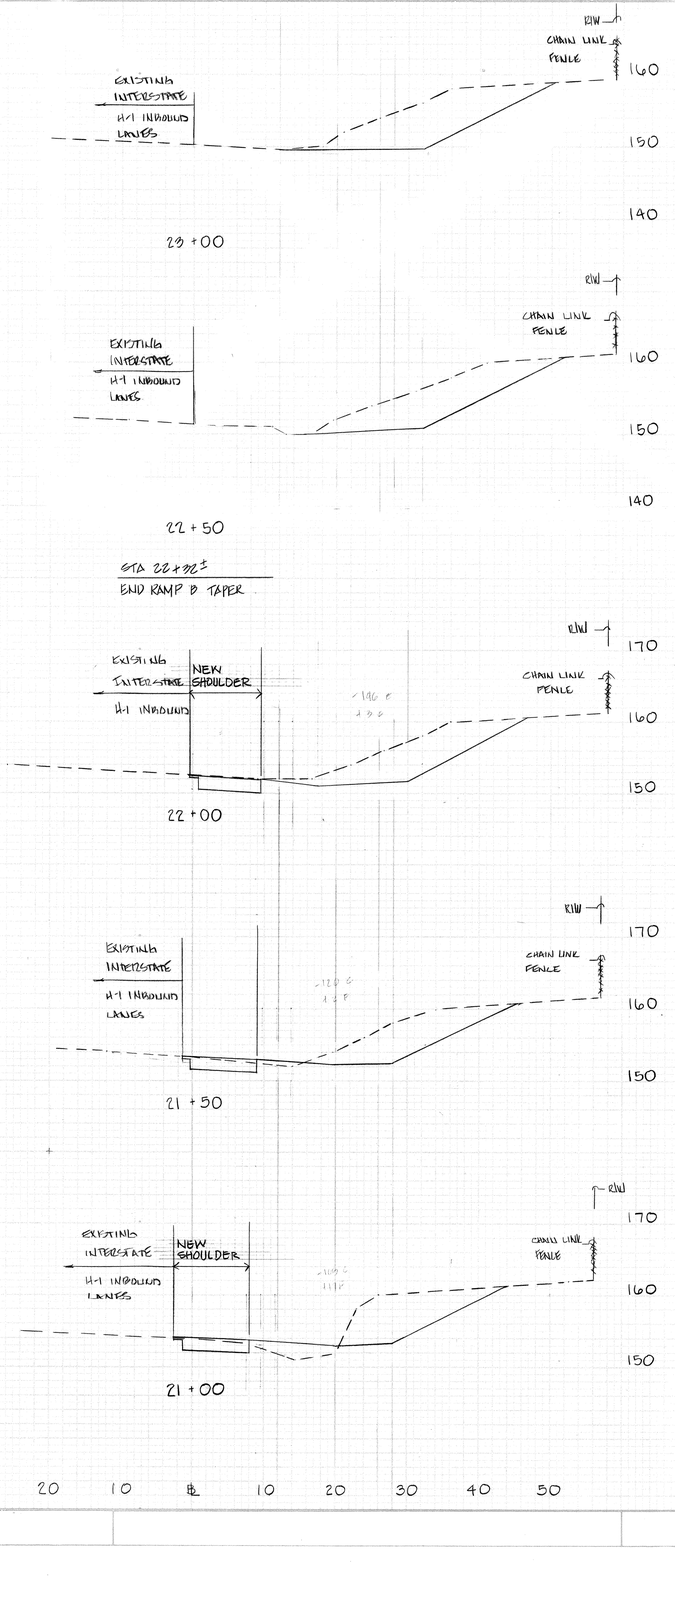84732
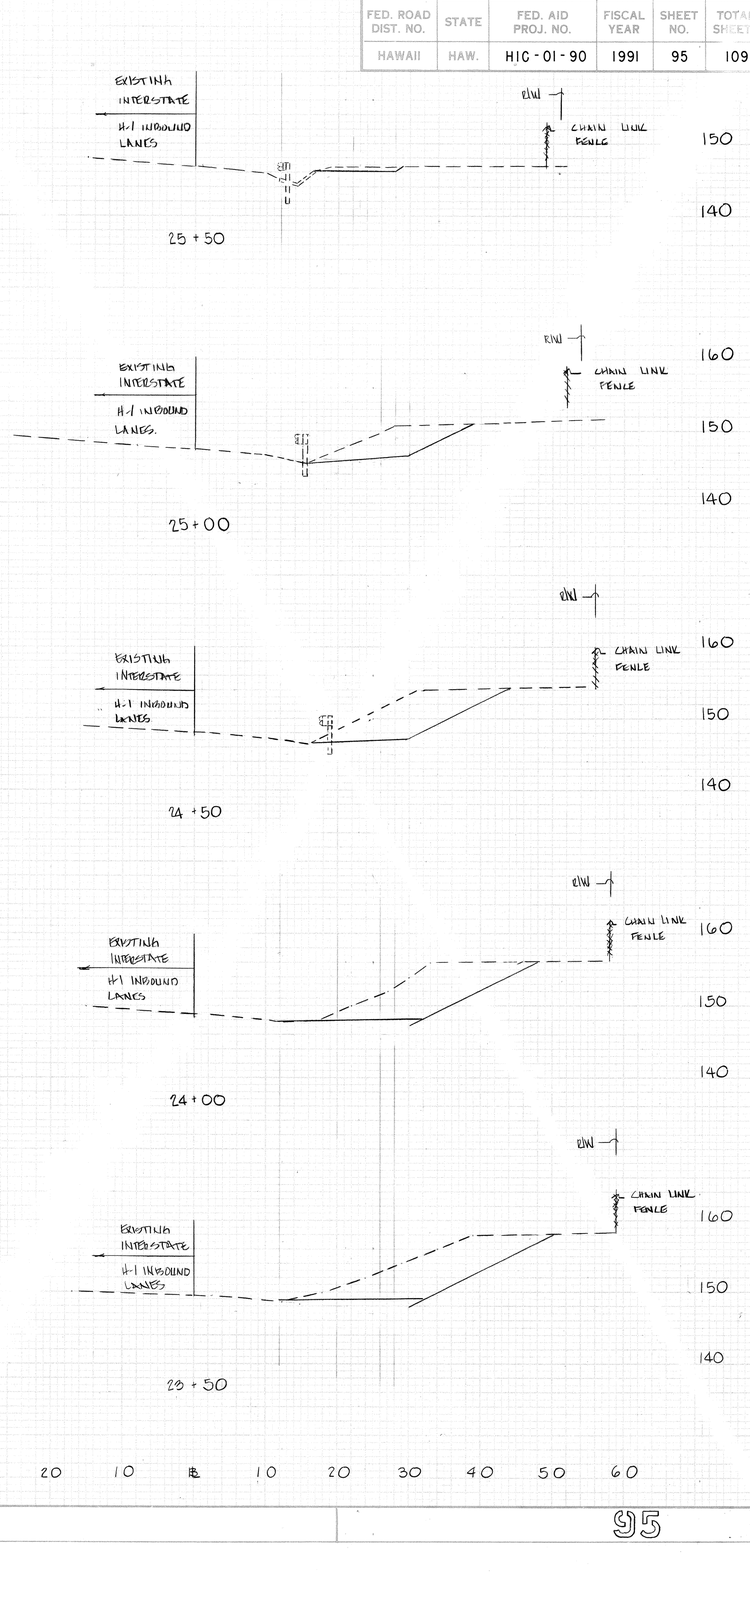
| FED. ROAD DIST. NO. | STATE | FED. AID PROJ. NO. | FISCAL YEAR | SHEET NO. | TOTAL SHEETS |
|---|---|---|---|---|---|
| HAWAII | HAW. | HIC-01-90 | 1991 | 96 | 109 |


FINAL SURVEY — NOTE BOOK — NO. — SURVEYED — PLOTTED — TEMPLATE — AREAS — AREAS CHECKED — BY — DATE

ORIGINAL SURVEY — NOTE BOOK — NO. — SURVEYED — PLOTTED — TEMPLATE — AREAS — AREAS CHECKED — BY — DATE

84732

| FED. ROAD DIST. NO. | STATE | FED. AID PROJ. NO. | FISCAL YEAR | SHEET NO. | TOTAL SHEETS |
|---|---|---|---|---|---|
| HAWAII | HAW. | HIC-01-90 | 1991 | 97 | 109 |

FINAL SURVEY
NOTE BOOK
NO.
SURVEYED
PLOTTED
TEMPLATE
AREAS
AREAS CHECKED
BY
DATE

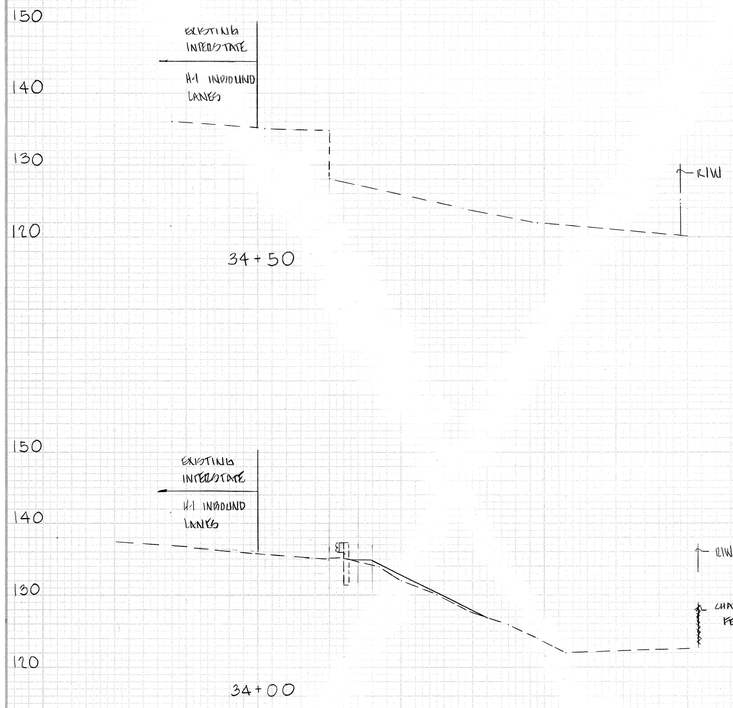








RAMP "B"

SCALE: 1" = 10' HORZ.
1" = 10' VERT.


20 10 0 10 20 30 40 50 60


ORIGINAL SURVEY
NOTE BOOK
NO.
SURVEYED
PLOTTED
TEMPLATE
AREAS
AREAS CHECKED
BY
DATE


84732

| FED. ROAD DIST. NO. | STATE | FED. AID PROJ. NO. | FISCAL YEAR | SHEET NO. | TOTAL SHEETS |
|---|---|---|---|---|---|
| HAWAII | HAW. | HIC-01-90 | 1991 | 98 | 109 |

| FINAL SURVEY | ORIGINAL SURVEY | |
|---|---|---|
| NOTE BOOK | NOTE BOOK | |
| NO. | NO. | |
| AREAS CHECKED | AREAS CHECKED | |
| TEMPLATE | TEMPLATE | |
| PLOTTED | PLOTTED | |
| SURVEYED | SURVEYED | |
| BY | BY | |
| DATE | DATE | |

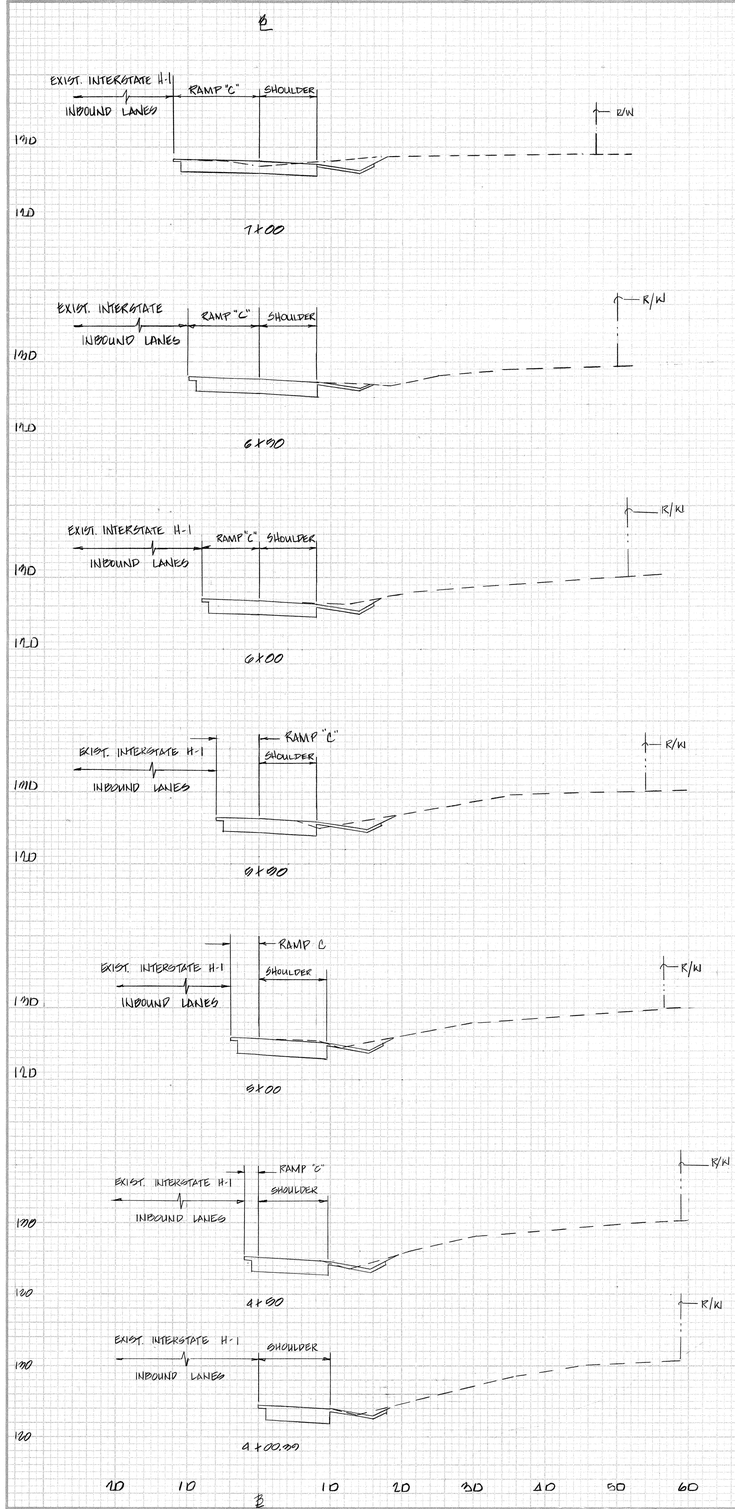

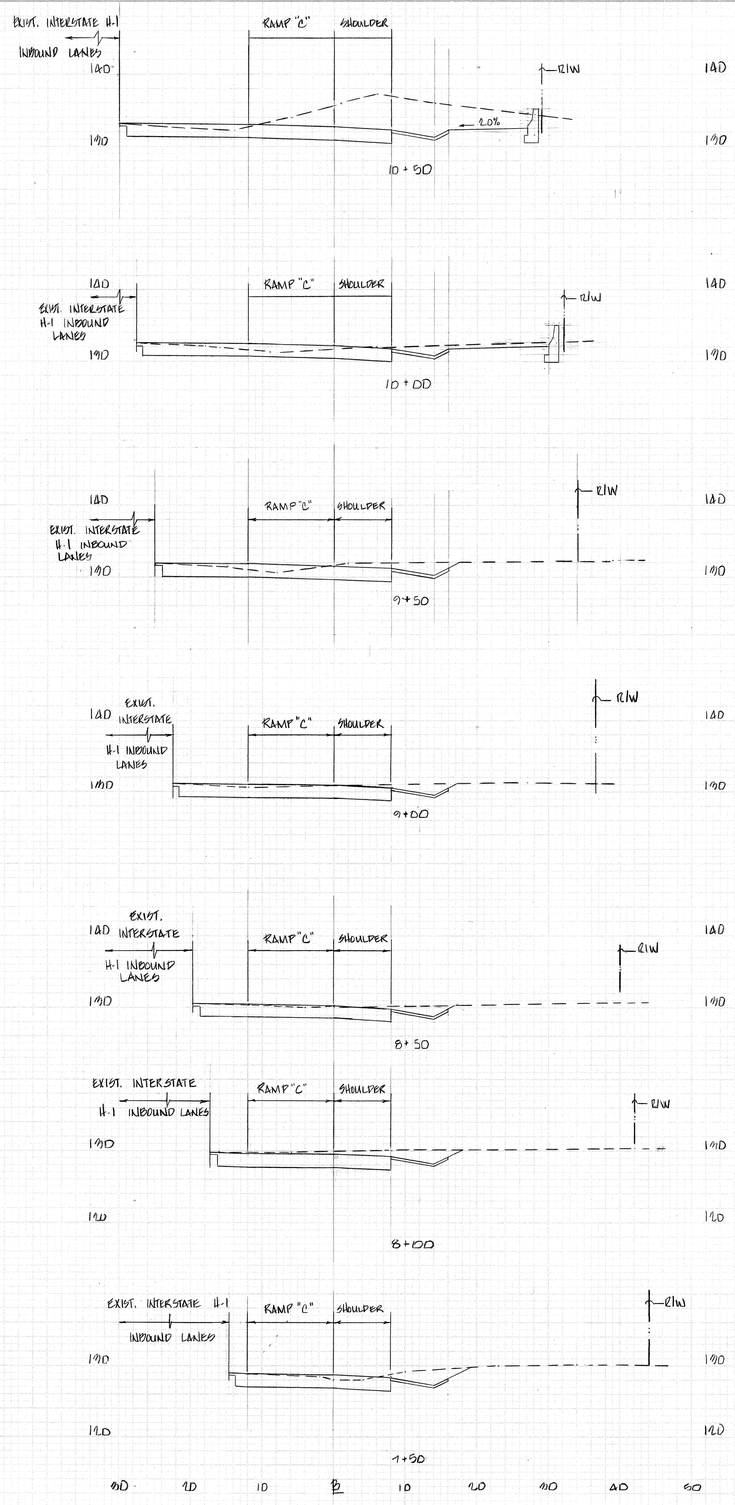


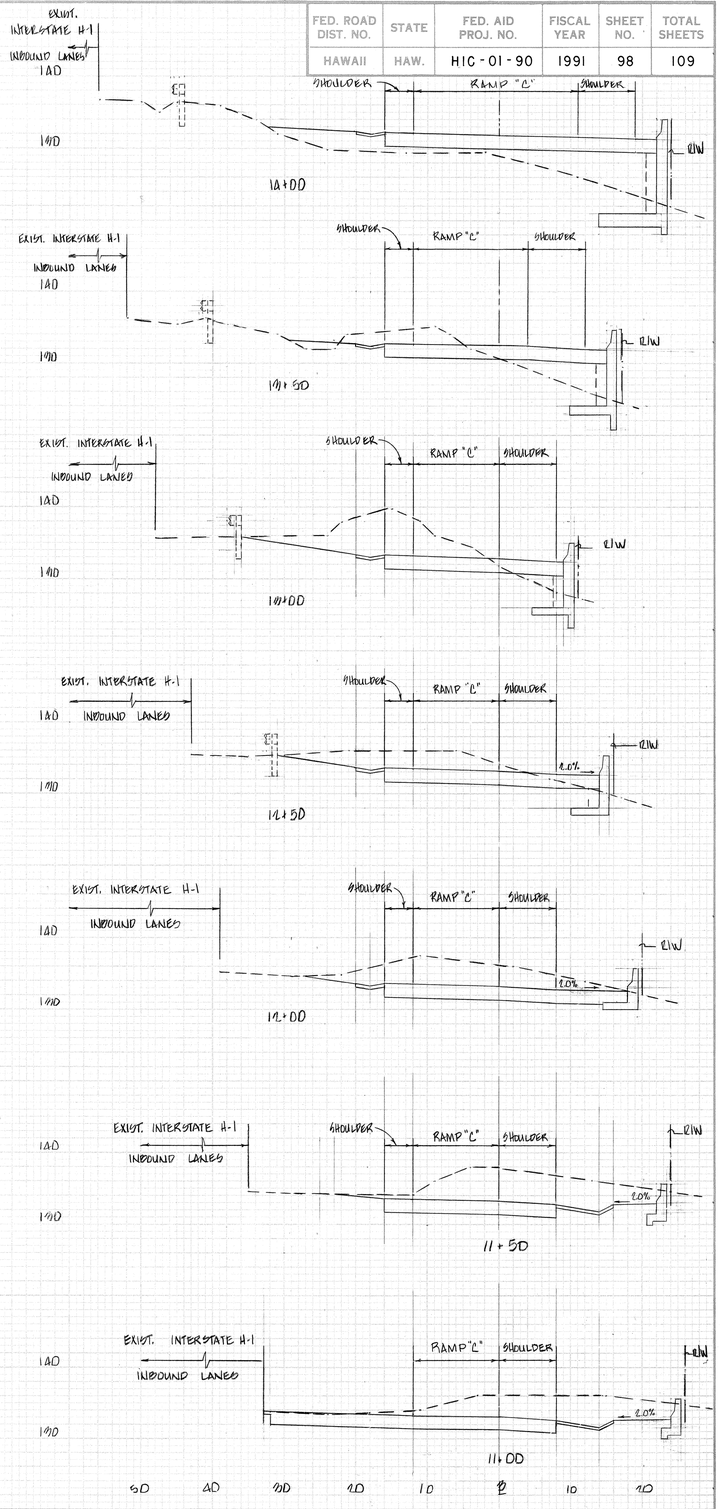
84732

| FED. ROAD DIST. NO. | STATE | FED. AID PROJ. NO. | FISCAL YEAR | SHEET NO. | TOTAL SHEETS |
|---|---|---|---|---|---|
| HAWAII | HAW. | HIC-01-90 | 1991 | 99 | 109 |

FINAL SURVEY — NOTE BOOK — NO. — BY — DATE — SURVEYED — PLOTTED — TEMPLATE — AREAS — AREAS CHECKED

ORIGINAL SURVEY — NOTE BOOK — NO. — BY — DATE — SURVEYED — PLOTTED — TEMPLATE — AREAS — AREAS CHECKED

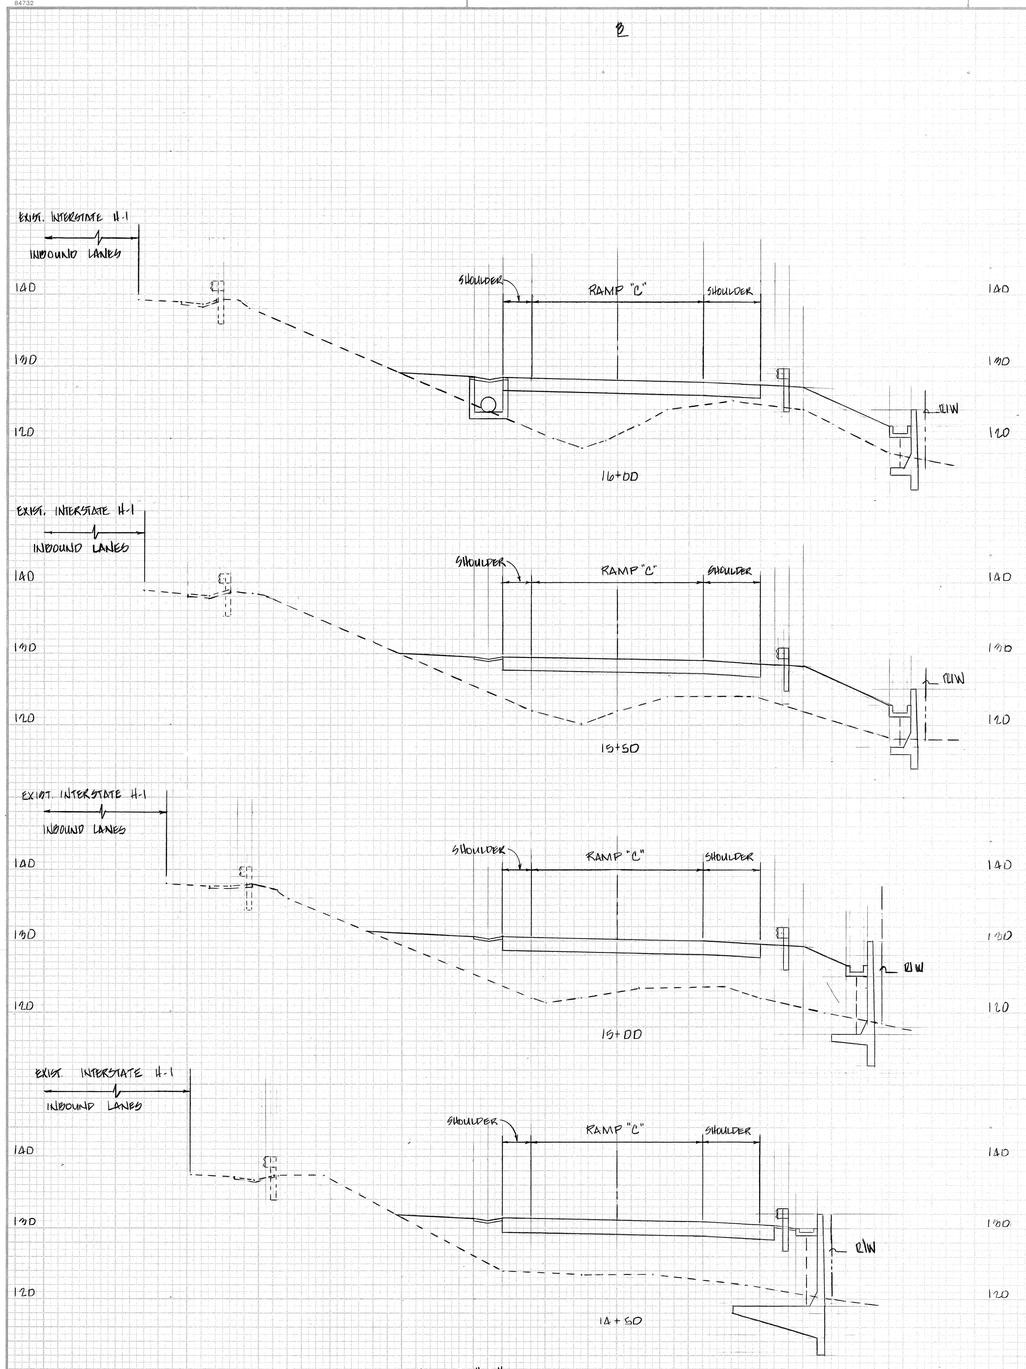


| ⚠ | 10-3-91 | REVISED GRADING - 17+00 & 17+50 | C.P.I. | |
|---|---|---|---|---|
| | REVISION DATE | DESCRIPTION | MADE BY | APPROVED |


99

84732

| FED. ROAD DIST. NO. | STATE | FED. AID PROJ. NO. | FISCAL YEAR | SHEET NO. | TOTAL SHEETS |
|---|---|---|---|---|---|
| HAWAII | HAW. | HIG-01-90 | 1991 | 100 | 109 |

FINAL SURVEY — NOTE BOOK — NO. — BY — DATE — SURVEYED — PLOTTED — TEMPLATE — AREAS — AREAS CHECKED

ORIGINAL SURVEY — NOTE BOOK — NO. — BY — DATE — SURVEYED — PLOTTED — TEMPLATE — AREAS — AREAS CHECKED

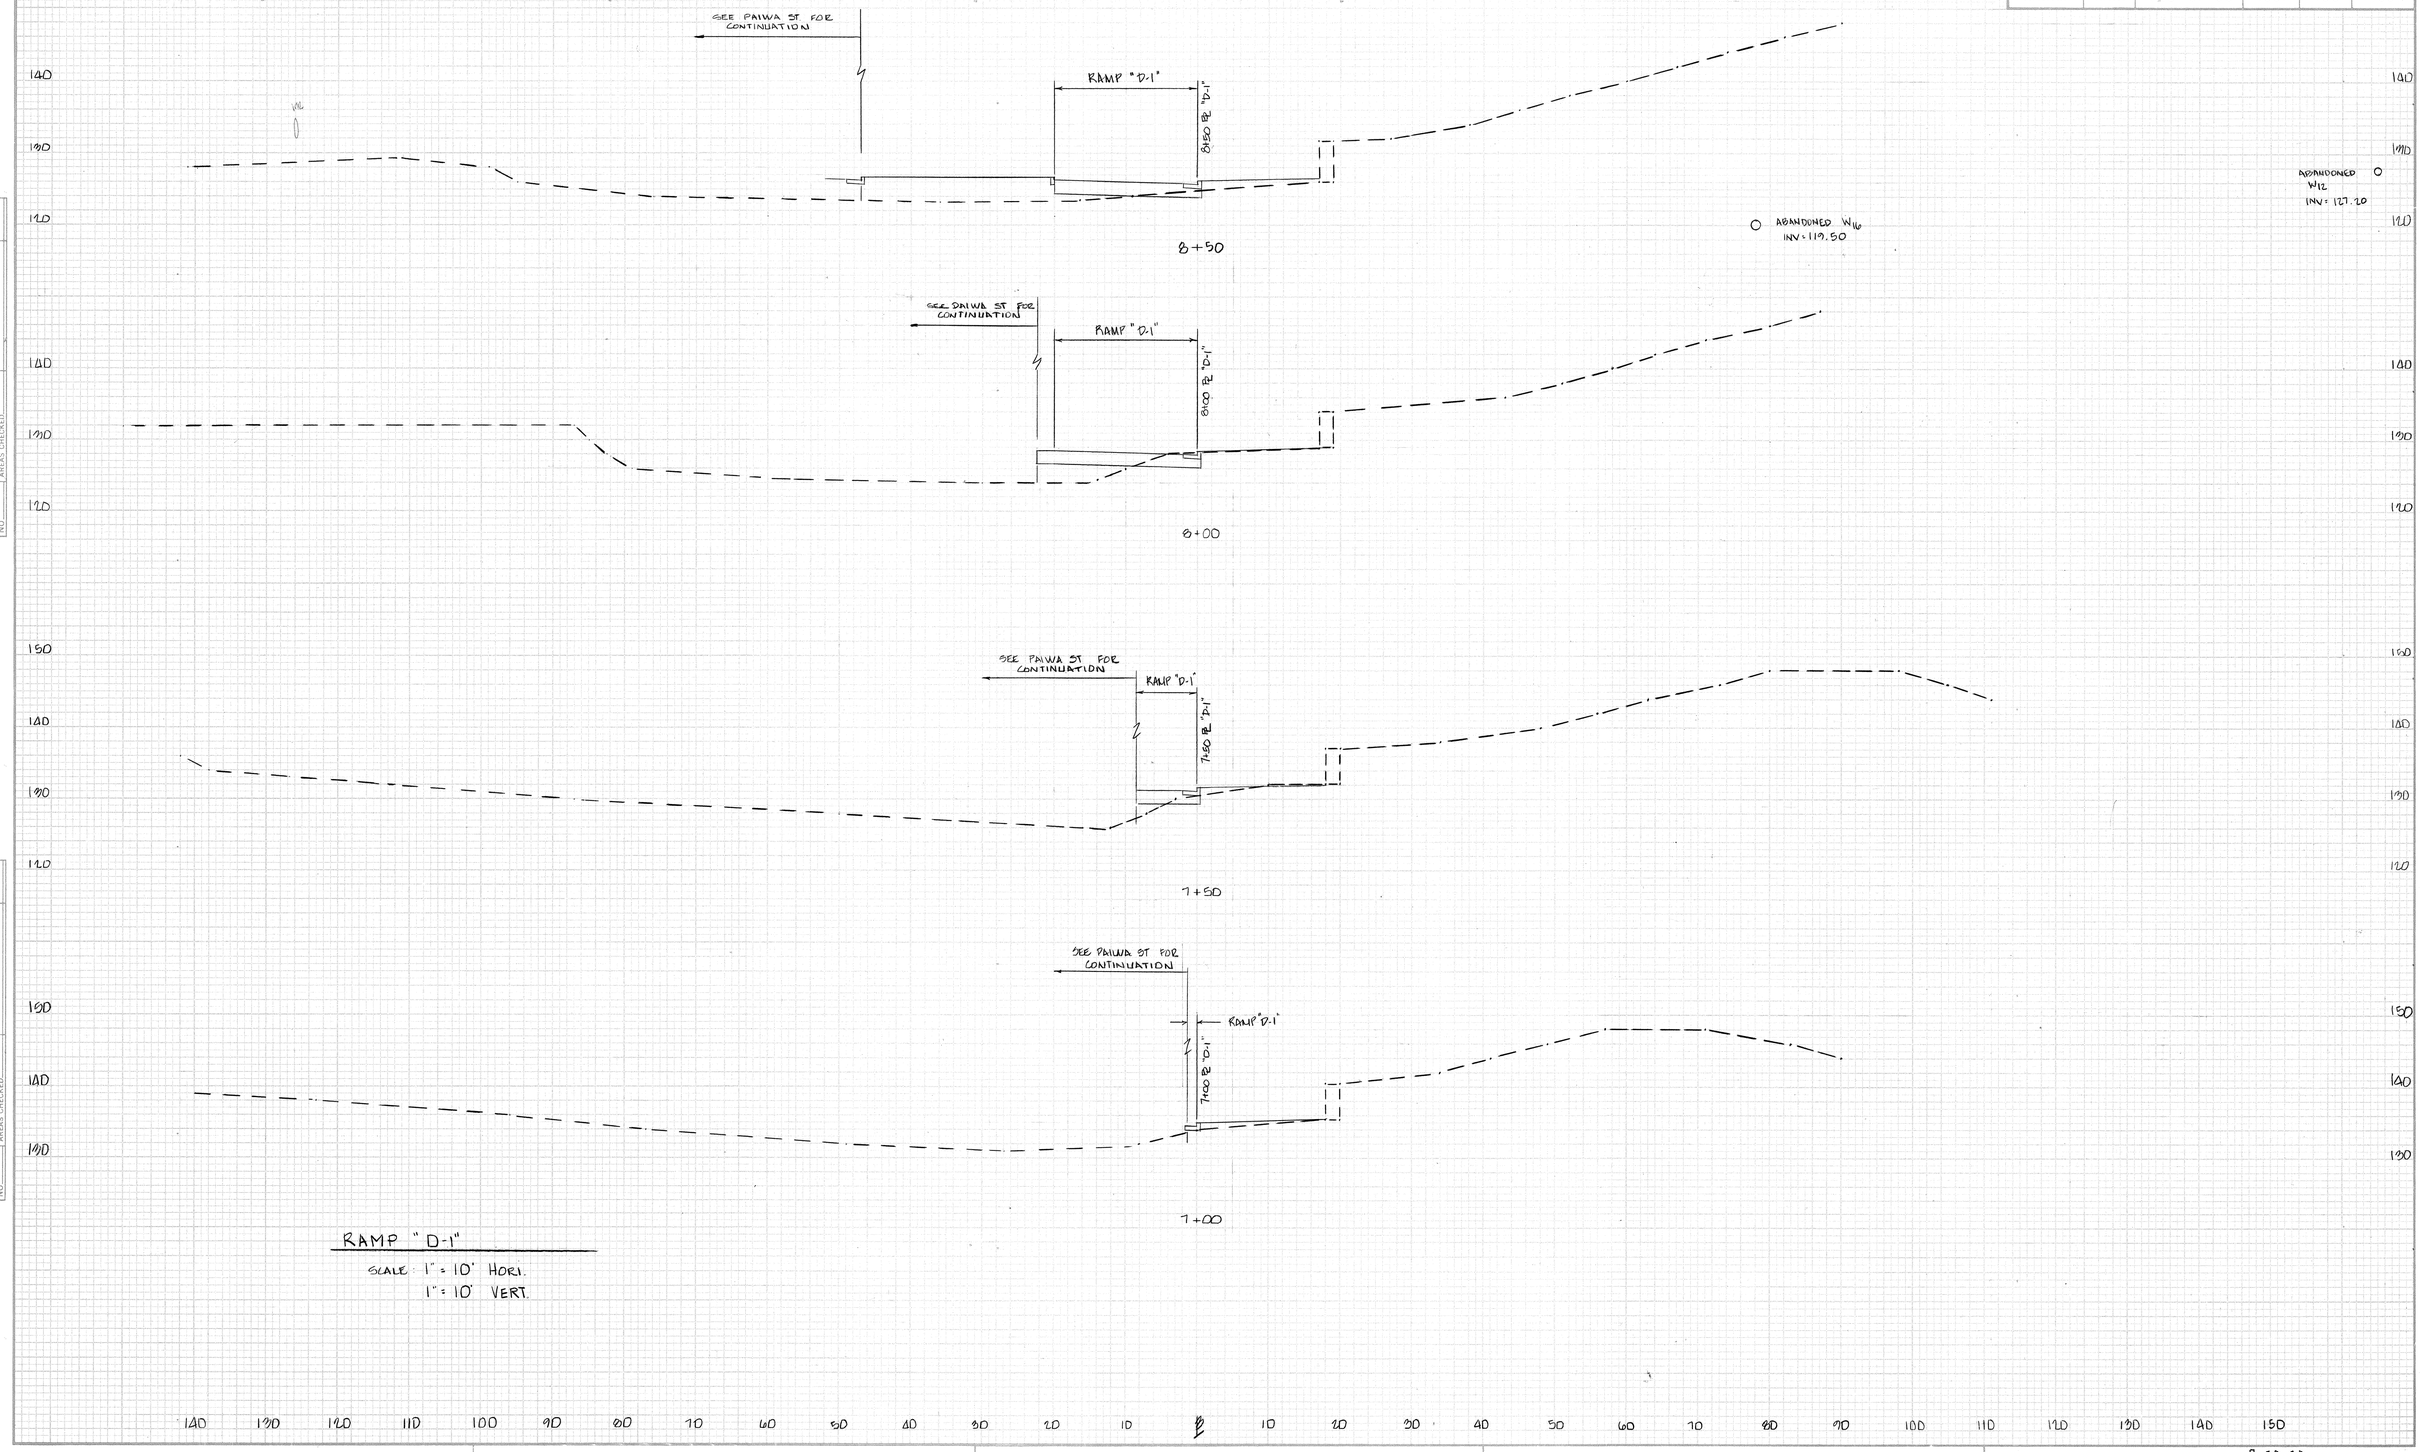



RAMP "D-1"

SCALE: 1" = 10' HORI.
1" = 10' VERT.

| FED. ROAD DIST. NO. | STATE | FED. AID PROJ. NO. | FISCAL YEAR | SHEET NO. | TOTAL SHEETS |
|---|---|---|---|---|---|
| HAWAII | HAW. | HIC-01-90 | 1991 | 101 | 109 |

| FINAL SURVEY | DATE |
|---|---|
| NOTE BOOK | BY |
| NO. | SURVEYED |
| | PLOTTED |
| | TEMPLATE |
| | AREAS |
| | AREAS CHECKED |

| ORIGINAL SURVEY | DATE |
|---|---|
| NOTE BOOK | BY |
| NO. | SURVEYED |
| | PLOTTED |
| | TEMPLATE |
| | AREAS |
| | AREAS CHECKED |

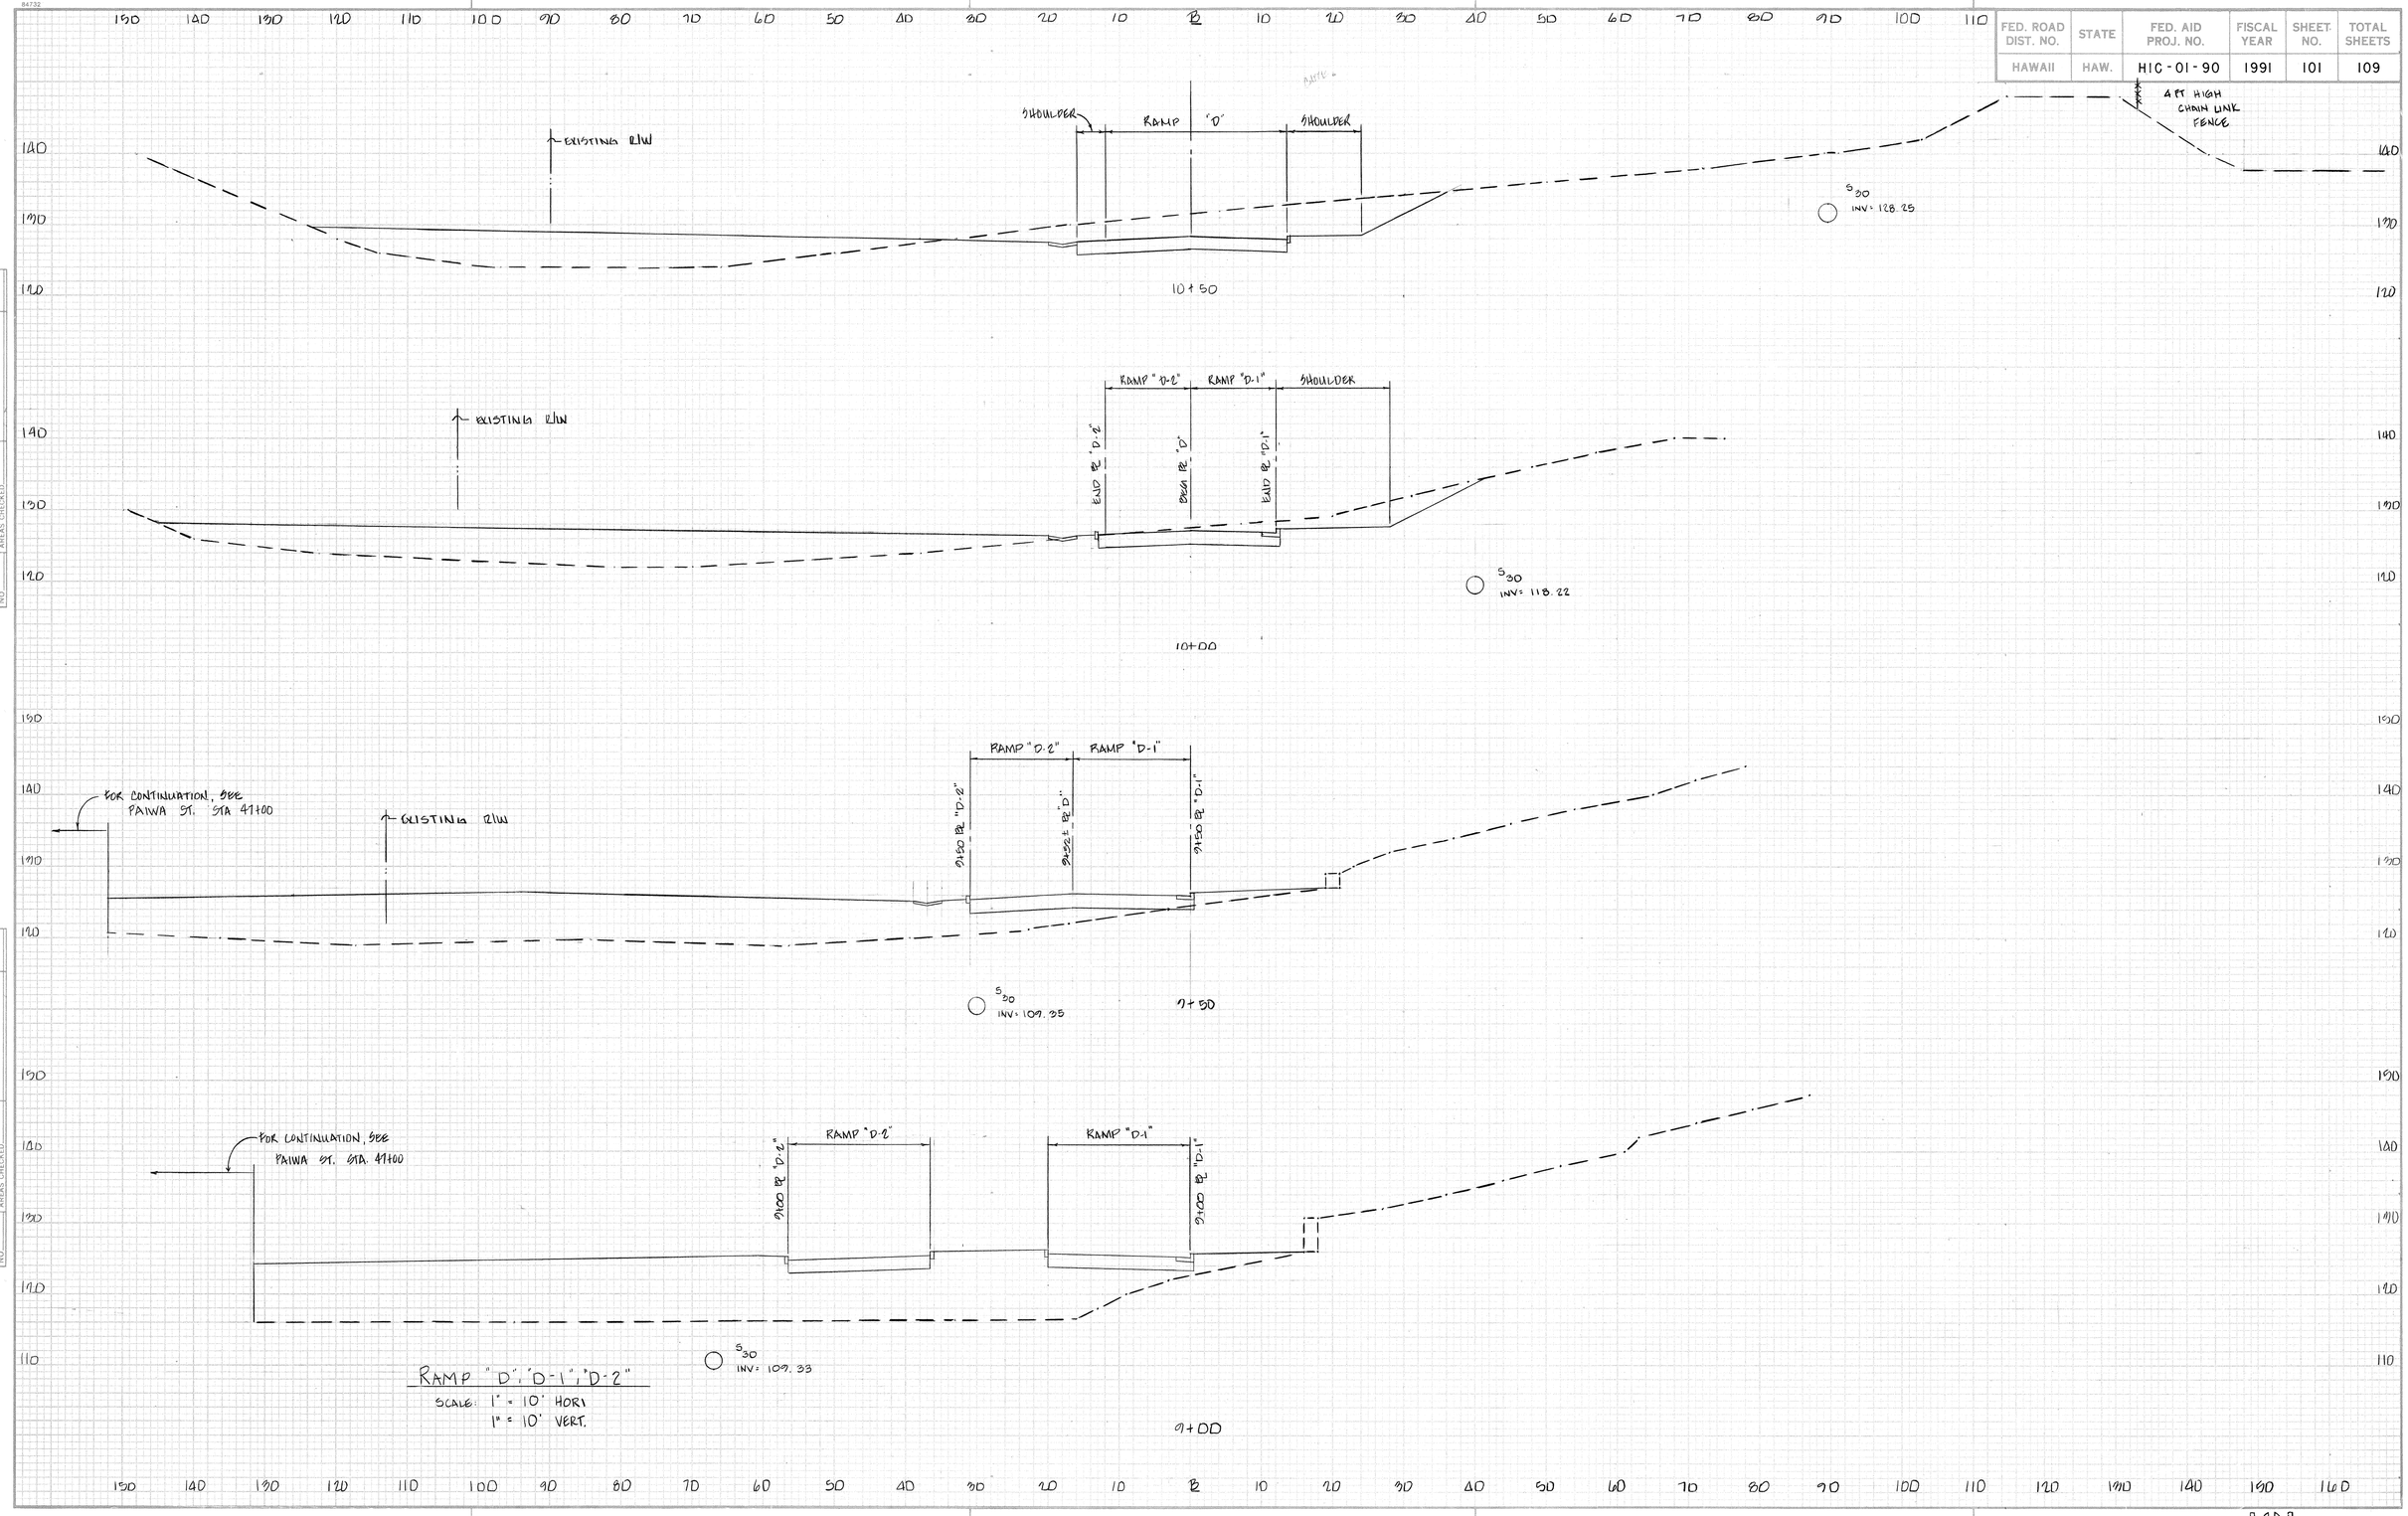


RAMP "D", "D-1", "D-2"


SCALE: 1" = 10' HORI
1" = 10' VERT.

84732

| FED. ROAD DIST. NO. | STATE | FED. AID PROJ. NO. | FISCAL YEAR | SHEET NO. | TOTAL SHEETS |
|---|---|---|---|---|---|

FINAL SURVEY — NOTE BOOK NO. — SURVEYED — PLOTTED — TEMPLATE — AREAS — AREAS CHECKED — BY — DATE

ORIGINAL SURVEY — NOTE BOOK NO. — SURVEYED — PLOTTED — TEMPLATE — AREAS — AREAS CHECKED — BY — DATE

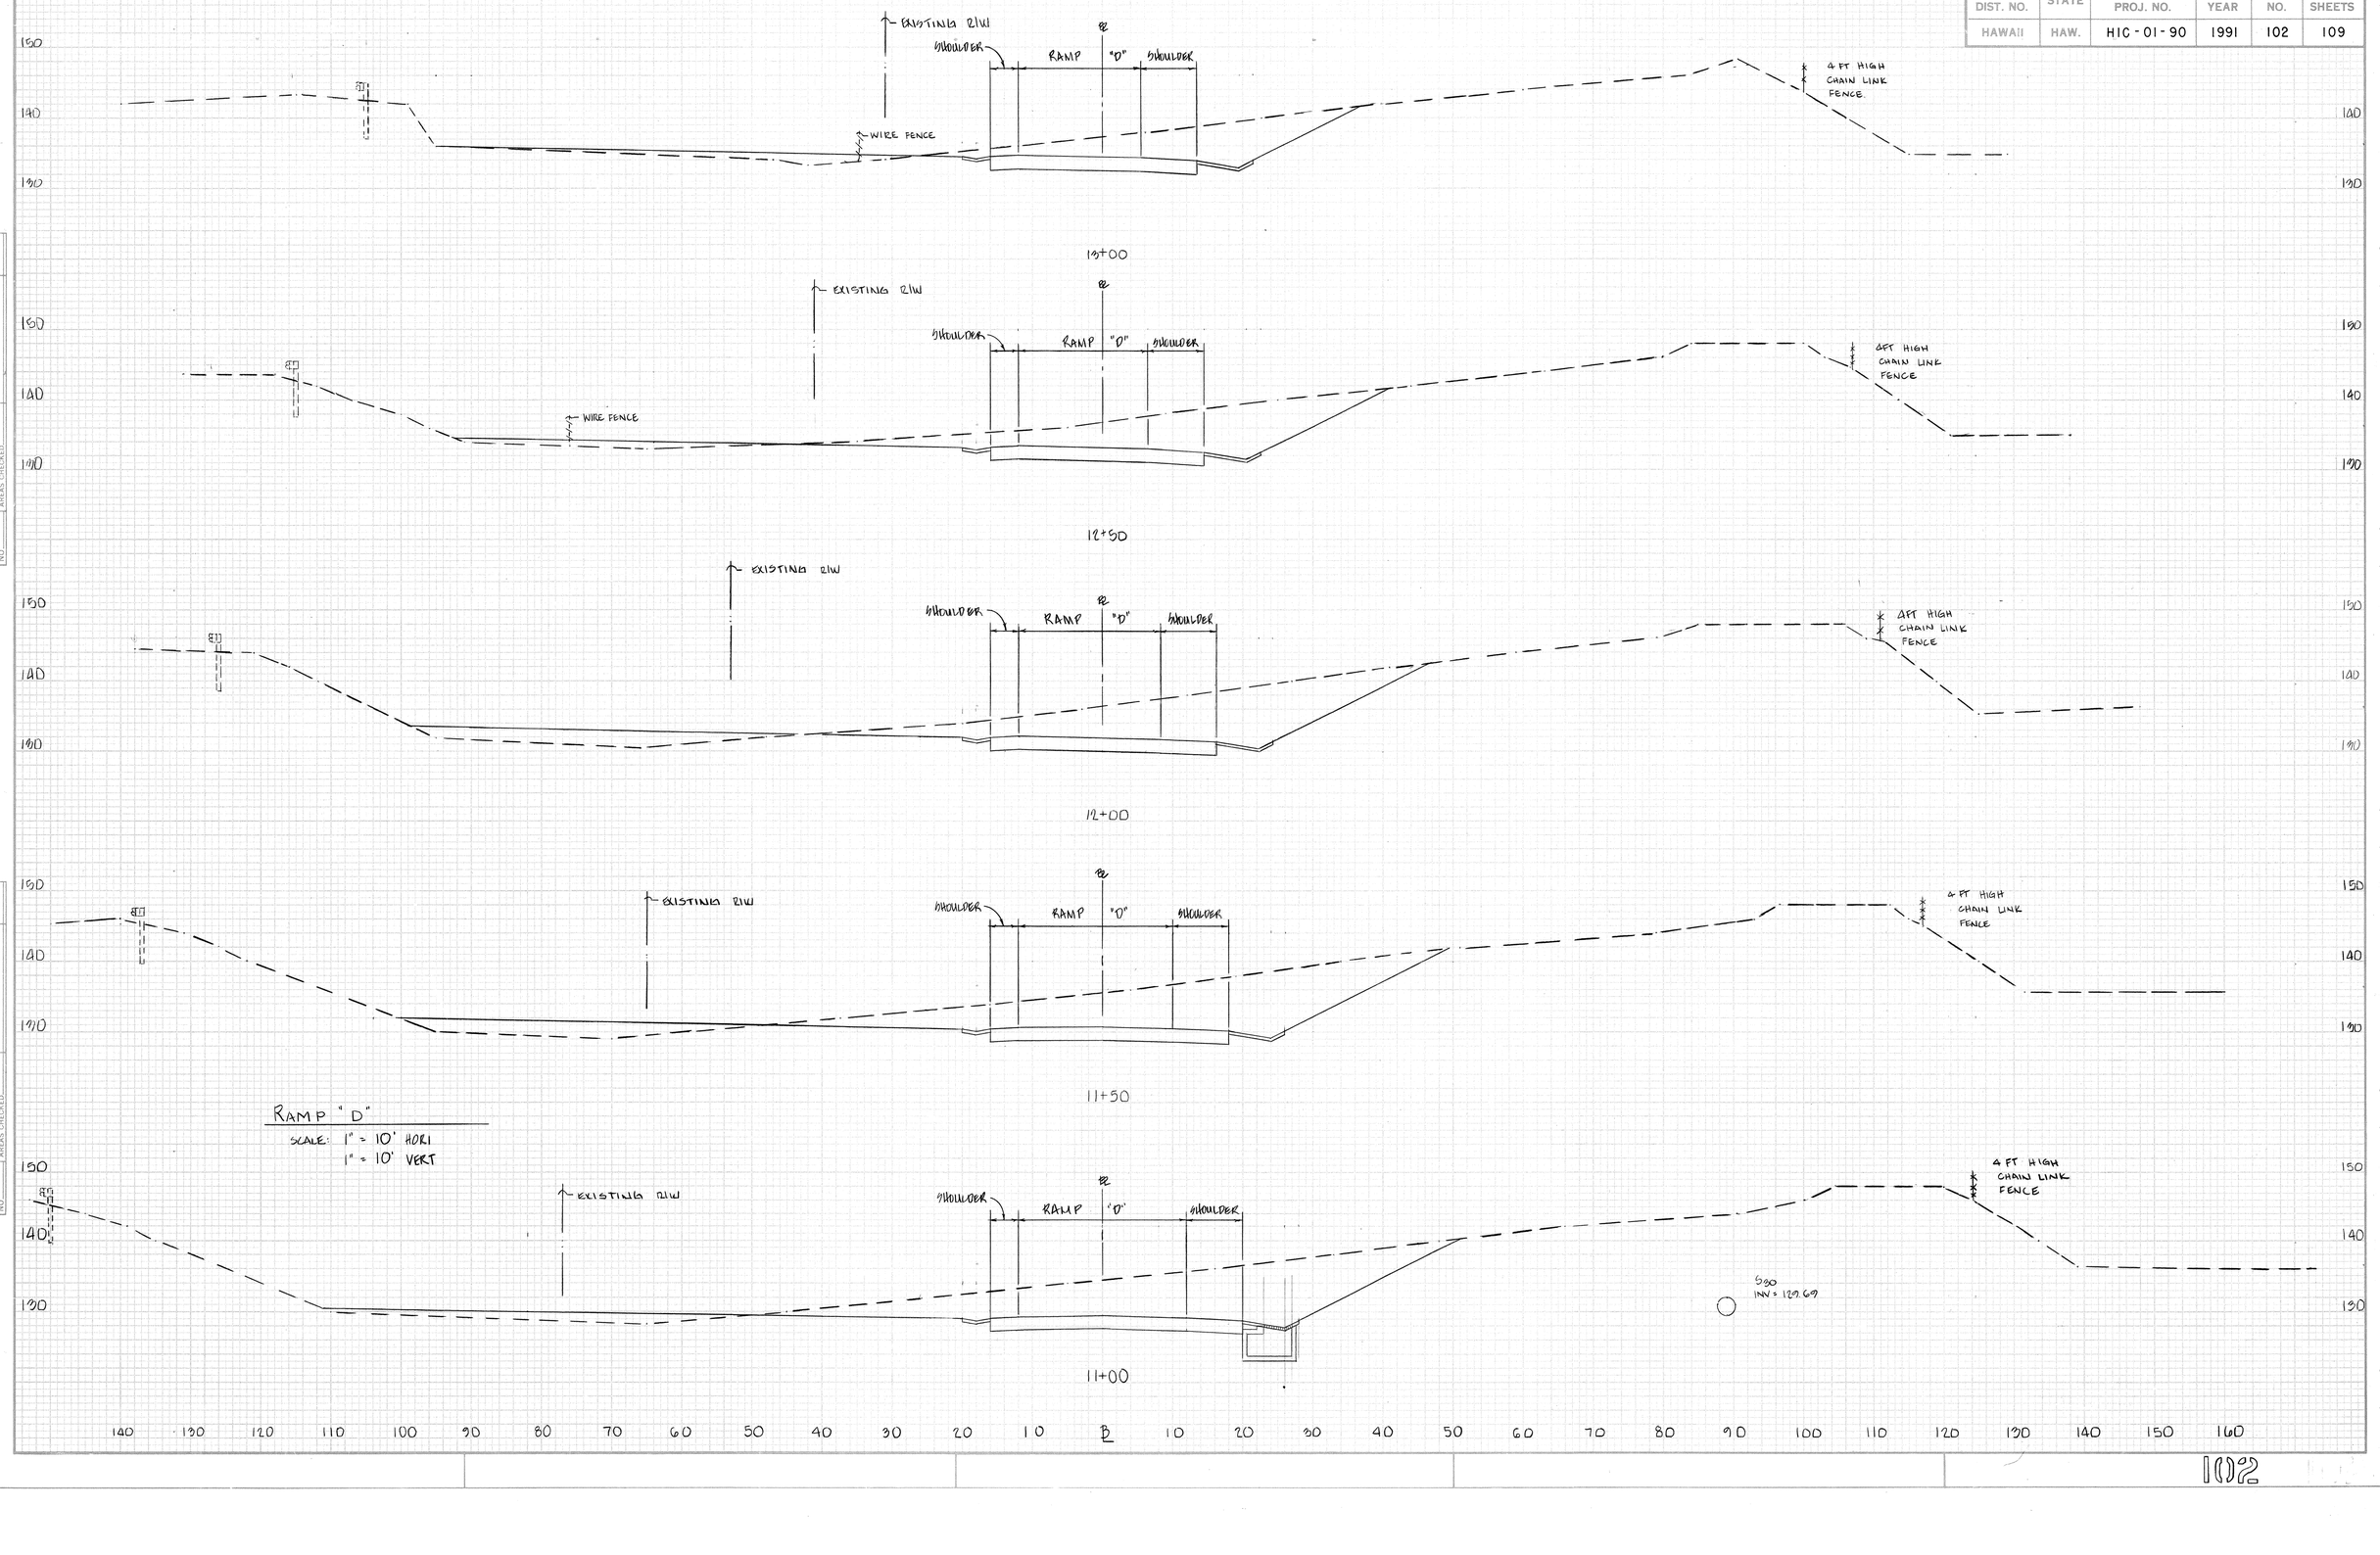



102

84732

| FED. ROAD DIST. NO. | STATE | FED. AID PROJ. NO. | FISCAL YEAR | SHEET NO. | TOTAL SHEETS |
|---|---|---|---|---|---|
| HAWAII | HAW. | HIC-01-90 | 1991 | 103 | 109 |

FINAL SURVEY — NOTE BOOK NO. — SURVEYED, PLOTTED, TEMPLATE, AREAS, CROSS CHECKED — BY — DATE

ORIGINAL SURVEY — NOTE BOOK NO. — SURVEYED, PLOTTED, TEMPLATE, AREAS, CROSS CHECKED — BY — DATE

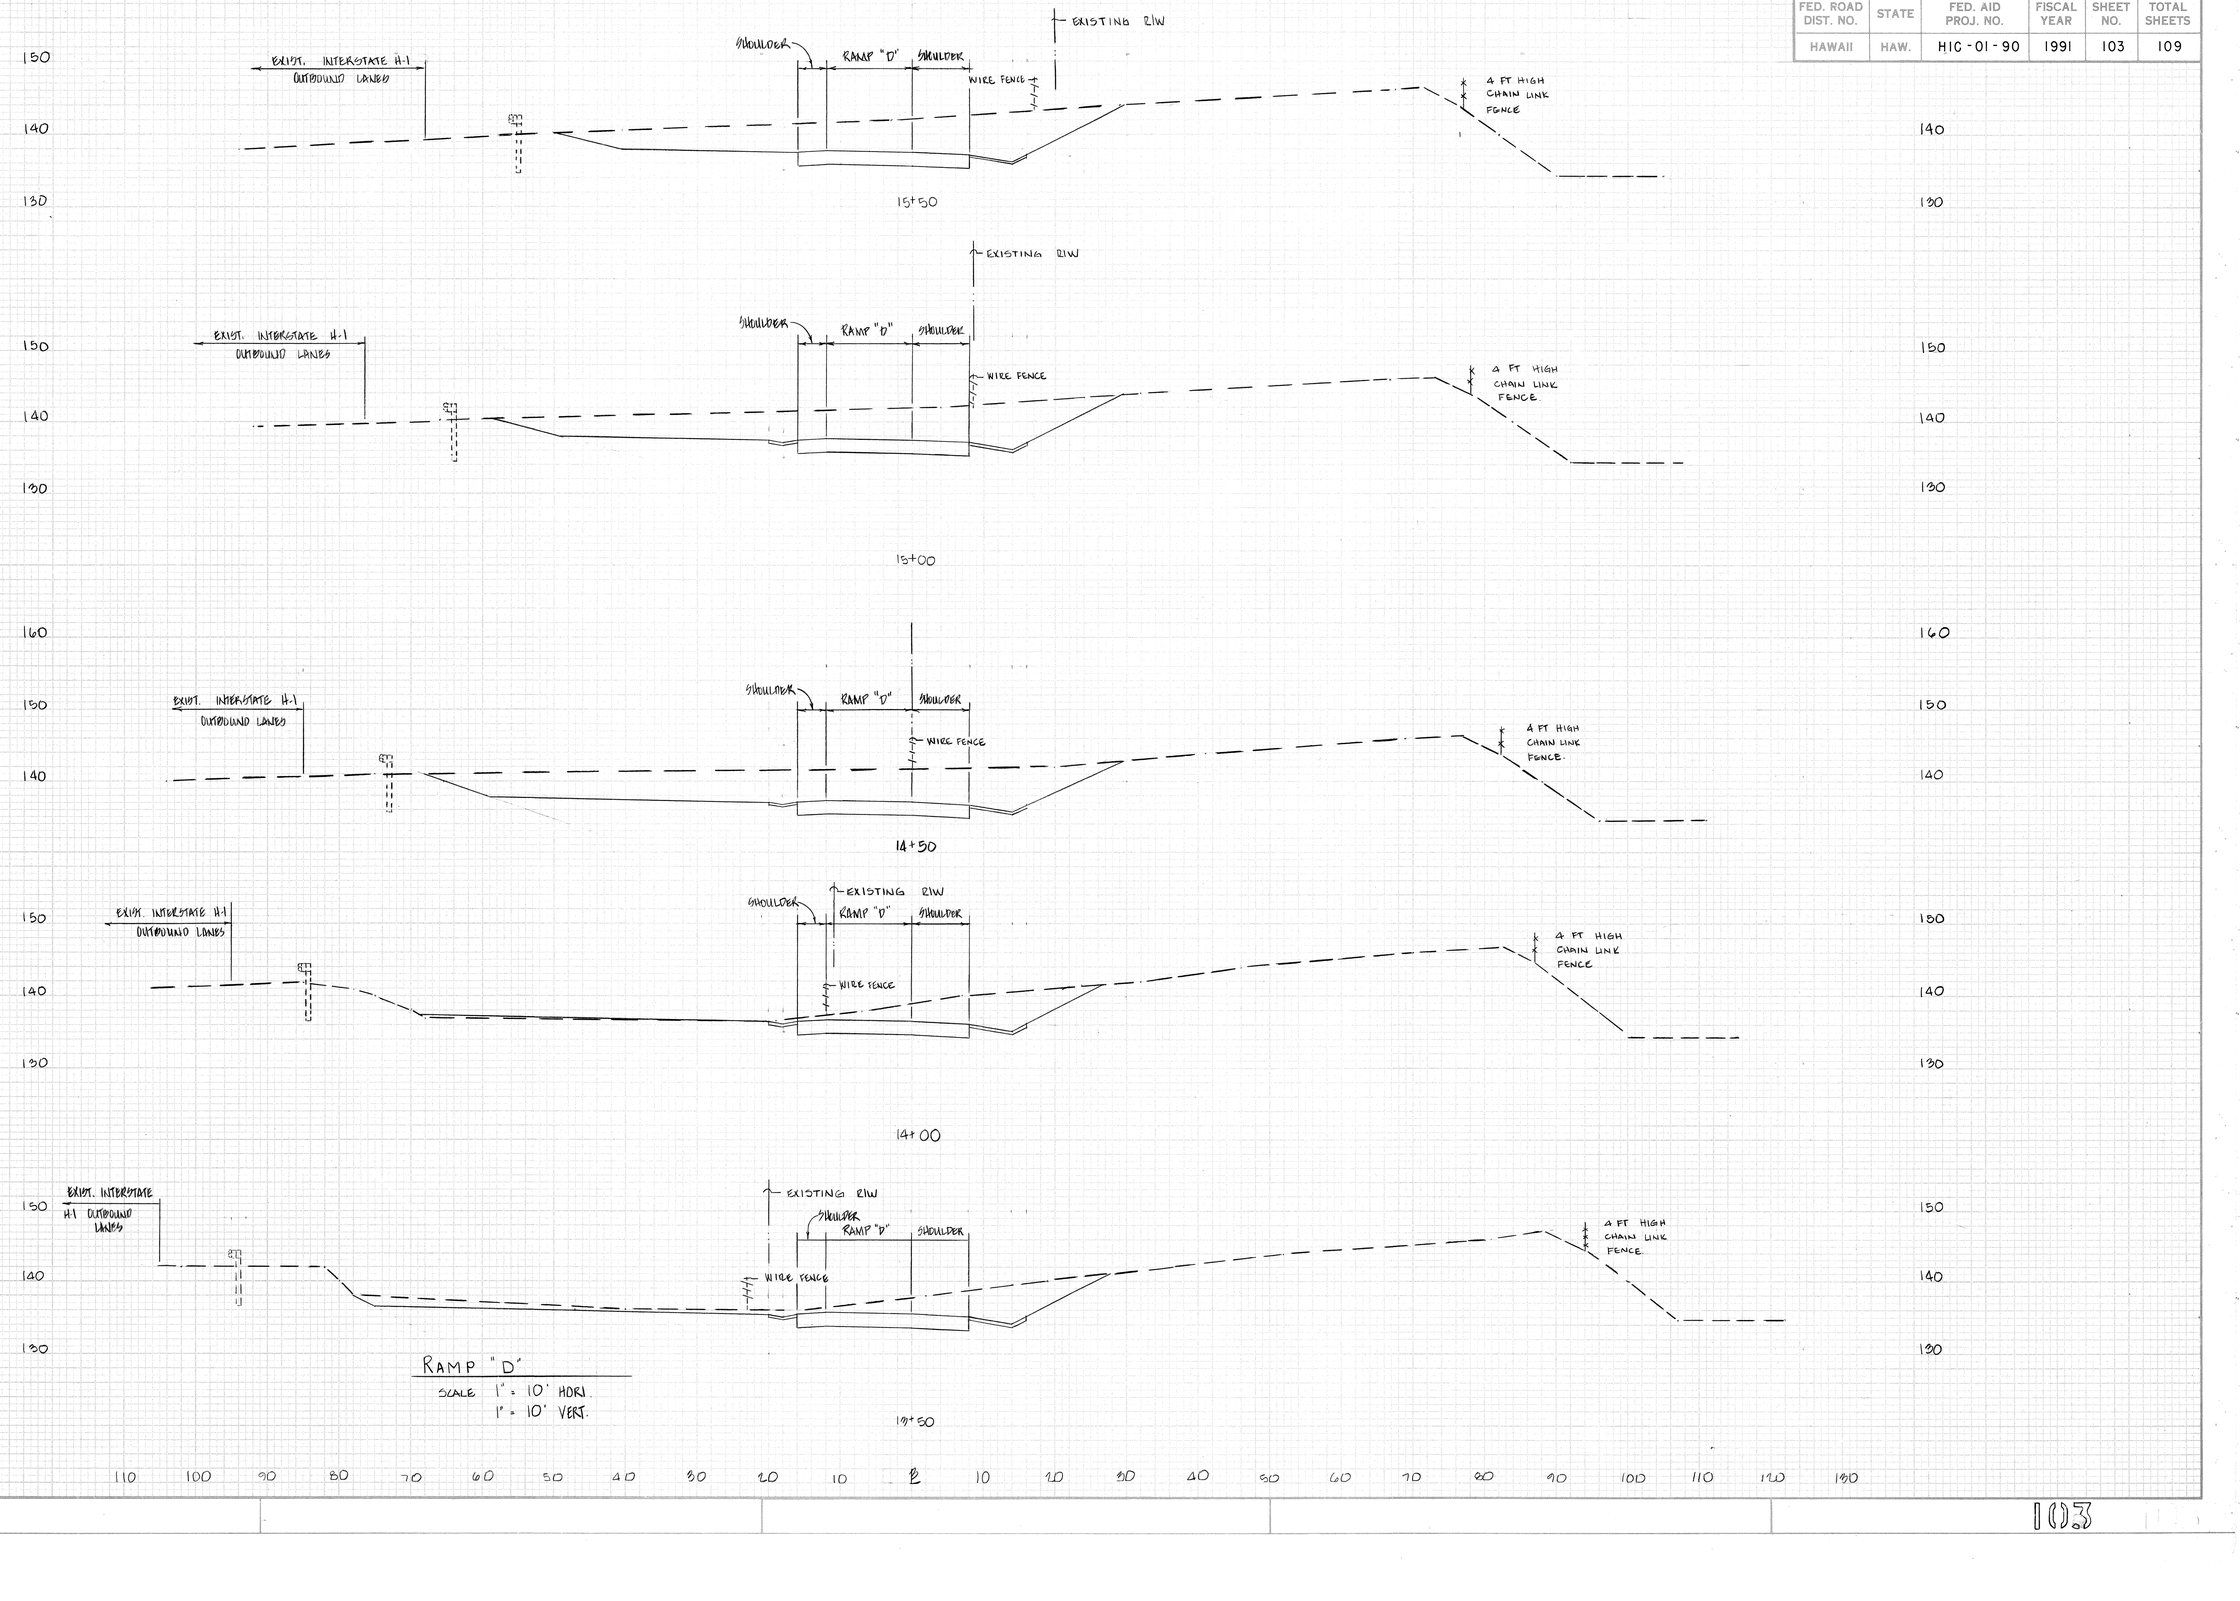


RAMP "D"


SCALE 1" = 10' HORI.
1" = 10' VERT.

84732

| FED. ROAD DIST. NO. | STATE | FED. AID PROJ. NO. | FISCAL YEAR | SHEET NO. | TOTAL SHEETS |
|---|---|---|---|---|---|
| HAWAII | HAW. | HIC-01-90 | 1991 | 104 | 109 |

FINAL SURVEY — NOTE BOOK — NO. — SURVEYED — PLOTTED — TEMPLATE — AREAS — AREAS CHECKED — BY — DATE

ORIGINAL SURVEY — NOTE BOOK — NO. — SURVEYED — PLOTTED — TEMPLATE — AREAS — AREAS CHECKED — BY — DATE

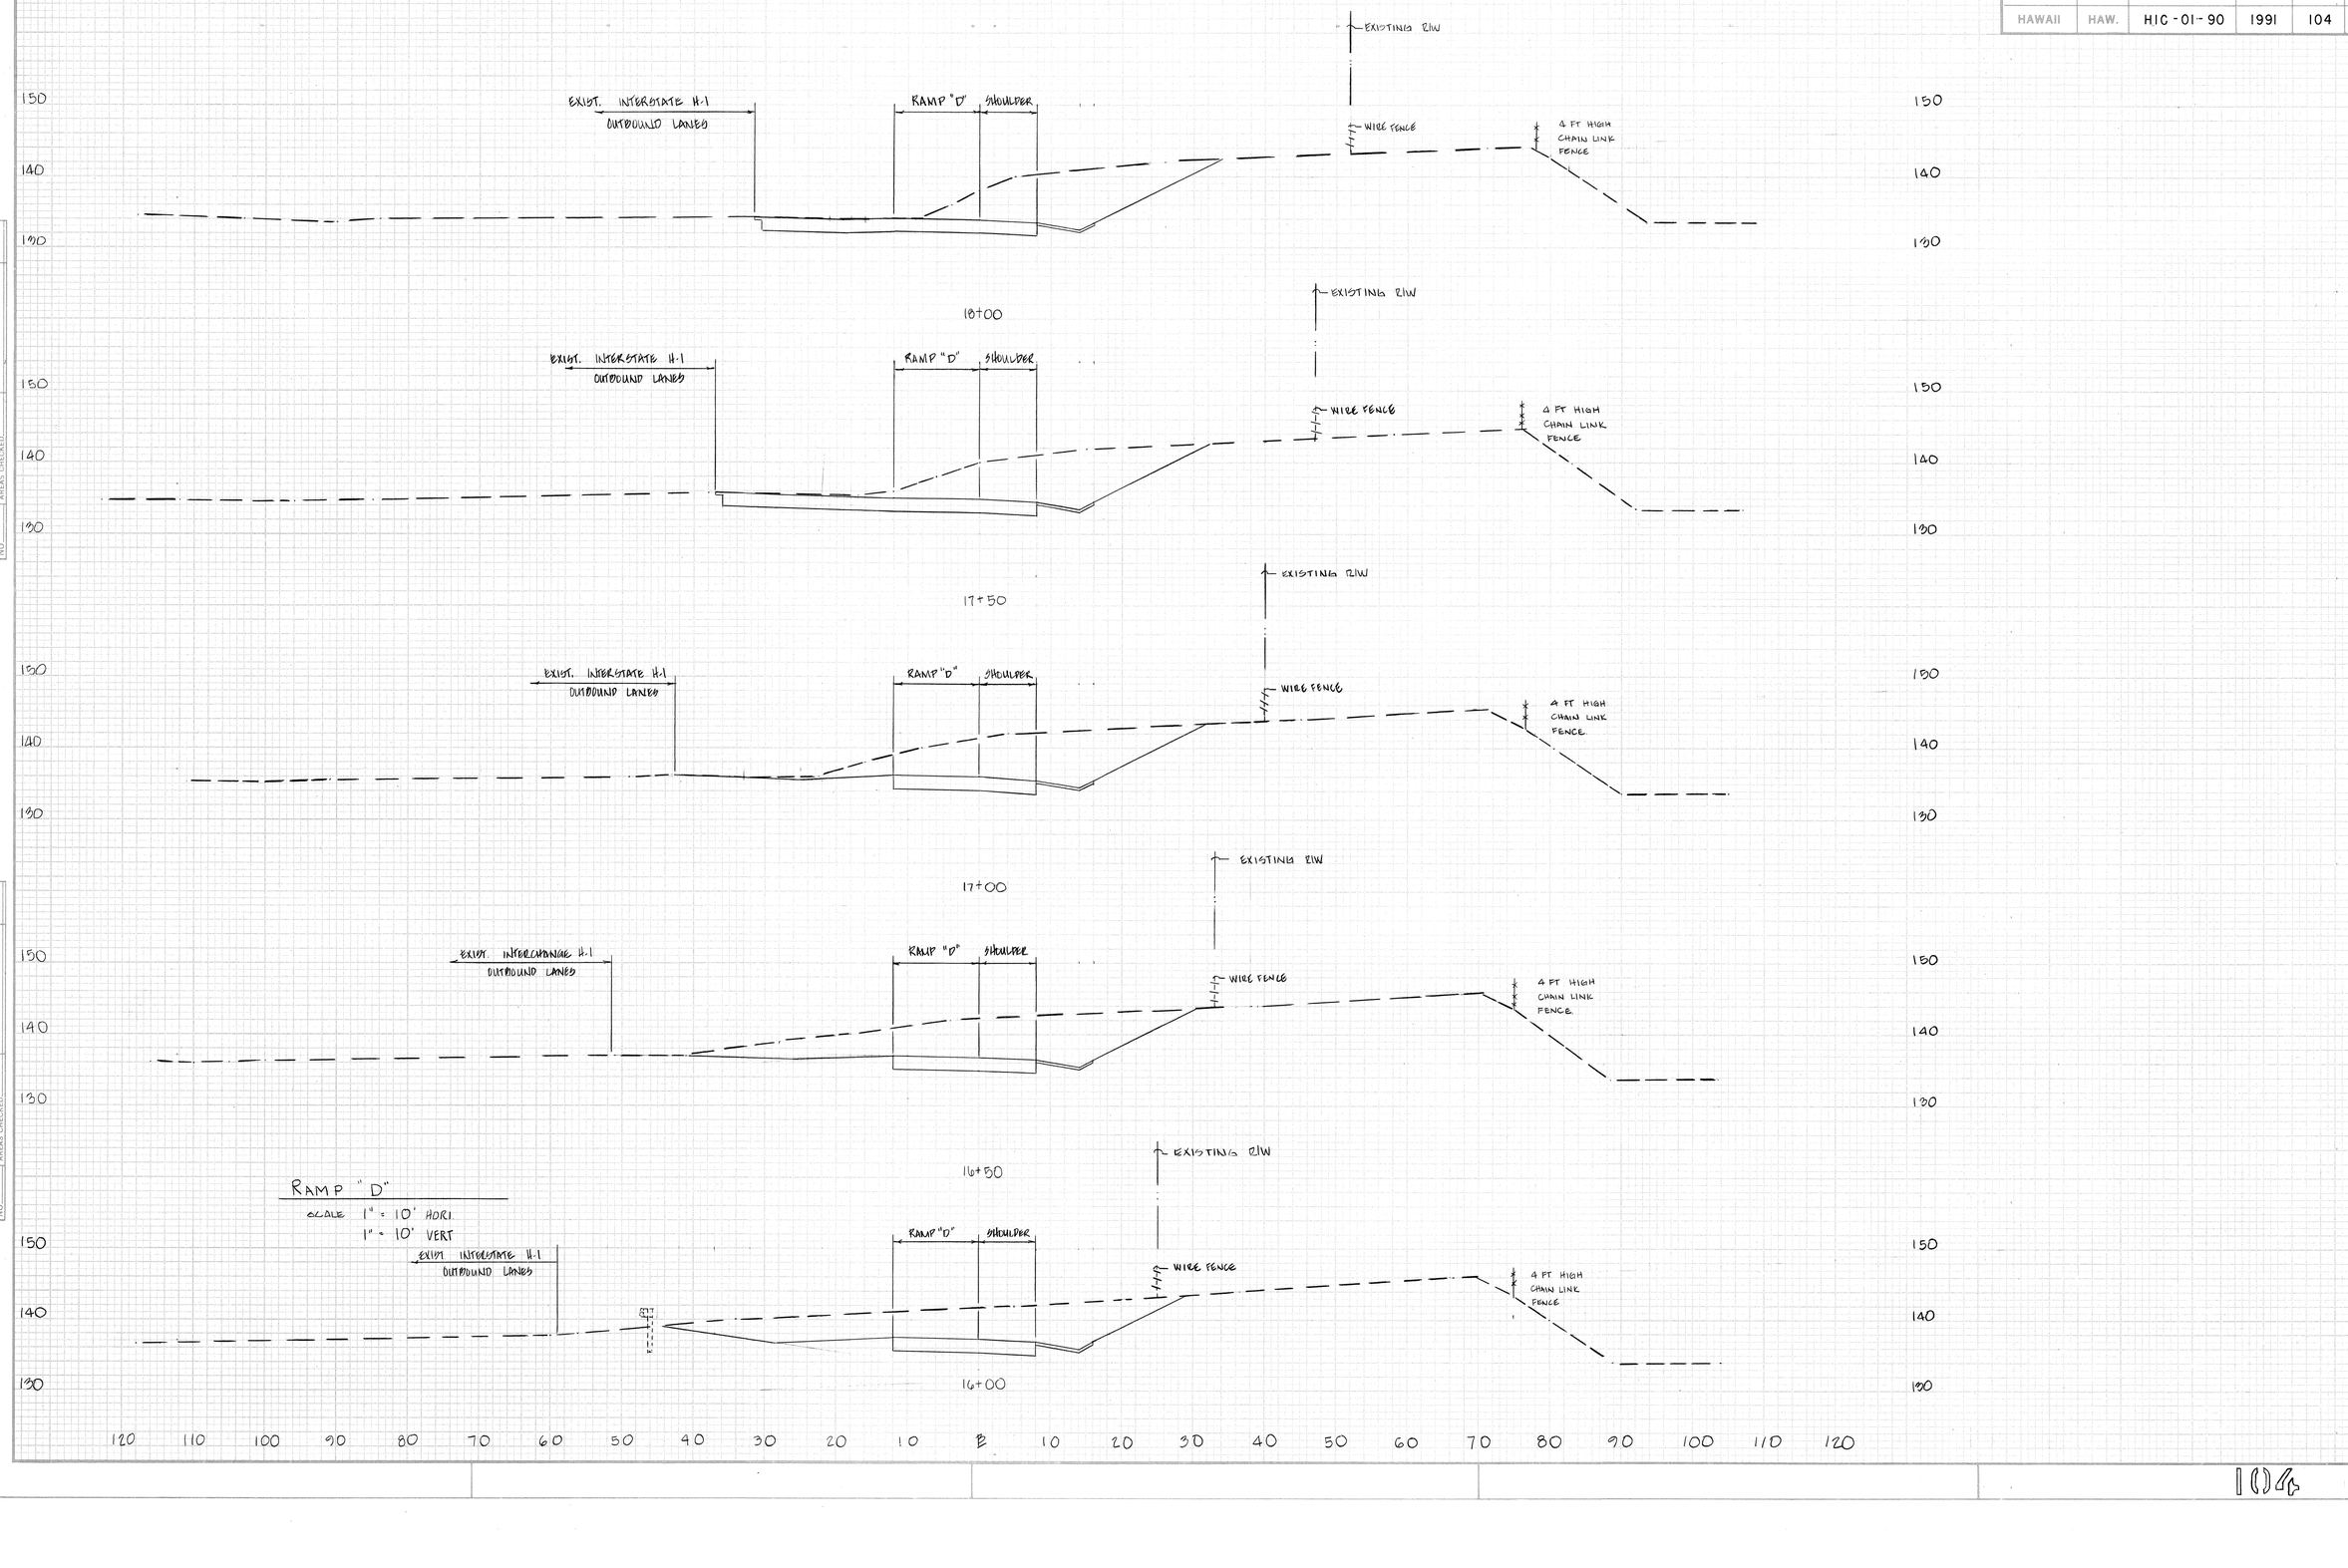


B4732

| FED. ROAD DIST. NO. | STATE | FED. AID PROJ. NO. | FISCAL YEAR | SHEET NO. | TOTAL SHEETS |
|---|---|---|---|---|---|
| HAWAII | HAW. | HIC-01-90 | 1991 | 105 | 109 |

FINAL SURVEY — NOTE BOOK — NO. — SURVEYED — PLOTTED — TEMPLATE — AREAS — CROSS CHECKED — BY — DATE

ORIGINAL SURVEY — NOTE BOOK — NO. — SURVEYED — PLOTTED — TEMPLATE — AREAS — CROSS CHECKED — BY — DATE

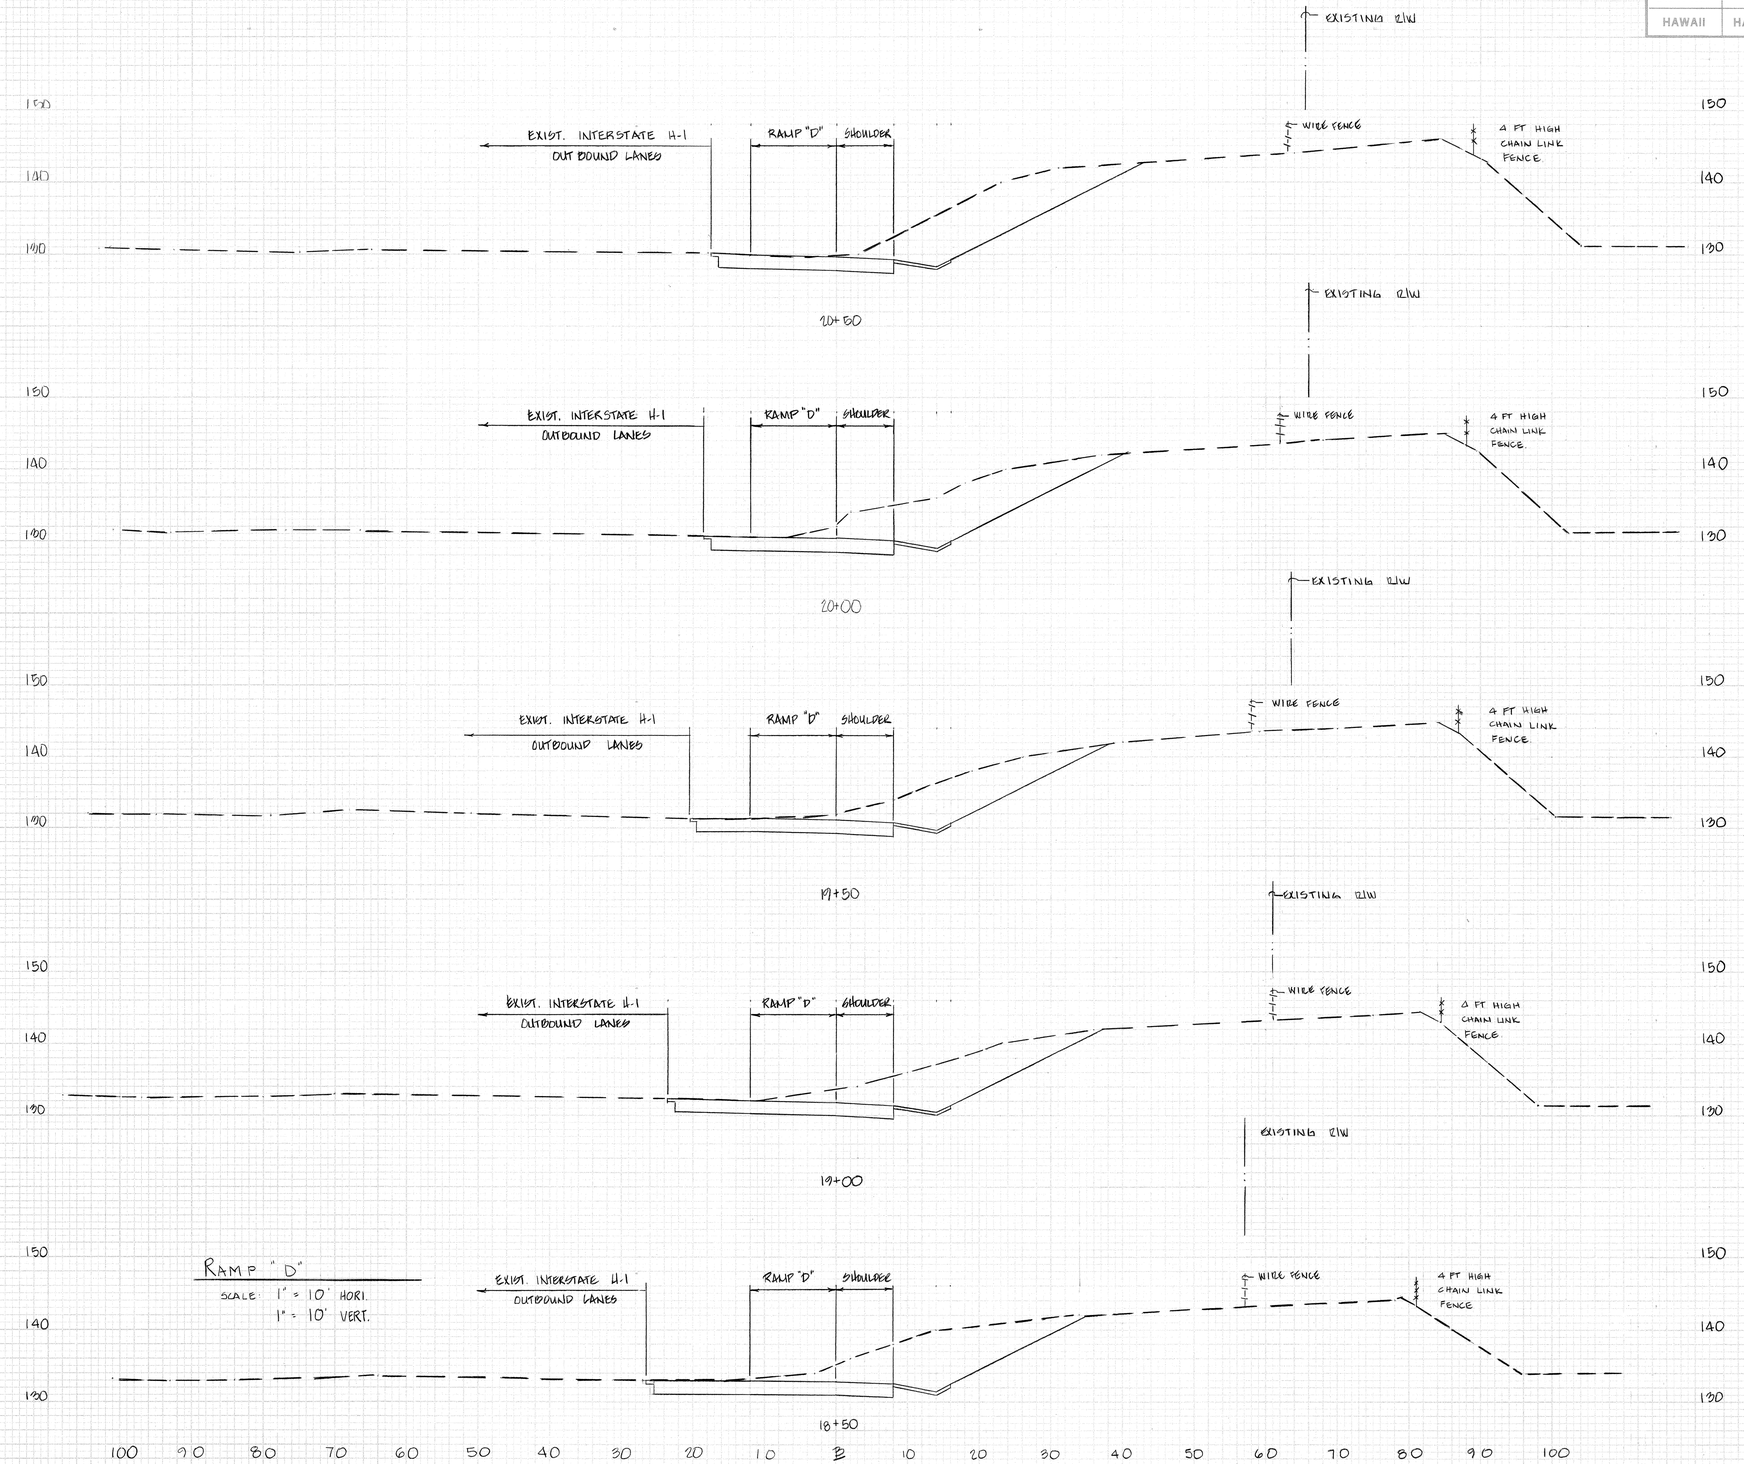


84732

| FED. ROAD DIST. NO. | STATE | FED. AID PROJ. NO. | FISCAL YEAR | SHEET NO. | TOTAL SHEETS |
|---|---|---|---|---|---|
| HAWAII | HAW. | HIC-01-90 | 1991 | 106 | 109 |

FINAL SURVEY — NOTE BOOK — NO. — SURVEYED — PLOTTED — TEMPLATE — AREAS — AREAS CHECKED — BY — DATE

ORIGINAL SURVEY — NOTE BOOK — NO. — SURVEYED — PLOTTED — TEMPLATE — AREAS — AREAS CHECKED — BY — DATE

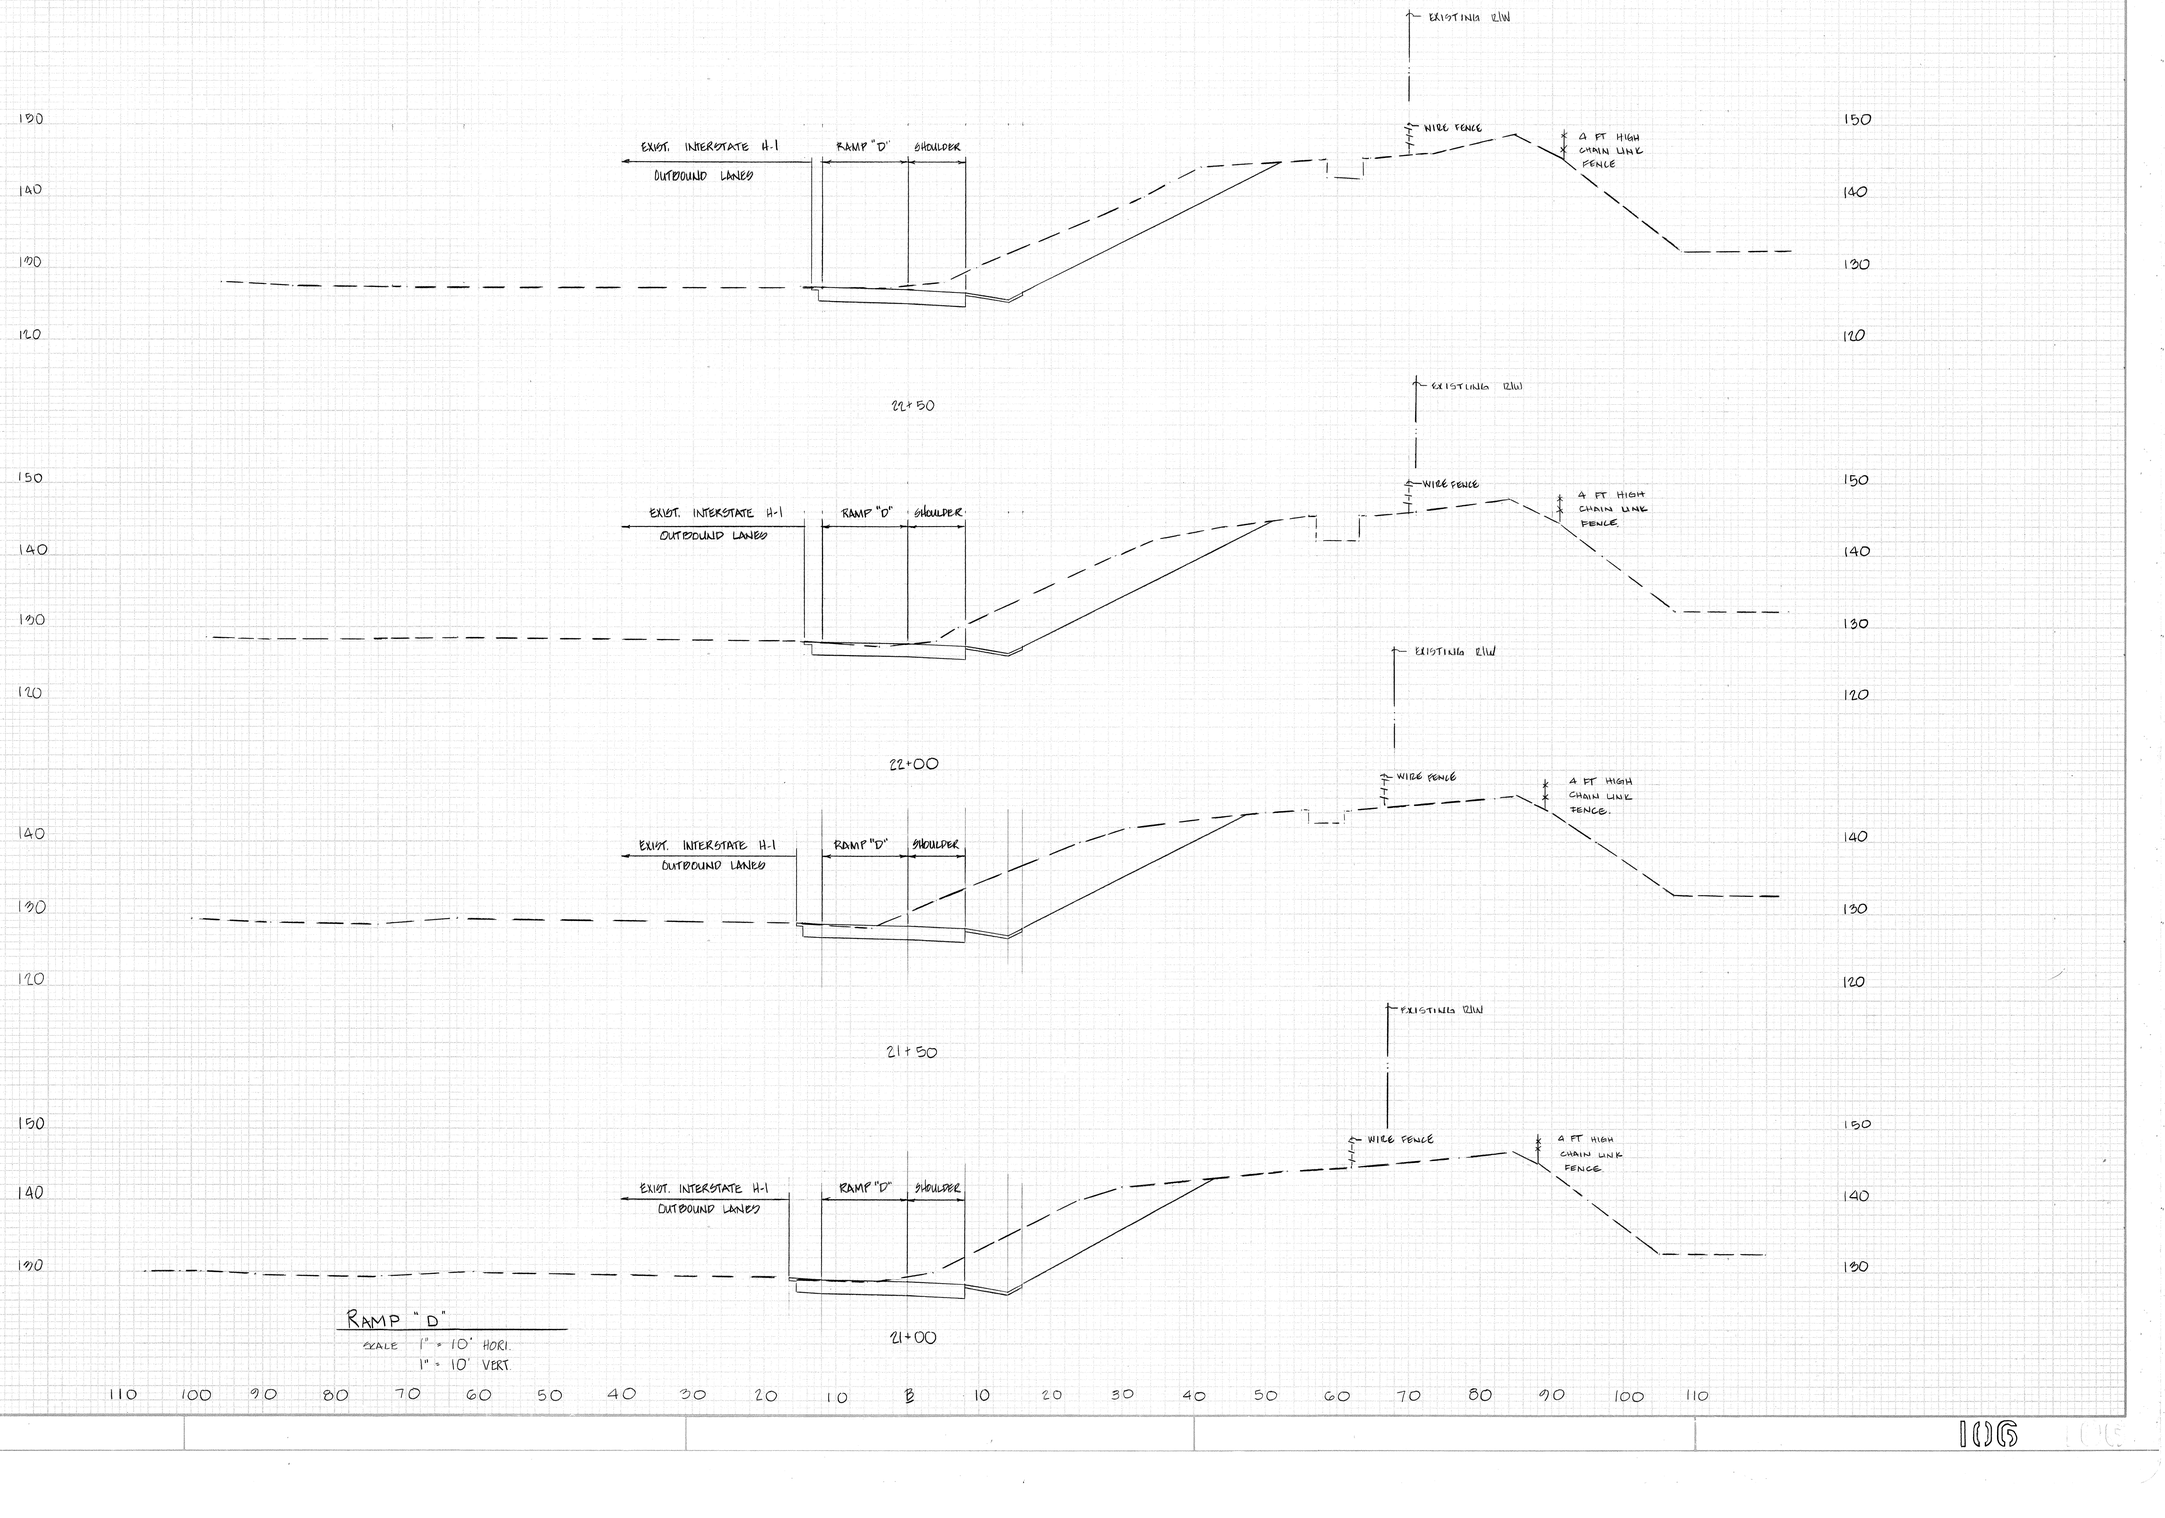



106

84732

| FED. ROAD DIST. NO. | STATE | FED. AID PROJ. NO. | FISCAL YEAR | SHEET NO. | TOTAL SHEETS |
|---|---|---|---|---|---|
| HAWAII | HAW. | HIC - 01 - 90 | 1991 | 107 | 109 |

FINAL SURVEY — NOTE BOOK — NO. — SURVEYED — PLOTTED — TEMPLATE — AREAS — AREAS CHECKED — BY — DATE

ORIGINAL SURVEY — NOTE BOOK — NO. — SURVEYED — PLOTTED — TEMPLATE — AREAS — AREAS CHECKED — BY — DATE

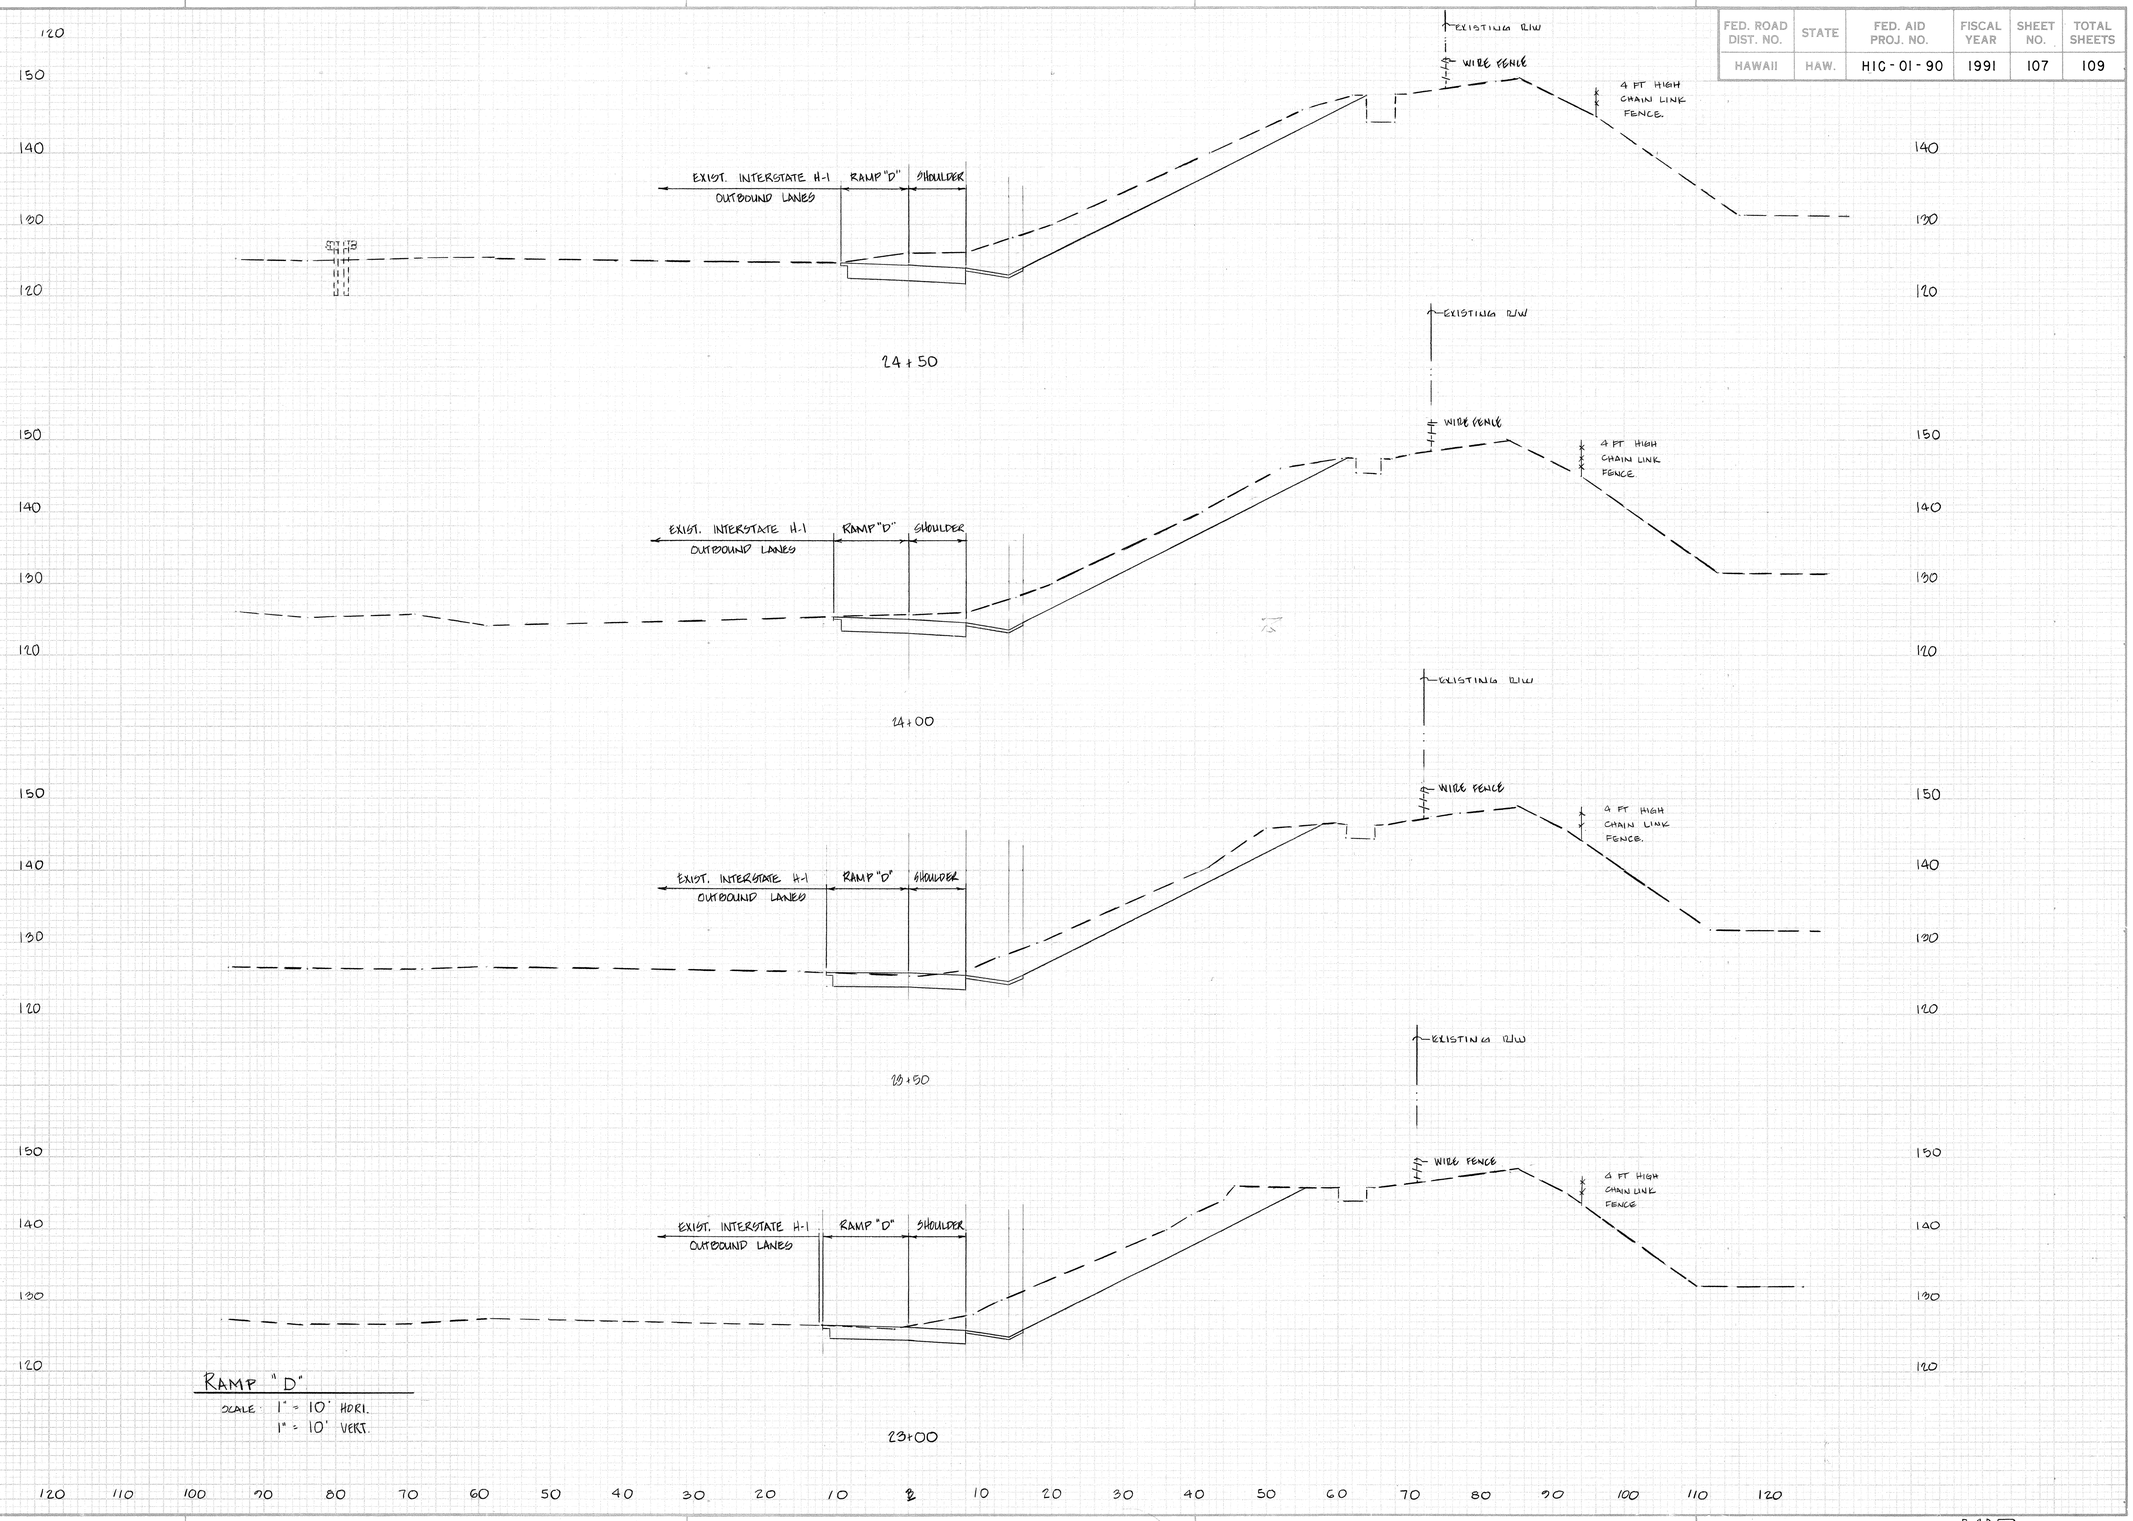


RAMP "D"

SCALE: 1" = 10' HORI.
1" = 10' VERT.

84732

| FED. ROAD DIST. NO. | STATE | FED. AID PROJ. NO. | FISCAL YEAR | SHEET NO. | TOTAL SHEETS |
|---|---|---|---|---|---|
| HAWAII | HAW. | HIC - 01 - 90 | 1991 | 108 | 109 |

| FINAL SURVEY | SURVEYED | BY | DATE |
|---|---|---|---|
| | PLOTTED | | |
| NOTE BOOK | TEMPLATE | | |
| NO. | AREAS | | |
| | AREAS CHECKED | | |

| ORIGINAL SURVEY | SURVEYED | BY | DATE |
|---|---|---|---|
| | PLOTTED | | |
| NOTE BOOK | TEMPLATE | | |
| NO. | AREAS | | |
| | AREAS CHECKED | | |




RAMP "D"

SCALE 1" = 10' HORI.
1" = 10' VERT.

84732

| FED. ROAD DIST. NO. | STATE | FED. AID PROJ. NO. | FISCAL YEAR | SHEET NO. | TOTAL SHEETS |
|---|---|---|---|---|---|
| HAWAII | HAW. | HIC-01-90 | 1991 | 109 | 109 |

FINAL SURVEY — NOTE BOOK — NO. — SURVEYED — PLOTTED — TEMPLATE — AREAS — AREAS CHECKED — BY — DATE

ORIGINAL SURVEY — NOTE BOOK — NO. — SURVEYED — PLOTTED — TEMPLATE — AREAS — AREAS CHECKED — BY — DATE

