FED. ROAD DIST. NO.	STATE	PROJ. NO.	FISCAL YEAR	SHEET NO.	TOTAL SHEETS
HAWAII	HAW.	H1I-01-97M	1997	1	6

INDEX TO DRAWINGS	
SHEET NO.	DESCRIPTION
1	TITLE SHEET
2	STANDARD PLANS SUMMARY
3	GENERAL NOTES
4	TYPICAL CONCRETE AND JOINT SEAL REPAIRS
5	REHABILITATION AND BRIDGE DETAILS
6	PLAN, TYPICAL SECTION & LEGEND

STATE OF HAWAII

DEPARTMENT OF TRANSPORTATION

HIGHWAYS DIVISION

HONOLULU, HAWAII

"AS-BUILT"

PLANS FOR

INTERSTATE ROUTE H-1
KEEAUMOKU STREET SEPARATION

REPAIR EXPANSION JOINTS AND RESURFACE DECK

PROJECT NO. H1I-01-97M

DISTRICT OF HONOLULU

ISLAND OF OAHU

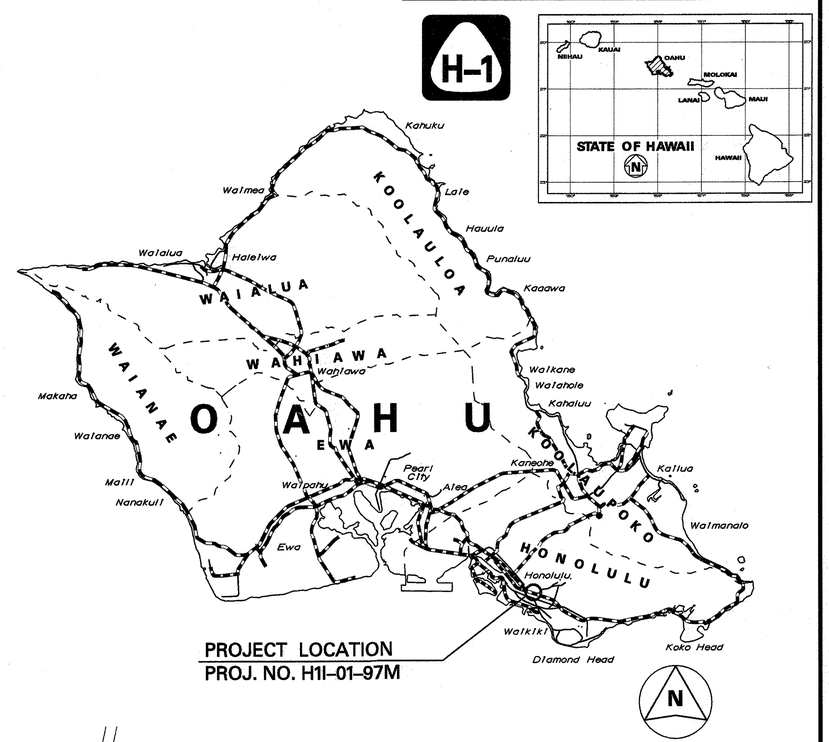

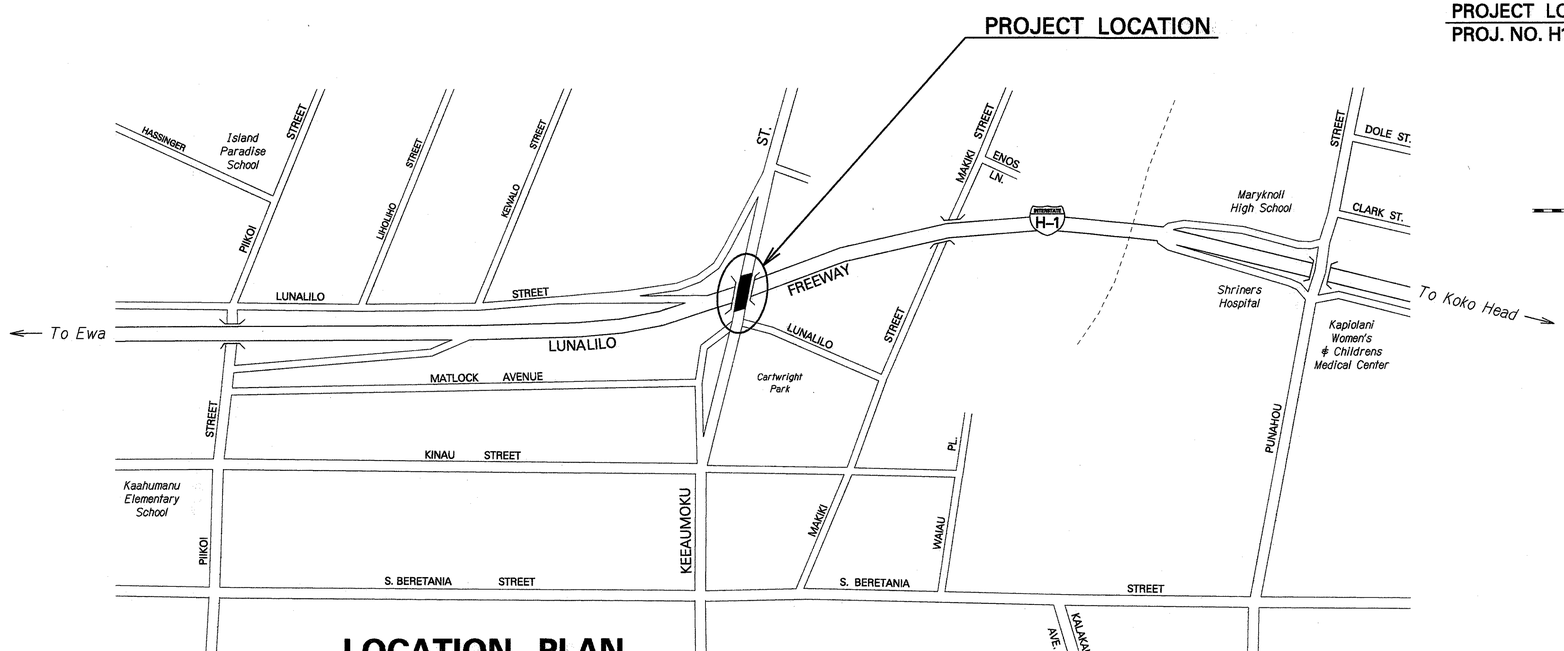

LOCATION PLAN

FEDERAL AID PROJECTS PREVIOUSLY CONSTRUCTED OR UNDER CONSTRUCTION

MILE POST 23.40

CHANGES MADE DURING CONSTRUCTION HAVE BEEN INCORPORATED ON THESE PLANS EXCEPT CHANGES IN THE ORIGINAL THEORETICAL QUANTITIES. FOR ACTUAL QUANTITIES, REFER TO PROJECT LEDGER AND/OR COMPUTATION BOOK.

RESIDENT ENGINEER — DATE 12/6/01

DEPARTMENT OF TRANSPORTATION STATE OF HAWAII	
APPROVED:	
DIR. OF TRANSPORTATION	DATE 5/13/97

HWY-DB DESIGNED BY	R. HIRONAKA P. S. & E. BY	587-2250 PHONE	NOV., 1996 DATE

hlkeeksh.dgn logfile jason 14-25-97