FED. ROAD DIST. NO.	STATE	PROJ. NO.	FISCAL YEAR	SHEET NO.	TOTAL SHEETS
HAWAII	HAW.	H1E-01-98	1998	C.O. 7	13

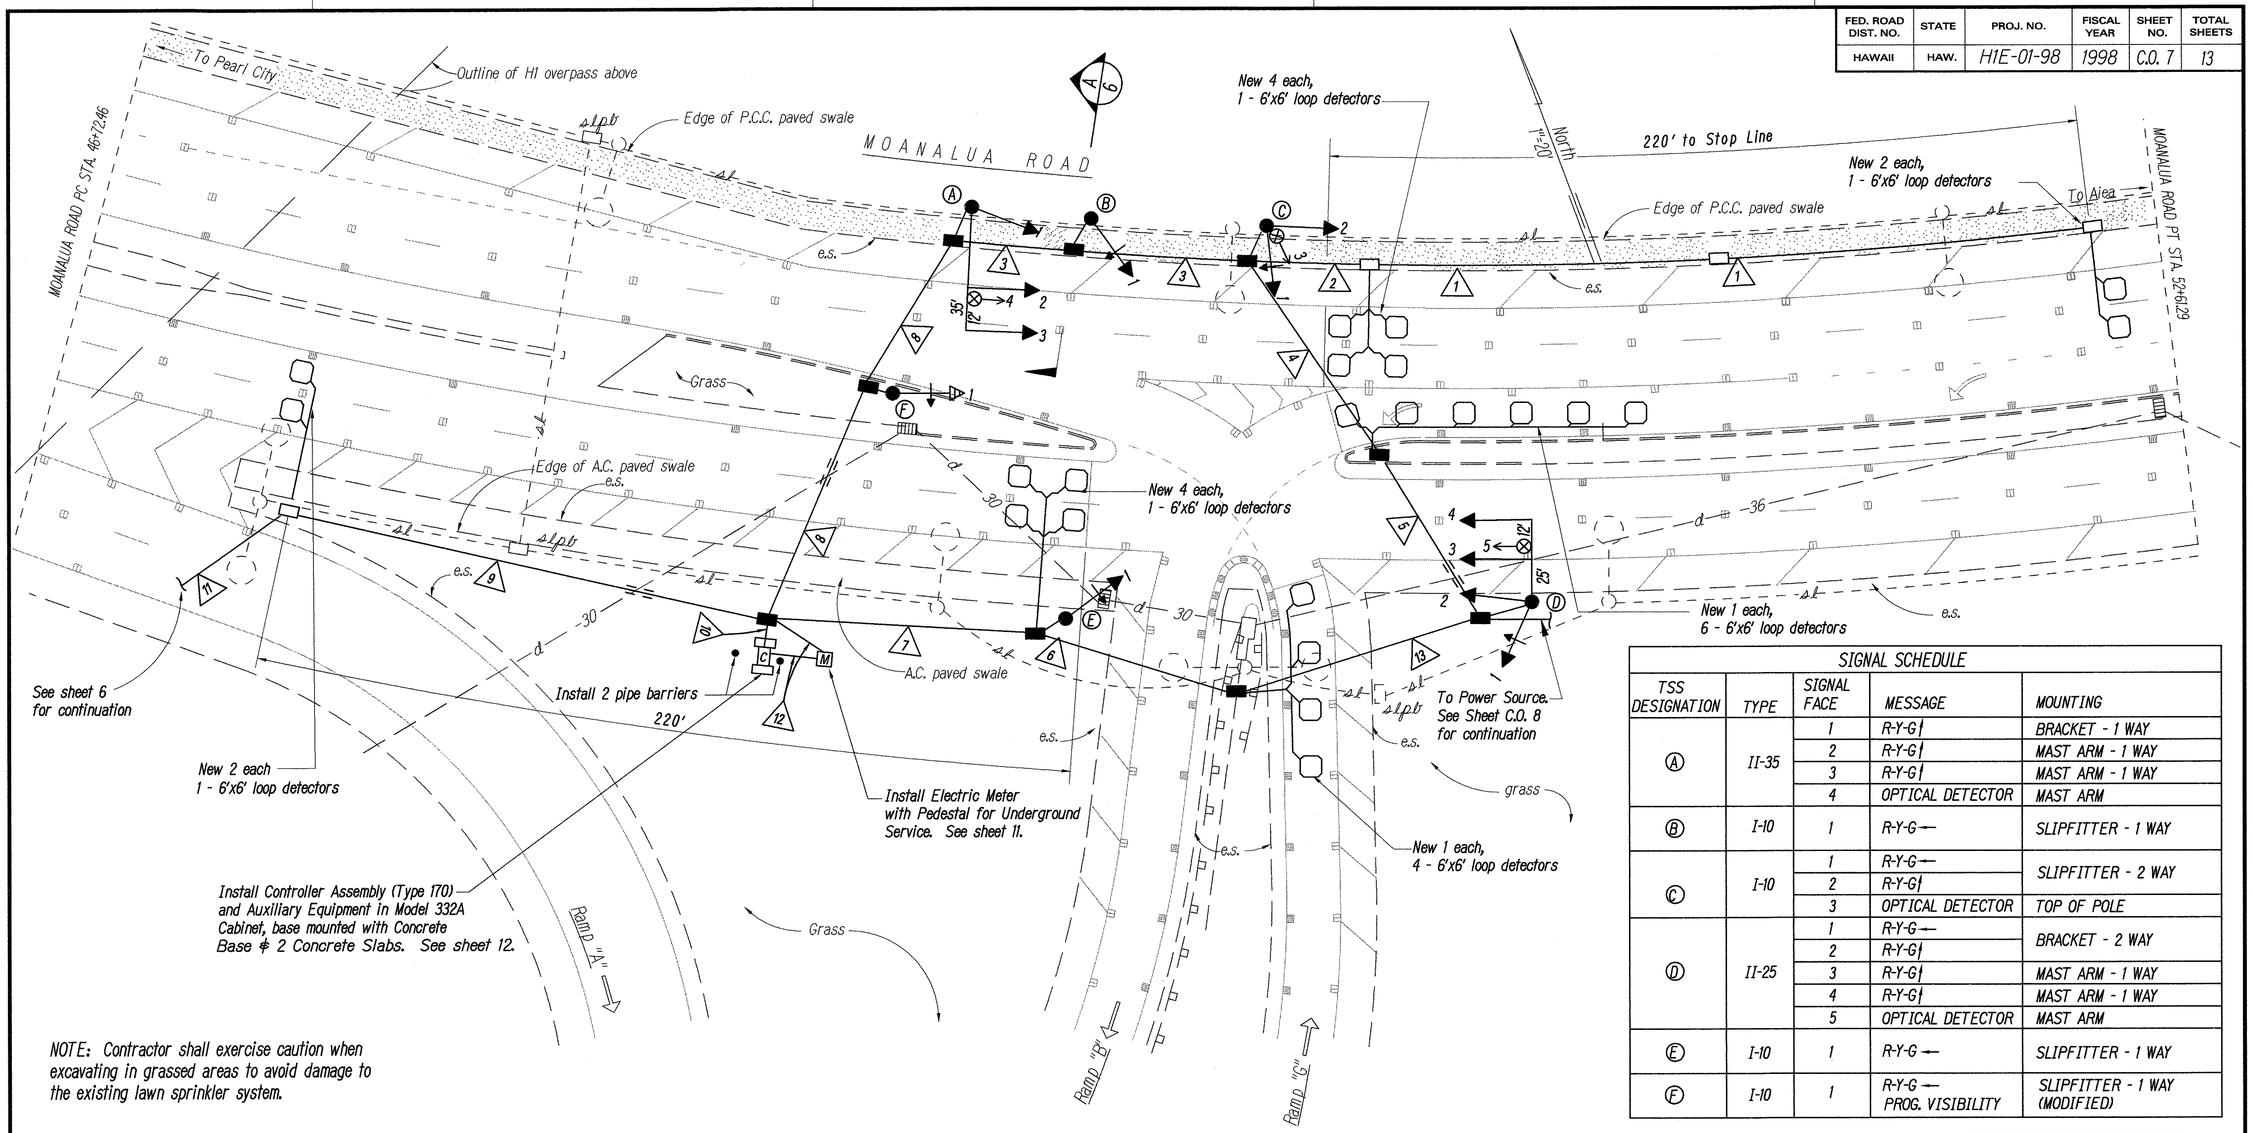

NOTE: Contractor shall exercise caution when excavating in grassed areas to avoid damage to the existing lawn sprinkler system.

INTERSECTION OF MOANALUA ROAD AND RAMPS "B" AND "G"

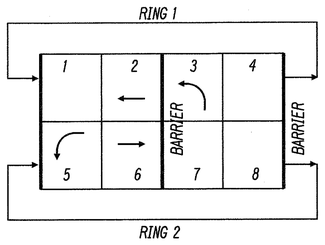

SIGNAL SCHEDULE

TSS DESIGNATION	TYPE	SIGNAL FACE	MESSAGE	MOUNTING
Ⓐ	II-35	1	R-Y-G	BRACKET - 1 WAY
		2	R-Y-G	MAST ARM - 1 WAY
		3	R-Y-G	MAST ARM - 1 WAY
		4	OPTICAL DETECTOR	MAST ARM
Ⓑ	I-10	1	R-Y-G	SLIPFITTER - 1 WAY
Ⓒ	I-10	1	R-Y-G	SLIPFITTER - 2 WAY
		2	R-Y-G	
		3	OPTICAL DETECTOR	TOP OF POLE
Ⓓ	II-25	1	R-Y-G	BRACKET - 2 WAY
		2	R-Y-G	
		3	R-Y-G	MAST ARM - 1 WAY
		4	R-Y-G	MAST ARM - 1 WAY
		5	OPTICAL DETECTOR	MAST ARM
Ⓔ	I-10	1	R-Y-G	SLIPFITTER - 1 WAY
Ⓕ	I-10	1	R-Y-G PROG. VISIBILITY	SLIPFITTER - 1 WAY (MODIFIED)

DATE	REVISION
8/20/98	COMPLETELY REDESIGNED POWER SUPPLY LINE FROM INTERSECTION TO NEW POWER SOURCE AT EXISTING POLE NO. 109.

ORIGINAL PLAN | NOTE BOOK No. | SURVEY PLOTTED BY | DRAWN BY | TRACED BY | DESIGNED BY | QUANTITIES BY | CHECKED BY | DATE

PAUL T. TANI GIGHT — LICENSED PROFESSIONAL ENGINEER NO. 8844-C — HAWAII, U.S.A.

THIS WORK WAS DONE BY ME OR UNDER MY SUPERVISION

STATE OF HAWAII
DEPARTMENT OF TRANSPORTATION
HIGHWAYS DIVISION

TRAFFIC SIGNAL PLAN

INTERSTATE ROUTE H-1, WAIAU I.C.

Traffic Signals at Moanalua Road

PROJECT NO. H1E-01-98

Scale: 1" = 20' Date: Nov., 1997

SHEET No. 3 OF 8 SHEETS

C. O. 7