FED. ROAD DIST. NO.	STATE	PROJ. NO.	FISCAL YEAR	SHEET NO.	TOTAL SHEETS
HAWAII	HAW.	PMT-H1C-01-97			

INDEX TO DRAWINGS

SHEET NO.	DESCRIPTION
1	TITLE SHEET
2	STANDARD PLANS SUMMARY
3 - 4a	NOTES
5	TYPICAL SECTIONS
6 & 6a	PLAN AND PROFILES
7	DRAINAGE DETAILS
8 - 23	BRIDGE PLANS
24 - 36	TRAFFIC CONTROLS
37 - 49	ELECTRICAL PLANS

PLAN SHT. NO. 48 S-1 SHEET TO THIS PROJECT.

TOTAL SHEET COUNT AFTER "AS-BUILT" POSTINGS. 50 SHEETS.

STATE OF HAWAII

DEPARTMENT OF TRANSPORTATION

HIGHWAYS DIVISION

HONOLULU, HAWAII

"AS-BUILT"

PLANS FOR

CONSTRUCTION OF

MANAGER'S DRIVE BRIDGE WIDENING
INTERSTATE ROUTE H-1

DISTRICT OF EWA

ISLAND OF OAHU

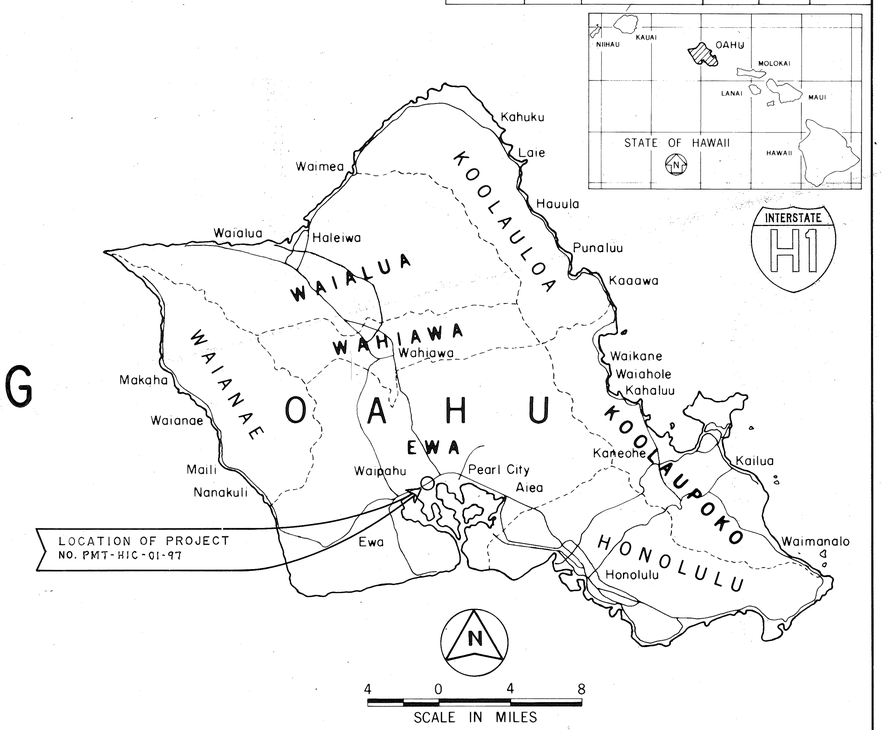

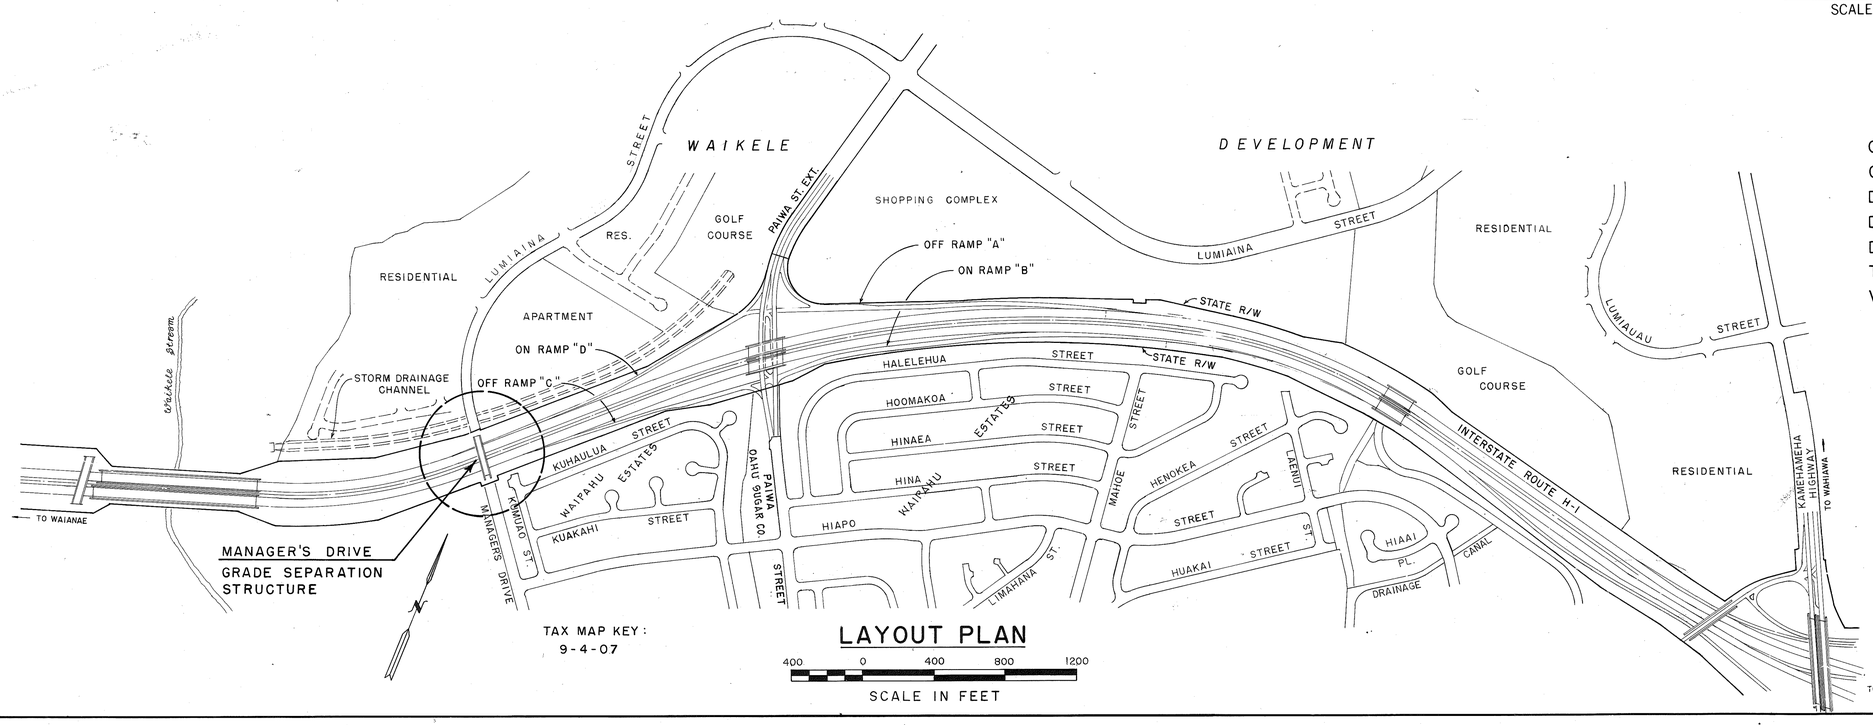

TAX MAP KEY:
9-4-07

LAYOUT PLAN

DESIGN DESIGNATION

CONTROL OF ACCESS - FULL

CURRENT ADT 51,600 (1984)

DESIGN ADT 80,000 (1995)

DHV 8,800

D . . . . . 65 %

T . . . . . 3 %

V 70

APPROVED:

Charles S. Yonamine Aug 13, 97

ADMINISTRATOR, HIGHWAYS DIVISION DATE
STATE DEPARTMENT OF TRANSPORTATION (APPROVAL GRANTED FOR WORK WITHIN STATE RIGHT-OF-WAY ONLY. ID NO. 0-92-20 LETTER OF APPROVAL NO. HWY-CM 2-6507 DATED 9/29/97.

COMMUNITY PLANNING, INC. DESIGNED BY | P. S. & E. BY | PHONE | DATE

MANAGER'S DRIVE BRIDGE WIDENING