FED. ROAD DIST. NO.	STATE	PROJ. NO.	FISCAL YEAR	SHEET NO.	TOTAL SHEETS
HAWAII	HAWAII	H1A-01-02M	2003	C.O. 9	88

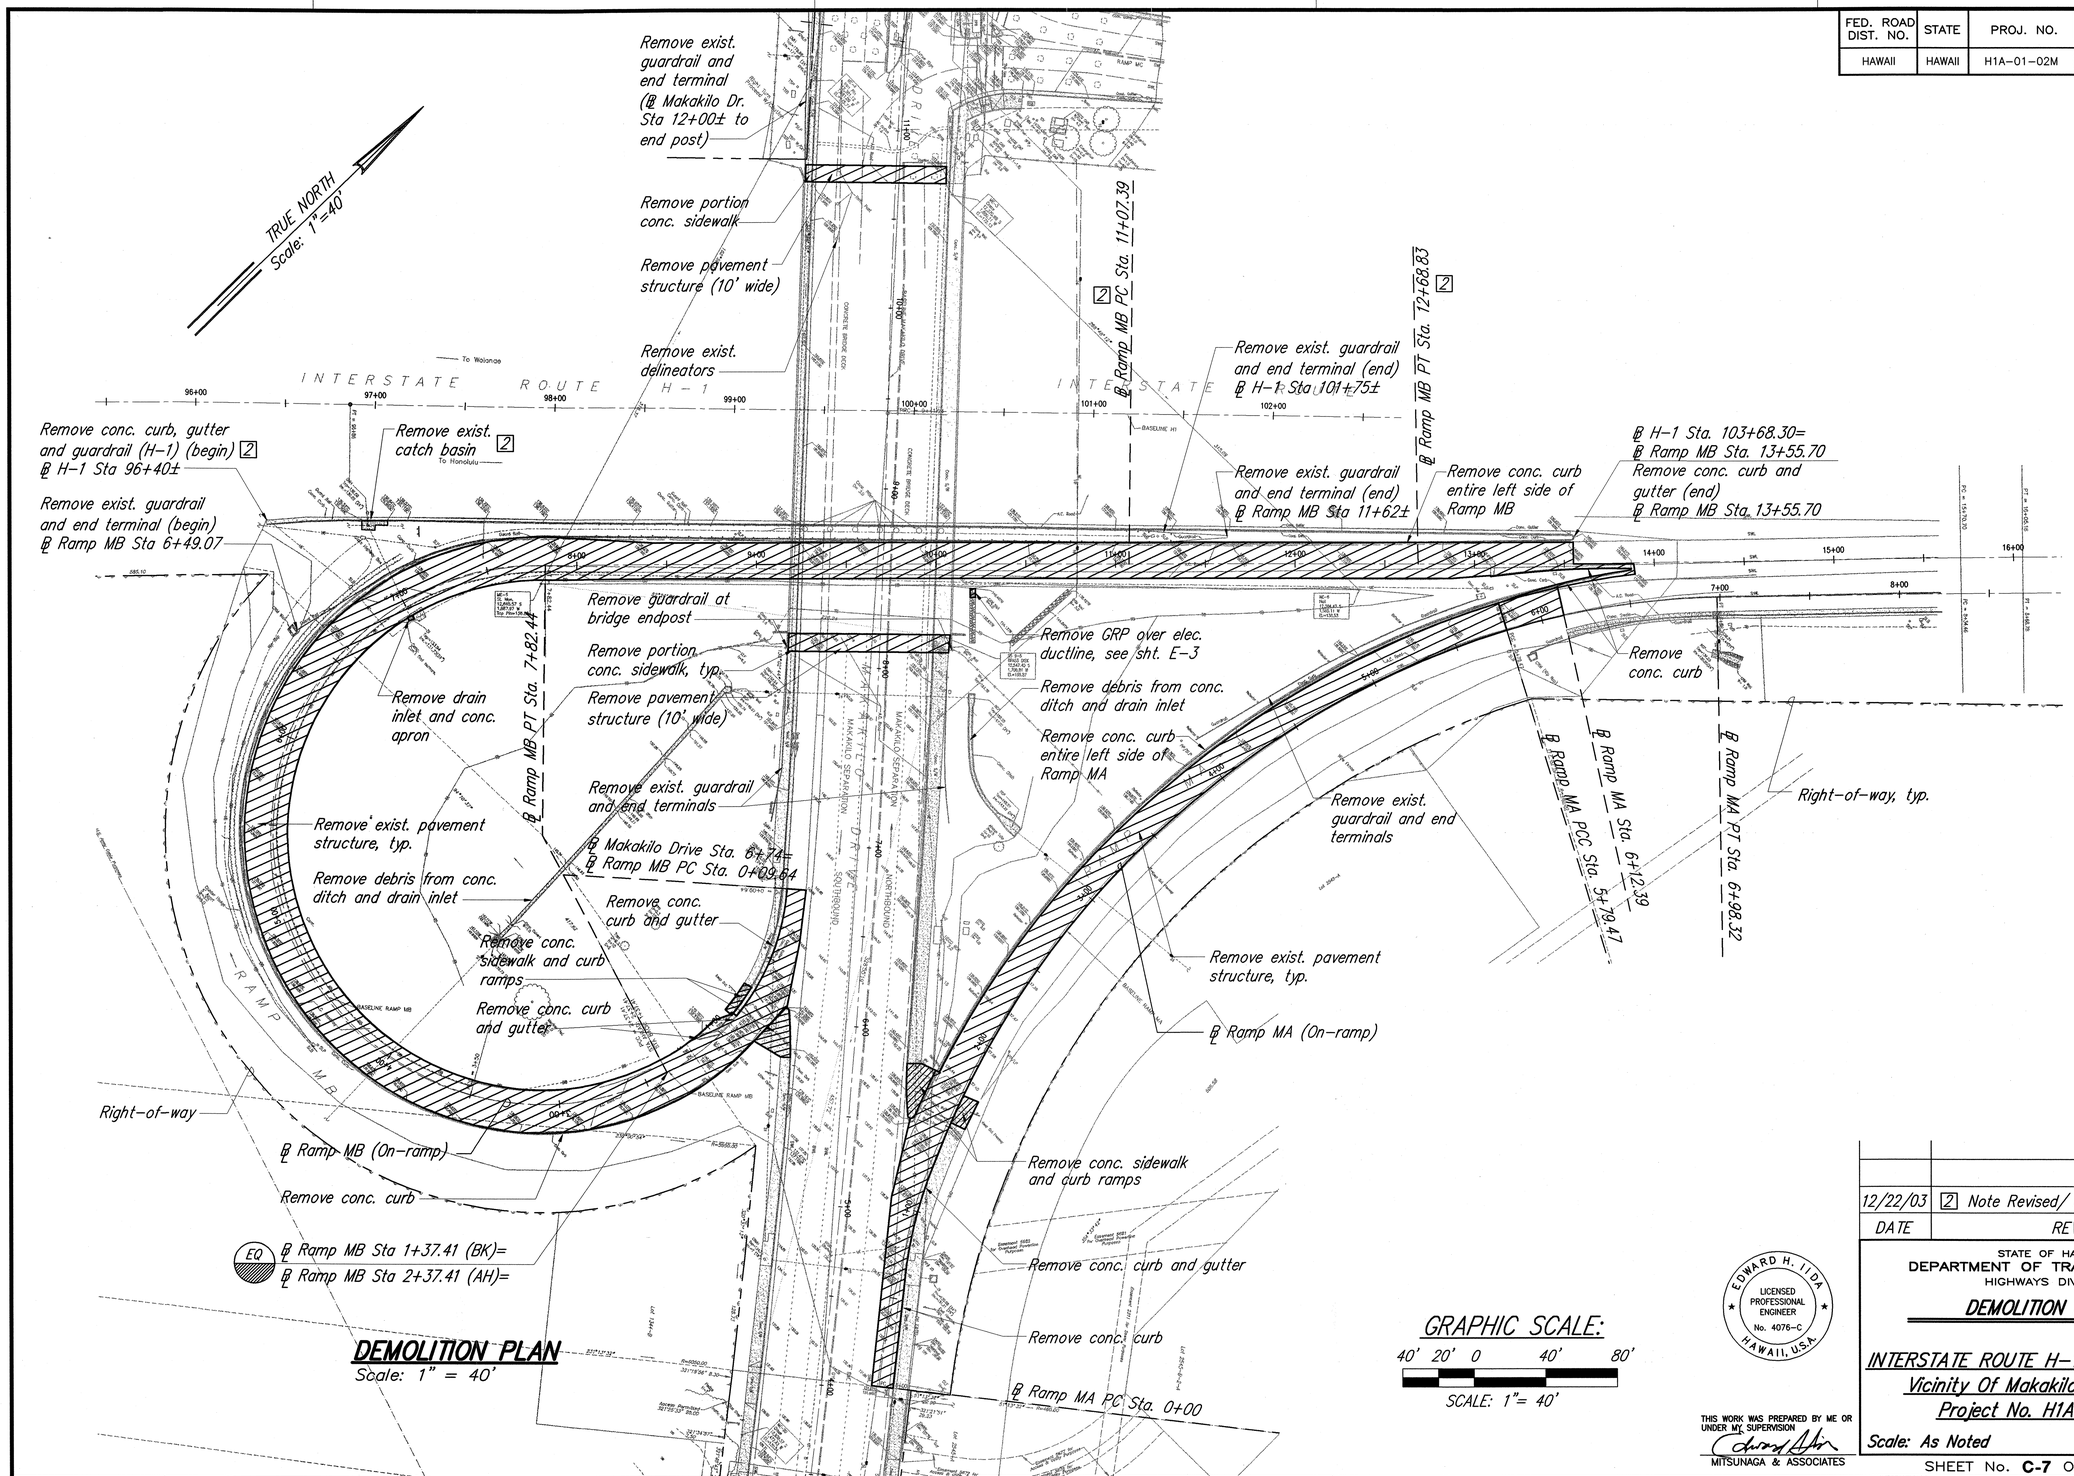

DEMOLITION PLAN
Scale: 1" = 40'

12/22/03	2 Note Revised/ Demolish Catch Basin
DATE	REVISION

STATE OF HAWAII
DEPARTMENT OF TRANSPORTATION
HIGHWAYS DIVISION

DEMOLITION PLAN

INTERSTATE ROUTE H-1 REHABILITATION
Vicinity Of Makakilo Interchange
Project No. H1A-01-02M

Scale: As Noted Date: April 2003

SHEET No. C-7 OF 42 SHEETS

EDWARD H. IIDA
LICENSED PROFESSIONAL ENGINEER
No. 4076-C
HAWAII, U.S.A.

THIS WORK WAS PREPARED BY ME OR UNDER MY SUPERVISION
MITSUNAGA & ASSOCIATES

ORIGINAL PLAN			
NOTE BOX	SURVEY PLOTTED BY	S. M.	DATE 1/03
	DRAWN BY	"	1/03
	TRACED BY	"	1/03
	DESIGNED BY	C. MCDONALD	1/03
	QUANTITIES BY	C. MCDONALD	1/03
No.	CHECKED BY	E. IIDA	1/03

C.O. 9