


FED. ROAD DIST. No.	STATE	FED. AID PROJ. No.	FISCAL YEAR	SHEET No.	TOTAL SHEETS
HAWAII	HAW.	80-07C-1(4)			

FINAL SURVEY	DATE
BY	
NOTED	
NO.	

ORIGINAL SURVEY	DATE
BY	
NOTED	
NO.	

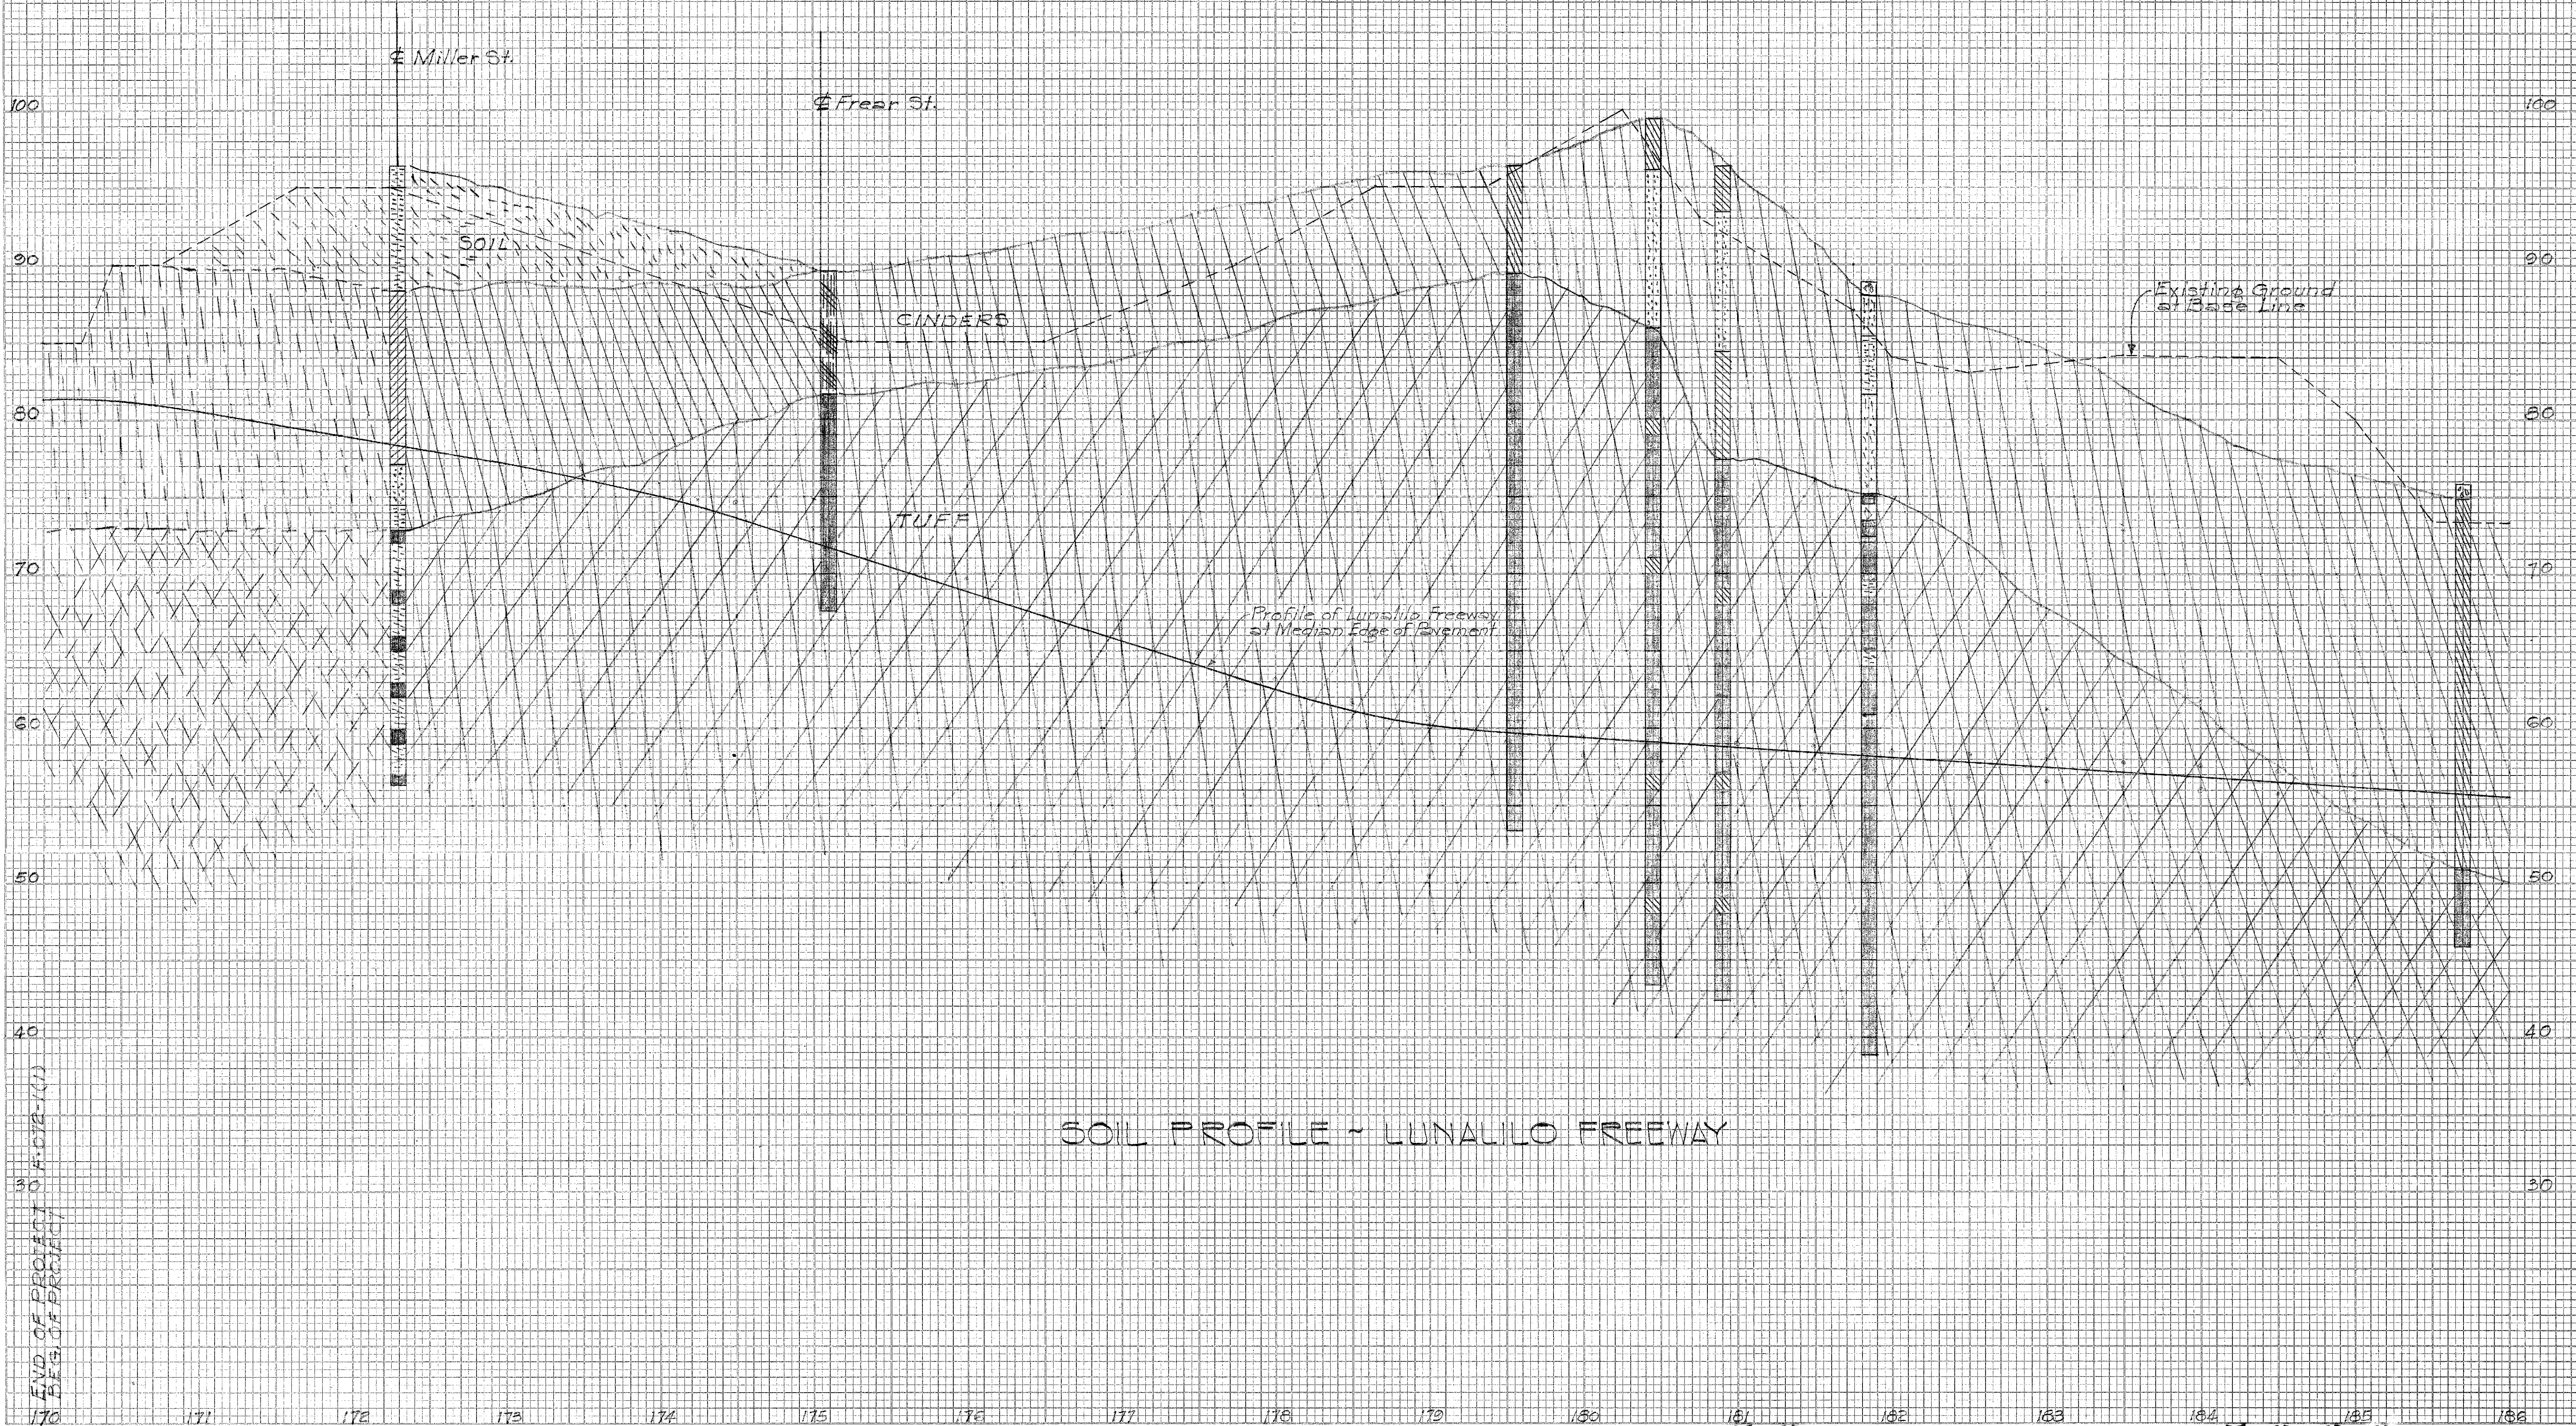


SOIL PROFILE - LUNALILO FREEWAY

END OF PROJECT
170 171 172 173 174 175 176 177 178 179 180 181 182 183 184 185 186

FED. ROAD DIST. NO.	STATE	FED. AID PROJ. NO.	FISCAL YEAR	SHEET NO.	TOTAL SHEETS

DATE	BY	FINAL SURVEY PLOTTED	REVISIONS	NO.

DATE	BY	ORIGINAL SURVEY PLOTTED	REVISIONS	NO.

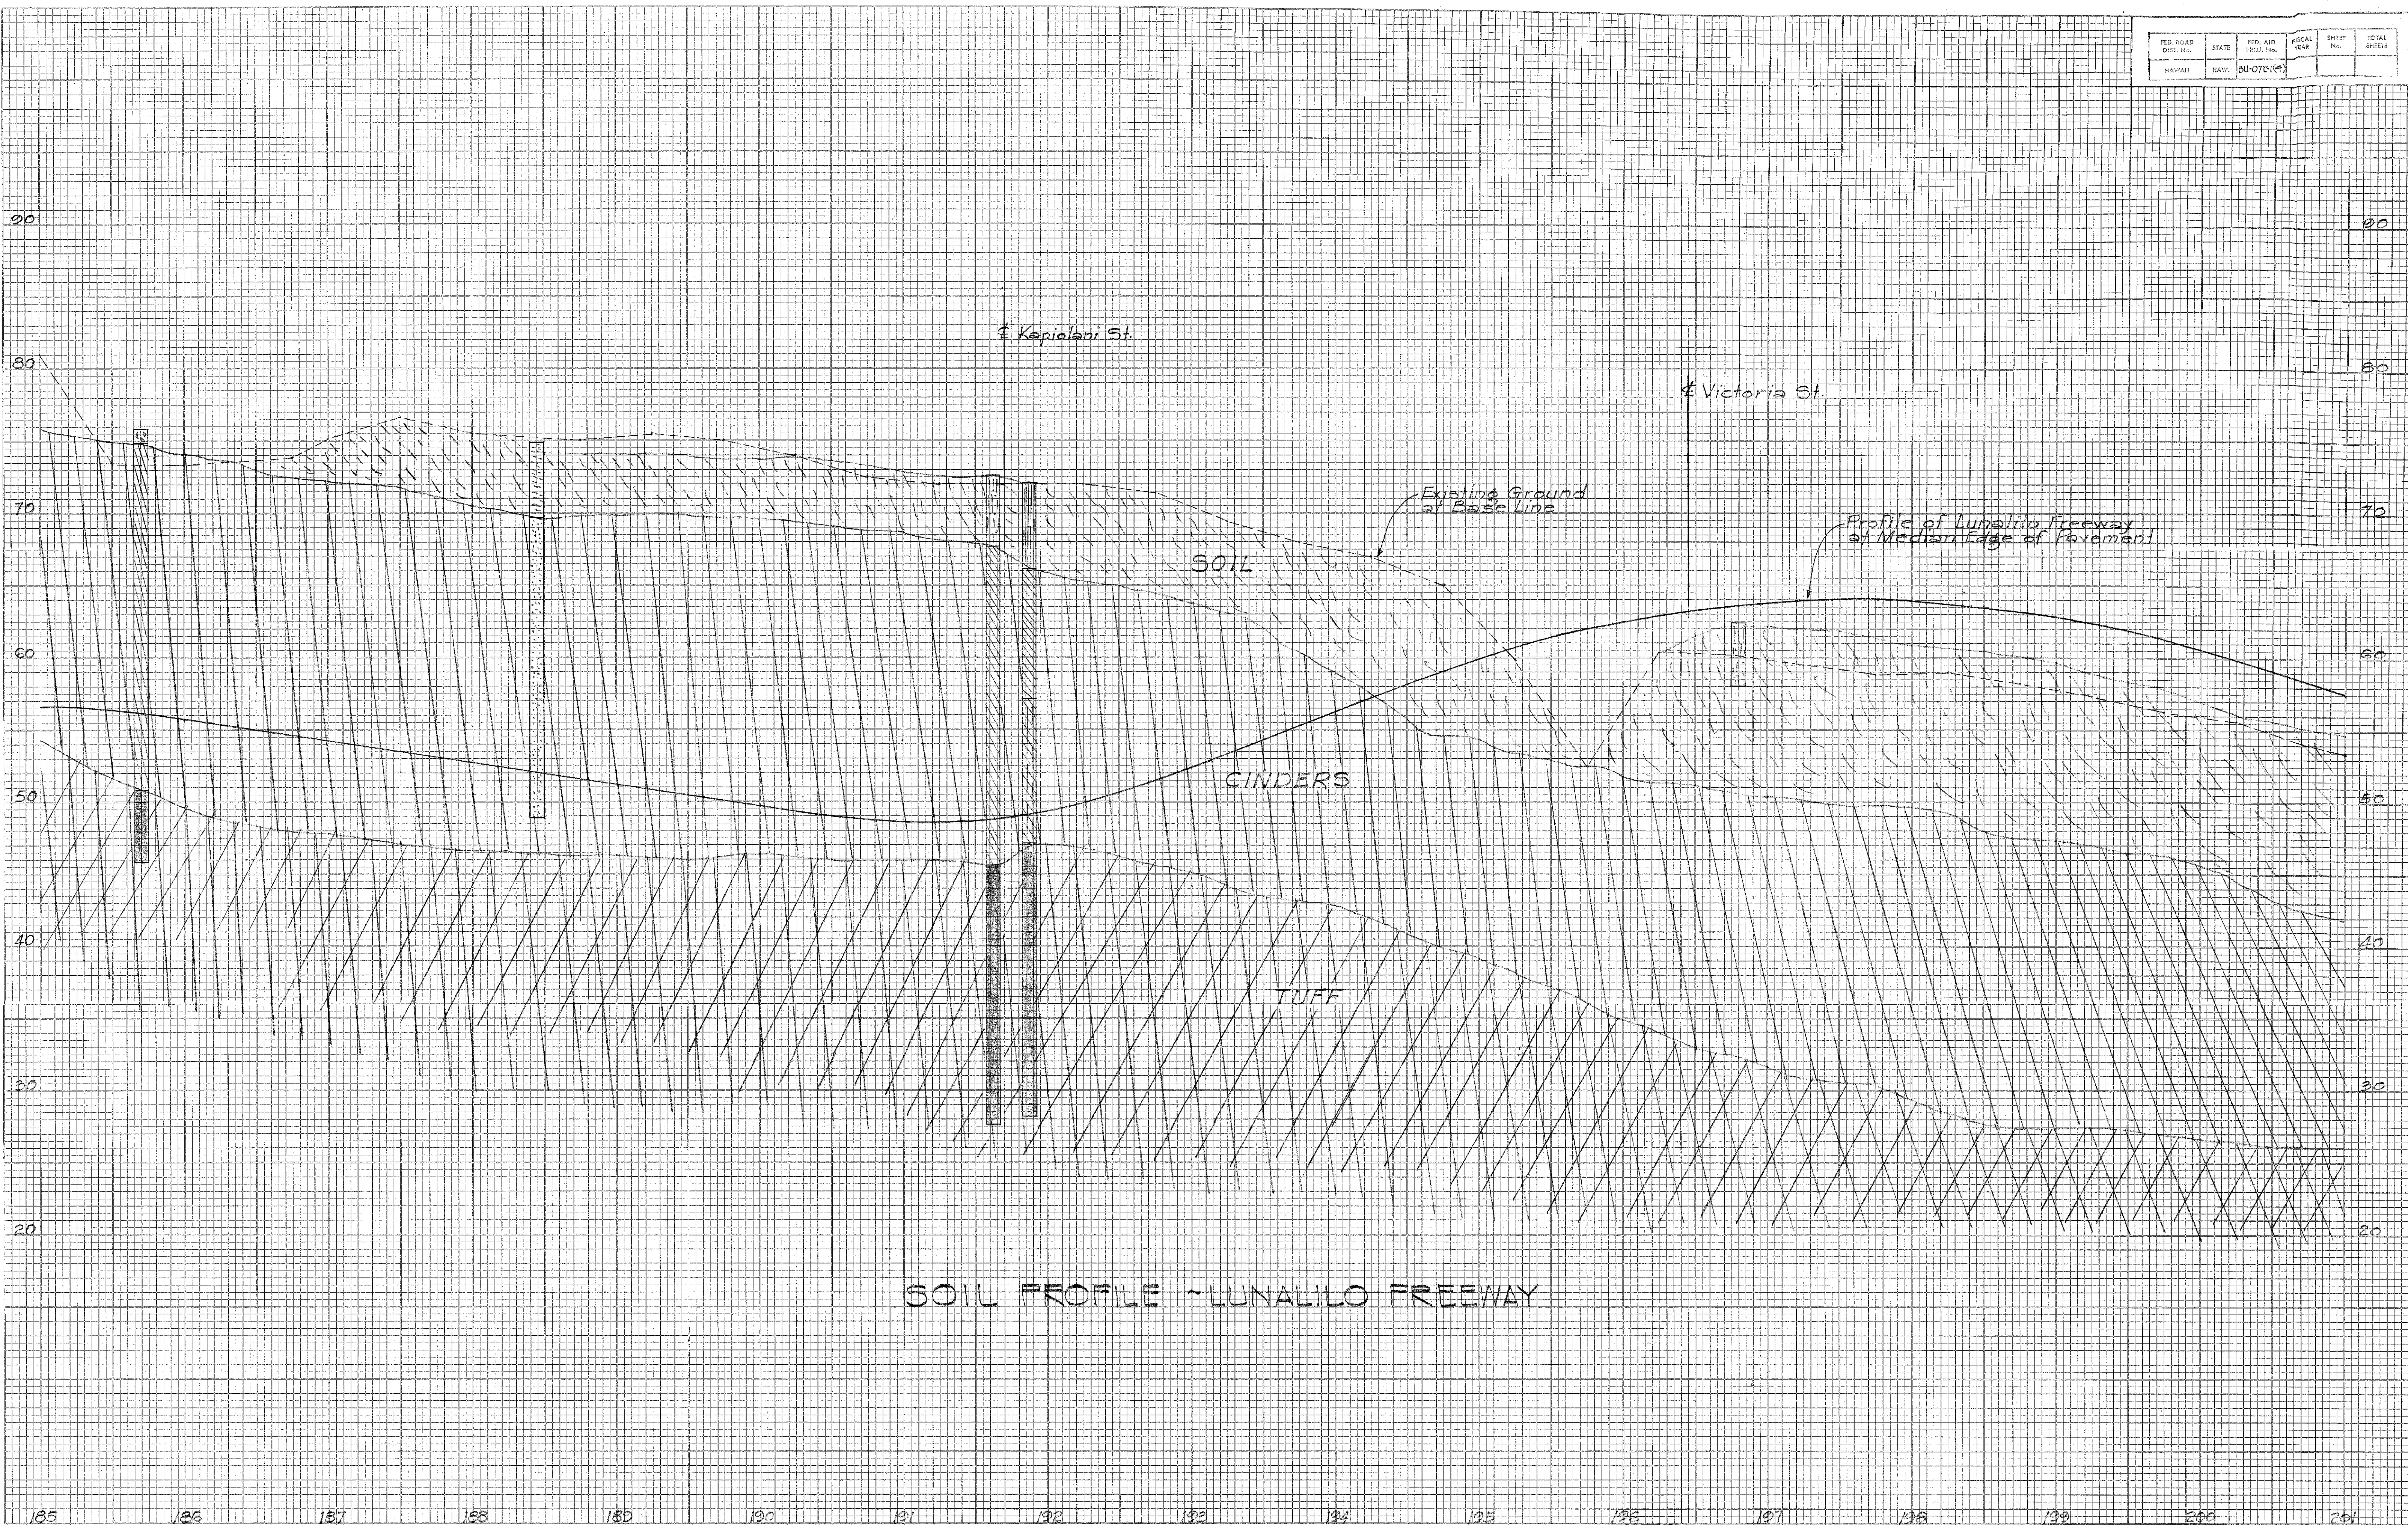

SOIL PROFILE - LUNALILO FREEWAY

PLATE 3 CROSS SECTION O. P. R. S. E.
100% ALL FURNISHED AND PRINTED IN U. S. A.
CHARLES BRUNING COMPANY