FED. ROAD DIST. NO.	STATE	PROJ. NO.	FISCAL YEAR	SHEET NO.	TOTAL SHEETS
HAWAII	HAW.	HWY-0-08-14	2016	45	88

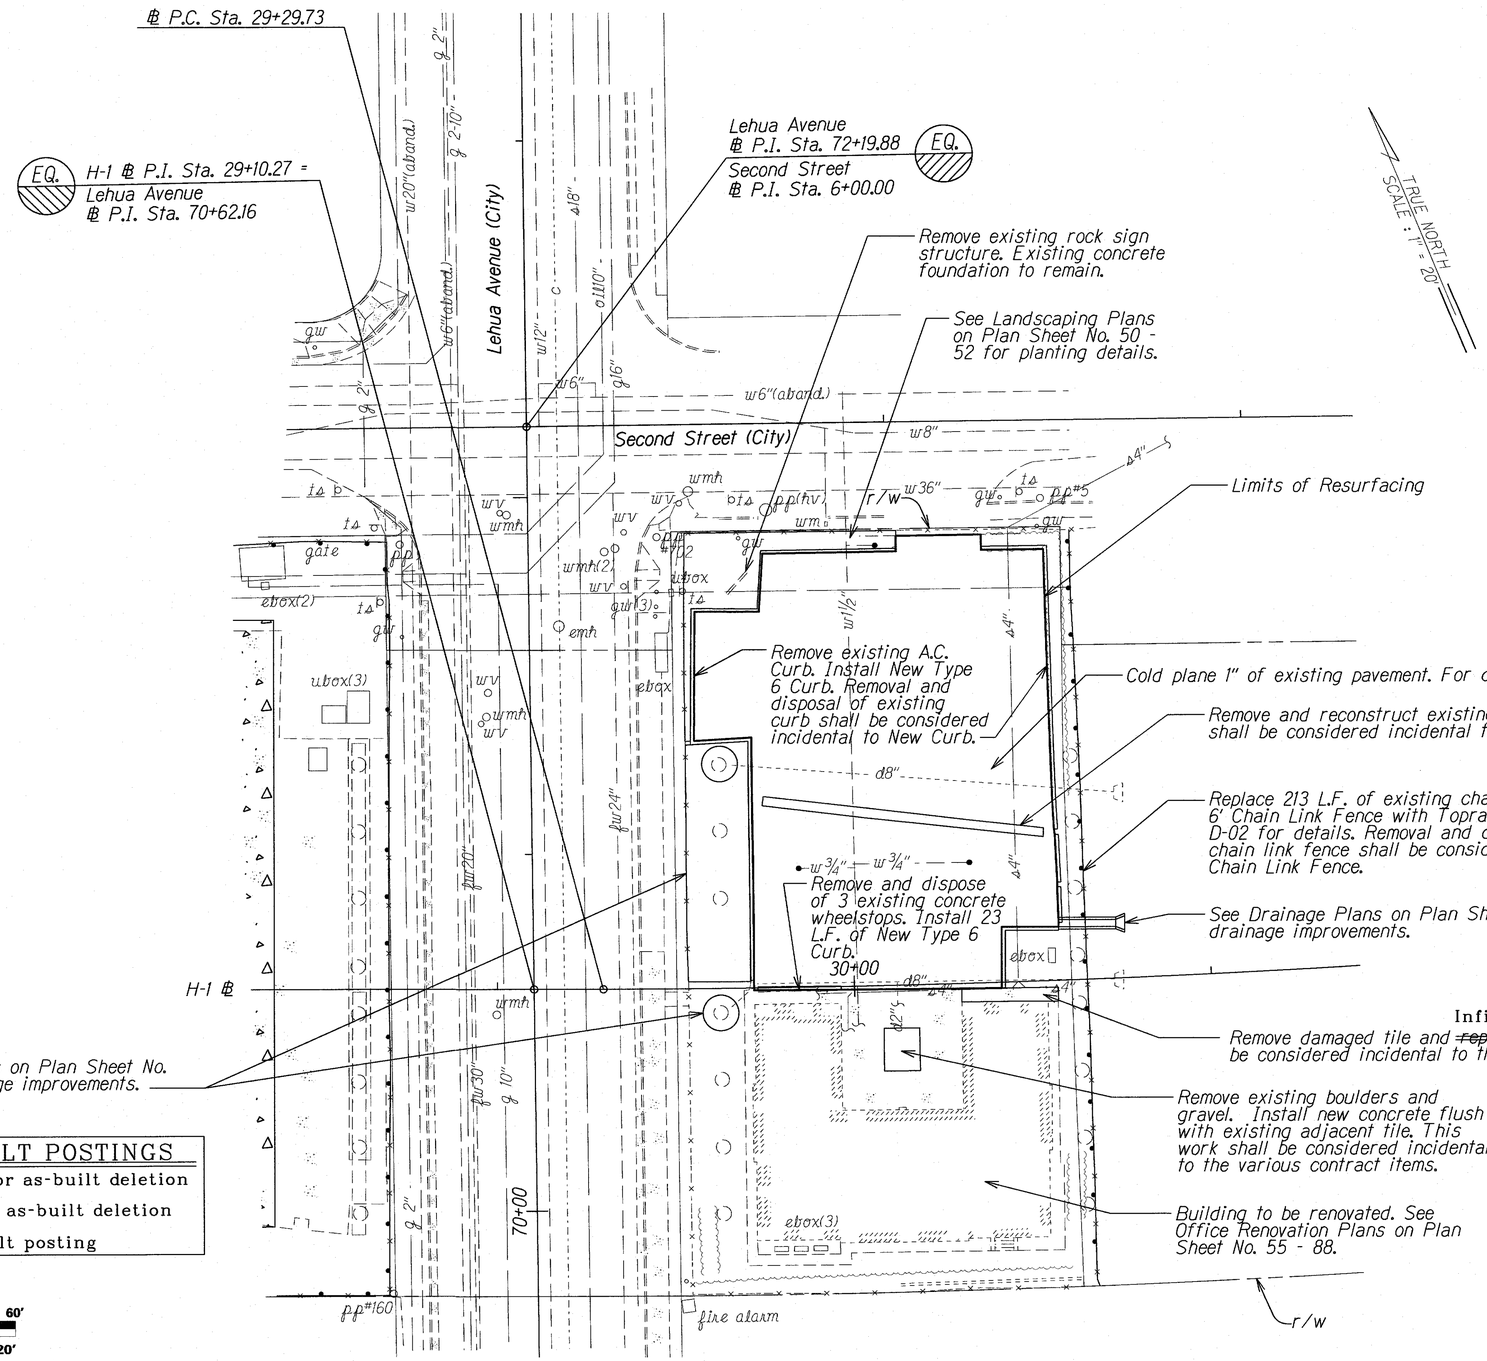

LEGEND FOR AS-BUILT POSTINGS

~~	Squiggly line for as-built deletion
~~100.00~~	Double line for as-built deletion
Roadway	Text for as-built posting

20' 10' 0 20' 40' 60'

SCALE: 1" = 20'

GRAPHIC SCALE

ORIGINAL PLAN	SURVEY PLOTTED BY	DATE
	DRAWN BY	
NOTE BOOK	TRACED BY	
	DESIGNED BY	
	QUANTITIES BY	
No.	CHECKED BY	

STATE OF HAWAII
DEPARTMENT OF TRANSPORTATION
HIGHWAYS DIVISION

OFFICE RENOVATION SITE PLAN

COMMERCIAL DRIVER'S LICENSE AND MOTORCYCLE LICENSE TESTING FACILITY EXAMINATION SITE AND OFFICE RENOVATION

Beneath Interstate Route H-1 Pearl City Viaduct

Project No. HWY-0-08-14

Scale: 1"=20' Date: May 2016

SHEET No. 1 OF 1 SHEETS

"AS-BUILT"