FED. ROAD DIST. NO.	STATE	PROJ. NO.	FISCAL YEAR	SHEET NO.	TOTAL SHEETS
HAWAII	HAW.	HWY-0-04-87	1988	4	8

CURVE DATA TABLE

No.		N. COORDINATE	E. COORDINATE		DATA
4	P.C.	-3,223.662	2,268.053	Δ	35°55'45.00"
	P.T.	-3,180.657	2,274.006	R	70.196'
	C.C.	-3,104.366	2,205.162	L	44.018'
	P.I.	-3,202.078	2,278.452	T	22.760'
5	P.C.	-3,180.657	2,274.006	Δ	31°30' 0.00"
	P.T.	-3,109.076	2,237.514	R	148.000'
	C.C.	-3,200.562	2,128.857	L	81.367'
	P.I.	-3,130.720	2,265.854	T	41.740'
6	P.C.	-3,100.075	2,237.514	Δ	27°26' 05.00"
	P.T.	-3,080.056	2,208.650	R	73.000'
	C.C.	-3,158.630	2,183.010	L	34.954'
	P.I.	-3,005.003	2,225.415	T	17.819'

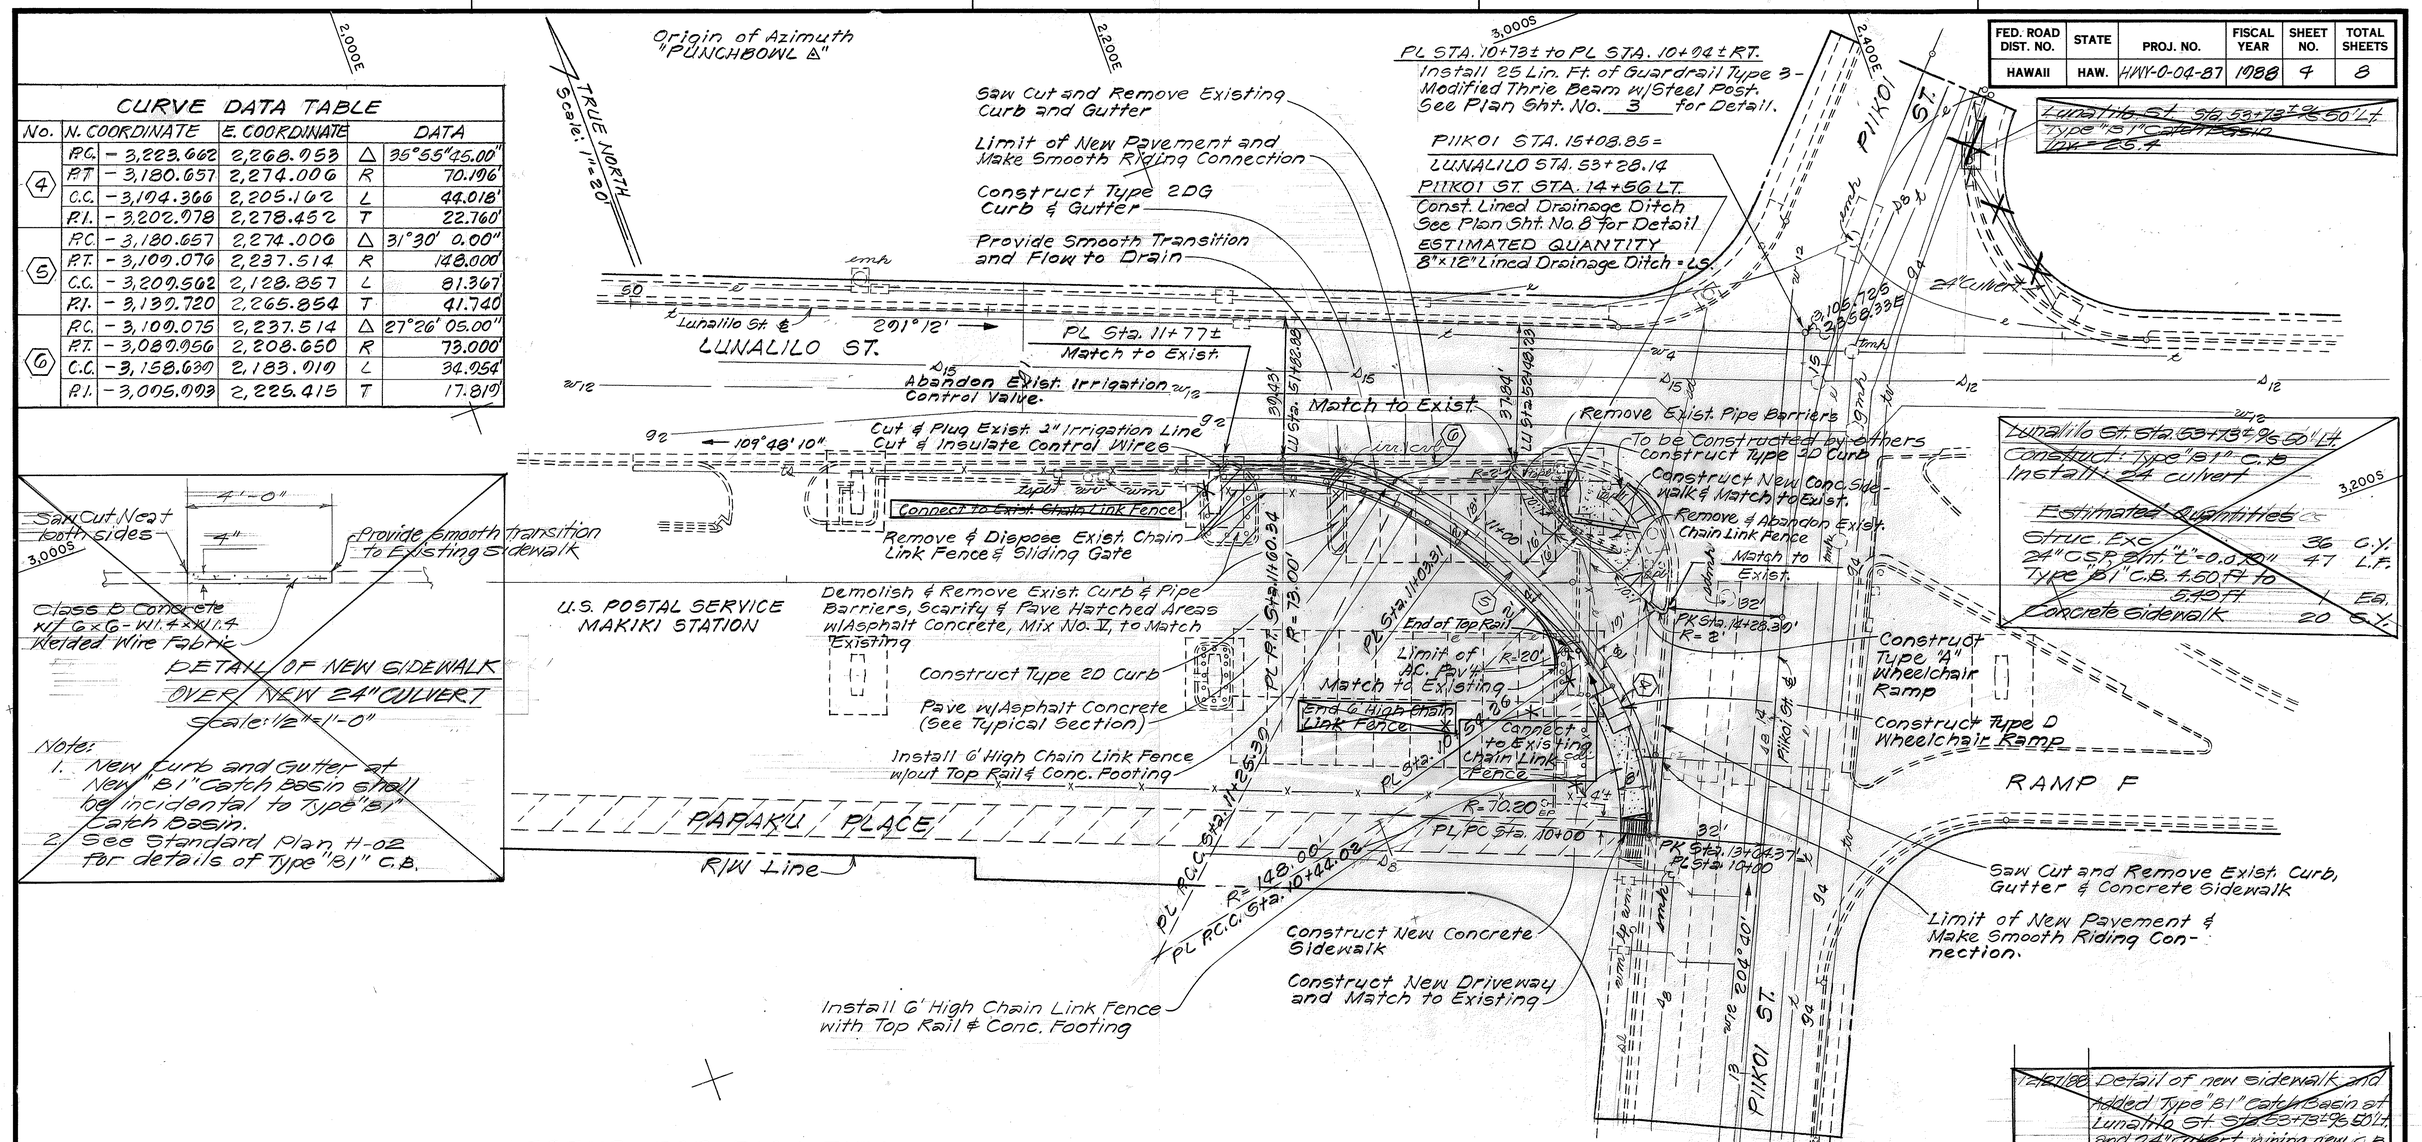

LEGEND FOR FACILITIES

- fh Existing Fire Hydrant
- sdmh Existing Storm Drain Manhole
- smh Existing Sewer Manhole
- wm Existing Water Meter
- wmh Existing Water Manhole
- wv Existing Water Valve
- tmh Existing Telephone Manhole
- gmh Existing Gas Manhole
- tspb Existing Traffic Signal Pullbox
- emh Existing Electric Manhole
- e — Existing Electric Line
- s — Existing Sewer Line
- t — Existing Telephone Line
- ts — Existing Traffic Signal Line
- w12 — Existing Water Line
- g4 — Existing Gas Line
- d24 — Existing Drain Line
- tv — Existing Cable TV Line

ORIGINAL PLAN		DATE
	SURVEY PLOTTED BY	
	DRAWN BY	
	TRACED BY	
NOTE BOOK	DESIGNED BY	
	QUANTITIES BY	
No.	CHECKED BY	

STATE OF HAWAII
DEPARTMENT OF TRANSPORTATION
HIGHWAYS DIVISION

PLAN

LUNALILO ST. & PIIKOI ST. INTERSECTION IMPROVEMENTS
ADDITIONAL LANE AND TRAFFIC SIGNALS
PROJ. NO. HWY-0-04-87

Scale: 1"=20' Date: Mar., 1988

SHEET No. 1 OF 1 SHEETS

C.O. 4

PIIKOI/LUNALILO