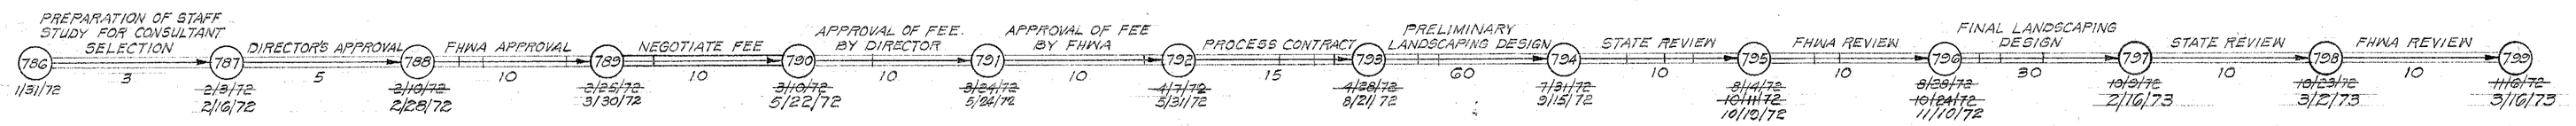

LANDSCAPING FOR H-2

WAHIAWA INTERCHANGE TO WAIAWA INTERCHANGE

(PAVING)

F.A.I. Proj. Nos. I-H2-1(12) & I-H2-1(13)

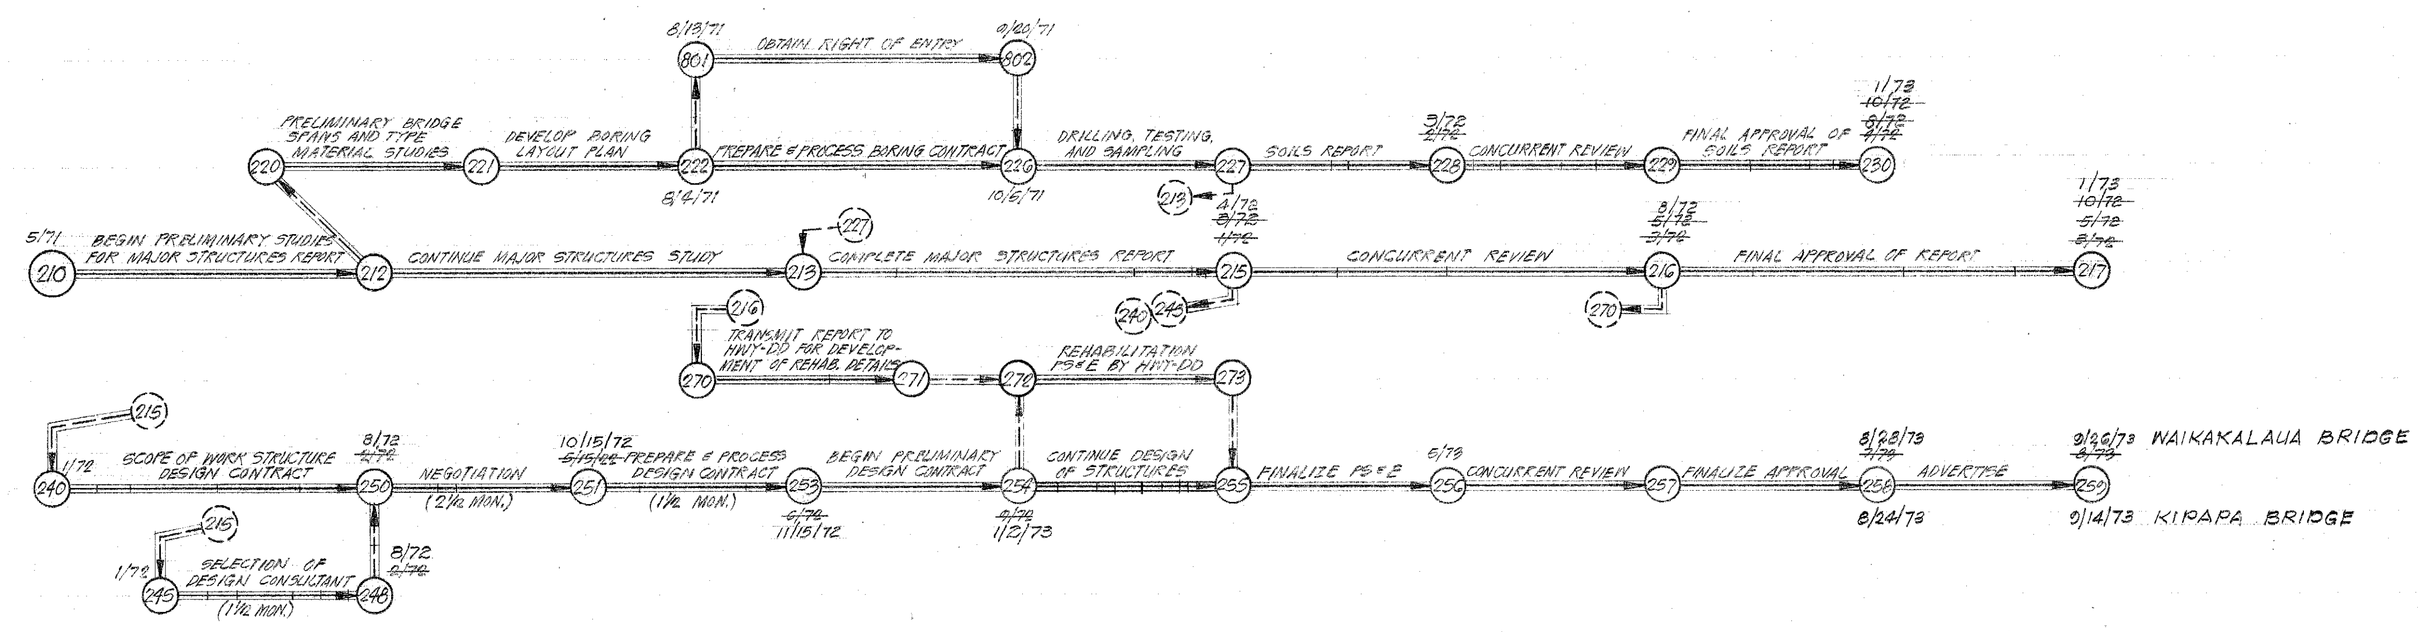

WAIKAKALAUA BRIDGE & KIPAPA BRIDGE

F.A.I. Proj. Nos. I-H2-1(10):6 & I-H2-1(3):4

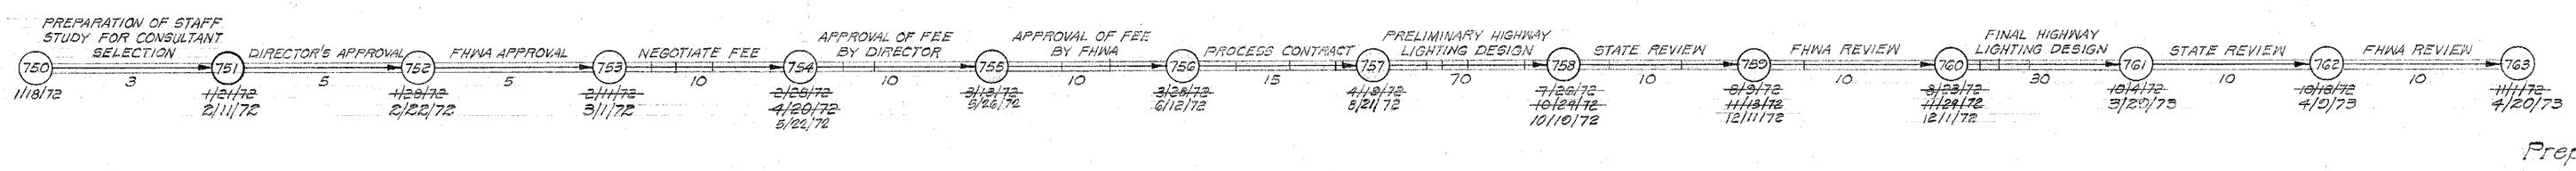

HIGHWAY LIGHTING FOR H-2

WAHIAWA INTERCHANGE TO KIPAPA GULCH

(PAVING)

F.A.I. Proj. No. I-H2-1(13)

Prepared By: _____

PROJECT STATUS REPORT
AS OF

COLOR LEGEND FOR CPM PREPARATION

1. Red — All activity progress, revisions, additions etc. which REQUIRES posting on tracing.
2. Green — All informational or clarification notes, markings etc. which DOES NOT require posting on tracing.
3. Yellow — Critical Path

NODES

001 – 000 HWY – P
100 – 100 HWY – SM
200 – 200 HWY – DD
300 – 300 HWY – T
400 – 400 HWY – DB
500 – 500 HWY – DC
600 – 600 HWY – DH
700 – 700 HWY – DT
800 – 800 HWY – R
900 – 900 HWY – C

STATE OF HAWAII
DEPARTMENT OF TRANSPORTATION
HIGHWAYS DIVISION

CPM DIAGRAM

INTERSTATE ROUTE H-2

CONSULTANT CONTRACTS

APPROVED: _____ 8/1/72
ASST. CHIEF ENGINEER — DATE

APPROVED: _____ 8/6/72
CHIEF ENGINEER — DATE