FED. ROAD DIST. NO.	STATE	FED. AID PROJ. NO.	FISCAL YEAR	SHEET NO.	TOTAL SHEETS
HAWAII	HAW.	U-078-1(15)	1975	1	10

INDEX TO DRAWINGS

SHEET NO.	DESCRIPTION
1	TITLE SHEET
2	ROADWAY PLAN, SIGNING AND STRIPING
3	UTILITY RELOCATION AND EXISTING CONDITION PLAN
4	MISCELLANEOUS DETAILS
* 5-10	SIGNING STANDARD DETAILS
*ADD. 9S-1	STANDARD DETAILS DT 500

TOTAL SHEET COUNT AFTER "AS-BUILT" POSTINGS : 11 SHEETS

STATE OF HAWAII

DEPARTMENT OF TRANSPORTATION
HIGHWAYS DIVISION

HONOLULU, HAWAII

"AS - BUILT"
PLANS FOR

MOANALUA ROAD (ROUTE 78)

SAFETY IMPROVEMENTS AT FORT SHAFTER INTERCHANGE

FEDERAL AID URBAN PROJECT NO. T-9001(23) ~~U-078-1(15)~~

DISTRICT OF HONOLULU
ISLAND OF OAHU

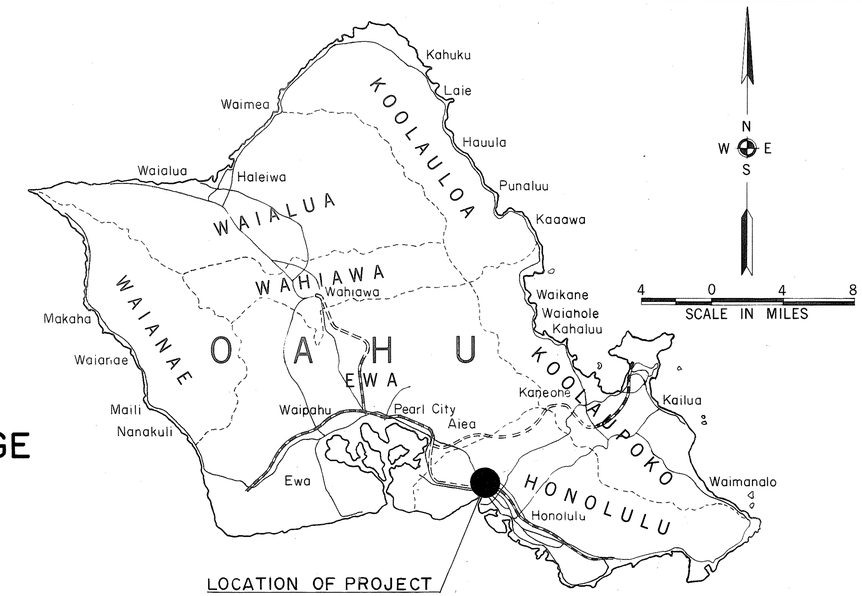

Federal Aid Interstate Projects Previously Constructed or Under Construction

NO CHANGES WERE MADE DURING CONSTRUCTION ON THESE PLANS EXCEPT CHANGES IN THE PROJECT NUMBER AND ORIGINAL THEORETICAL QUANTITIES. FOR ACTUAL QUANTITIES, REFER TO PROJECT LEDGER AND/OR COMPUTATION BOOK.

Dennis T. Higa — RESIDENT ENGINEER
10-18-83 — DATE

DESIGN CLASSIFICATION

CURRENT ADT (1975) 78,200
DESIGN ADT (1980) 31,200
DHV 3,600
D 65/35
T ..... 2 %
T24 ..... 3 %
V ..... 60 m.p.h.

F.A.U. PROJ. NO. T-9001(23) ~~U-078-1(15)~~
PROJECT LIMITS

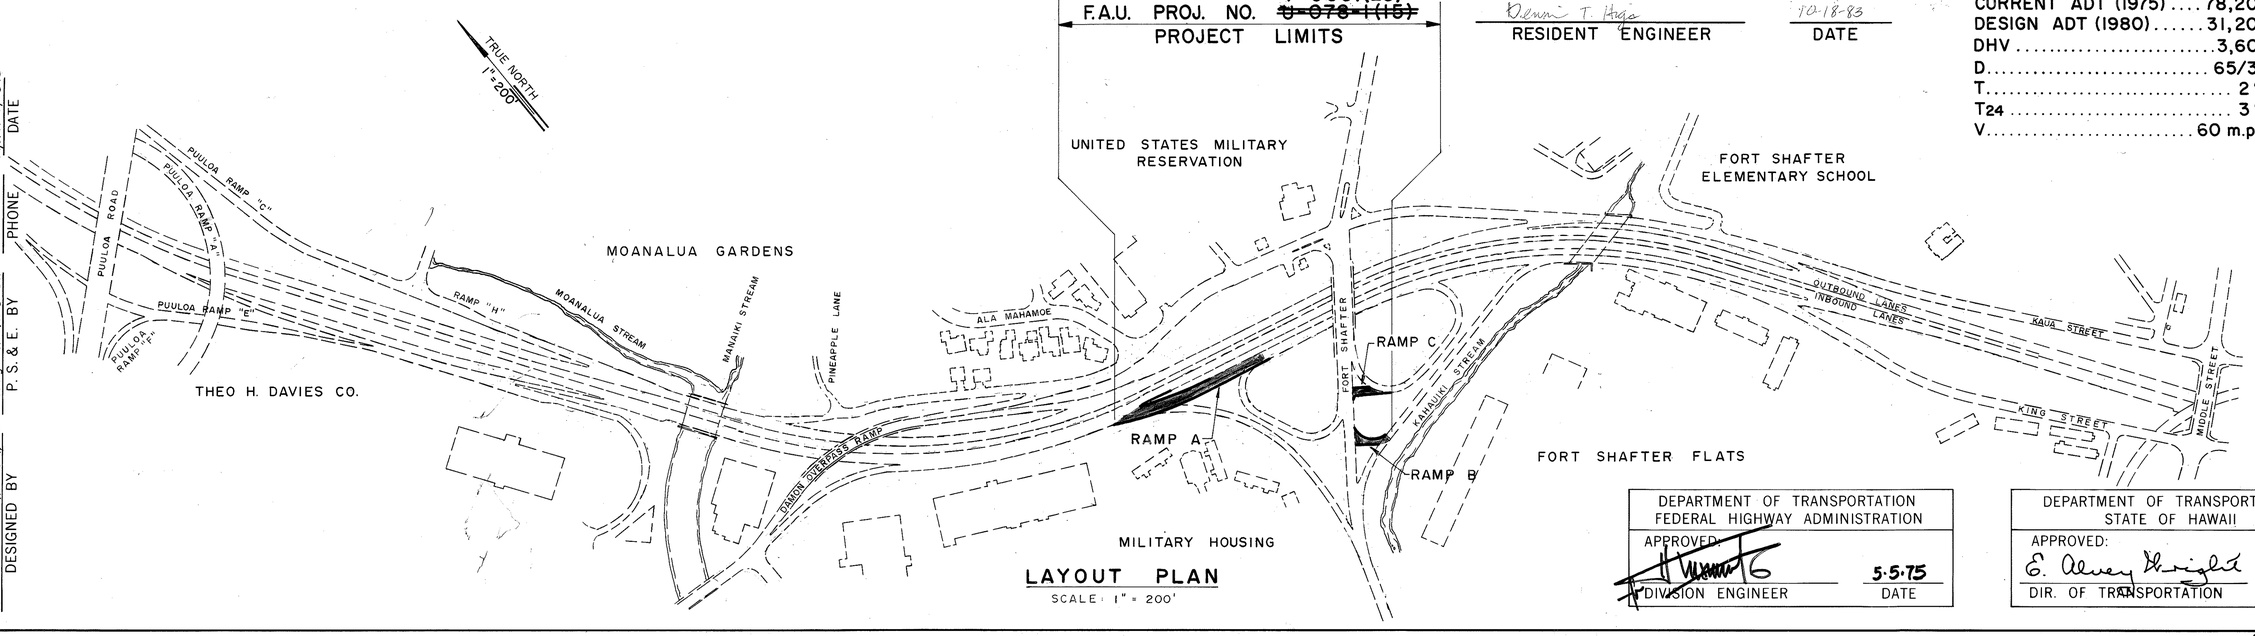

LAYOUT PLAN
SCALE: 1" = 200'

DEPARTMENT OF TRANSPORTATION FEDERAL HIGHWAY ADMINISTRATION	
APPROVED:	
DIVISION ENGINEER	5-5-75 DATE

DEPARTMENT OF TRANSPORTATION STATE OF HAWAII	
APPROVED: E. Alvey Wright	4/11/75
DIR. OF TRANSPORTATION	DATE

Sunn Low Tom & Hara, Inc. — DESIGNED BY
Jerry M. Matsuda — P. S. & E. BY
548-4042 — PHONE
April 1, 1975 — DATE