FED. ROAD DIST. NO.	STATE	FED. AID PROJ. NO.	FISCAL YEAR	SHEET NO.	TOTAL SHEETS
HAWAII	HAW.	IM-H201(1)	1994	1	32

INDEX TO DRAWINGS	
SHEET NO.	DESCRIPTION
1	TITLE SHEET
2	STANDARD PLANS SUMMARY
3	GENERAL NOTES AND LEGEND
4 – 8	TYPICAL SECTIONS
9 – 15	ROADWAY PLANS
16 – 24	PAVEMENT MARKING & SIGNING PLANS
25 – 26	SIGNING DETAILS
27	SIGN DETAILS AND FRAME LAYOUT
28	TYPICAL EXIT NUMBER SIGN
	PANEL LAYOUT
29	MISCELLANEOUS TRAFFIC DETAILS
30	LOOP DETECTOR DETAILS
31 – 32	MISCELLANEOUS TRAFFIC SUMMARIES

STATE OF HAWAII

DEPARTMENT OF TRANSPORTATION

HIGHWAYS DIVISION

HONOLULU, HAWAII

"AS-BUILT"

PLANS FOR

MOANALUA FREEWAY RESURFACING

MOANALUA STREAM BRIDGE TO MIDDLE STREET

FEDERAL AID PROJECT NO. IM-H201(1)

DISTRICT OF HONOLULU

ISLAND OF OAHU

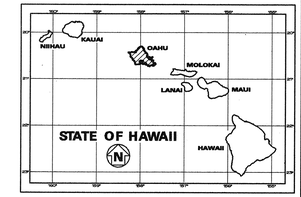

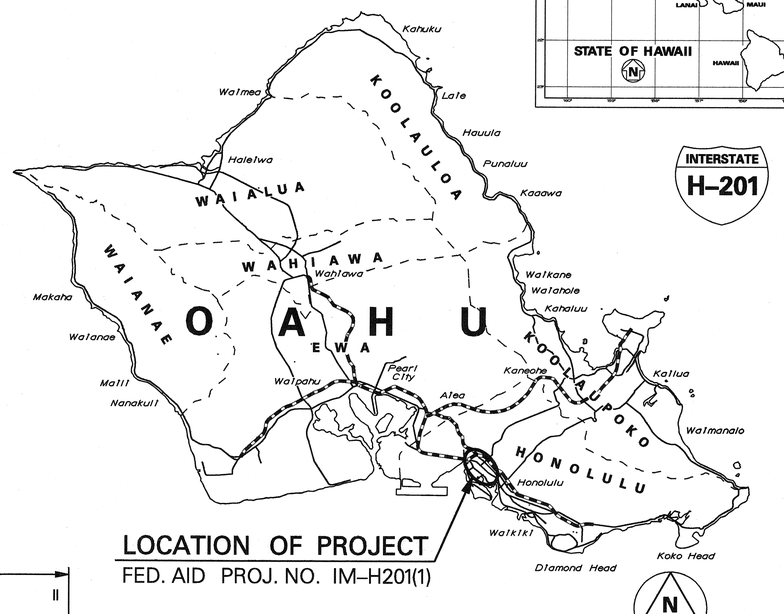

LOCATION OF PROJECT

FED. AID PROJ. NO. IM-H201(1)

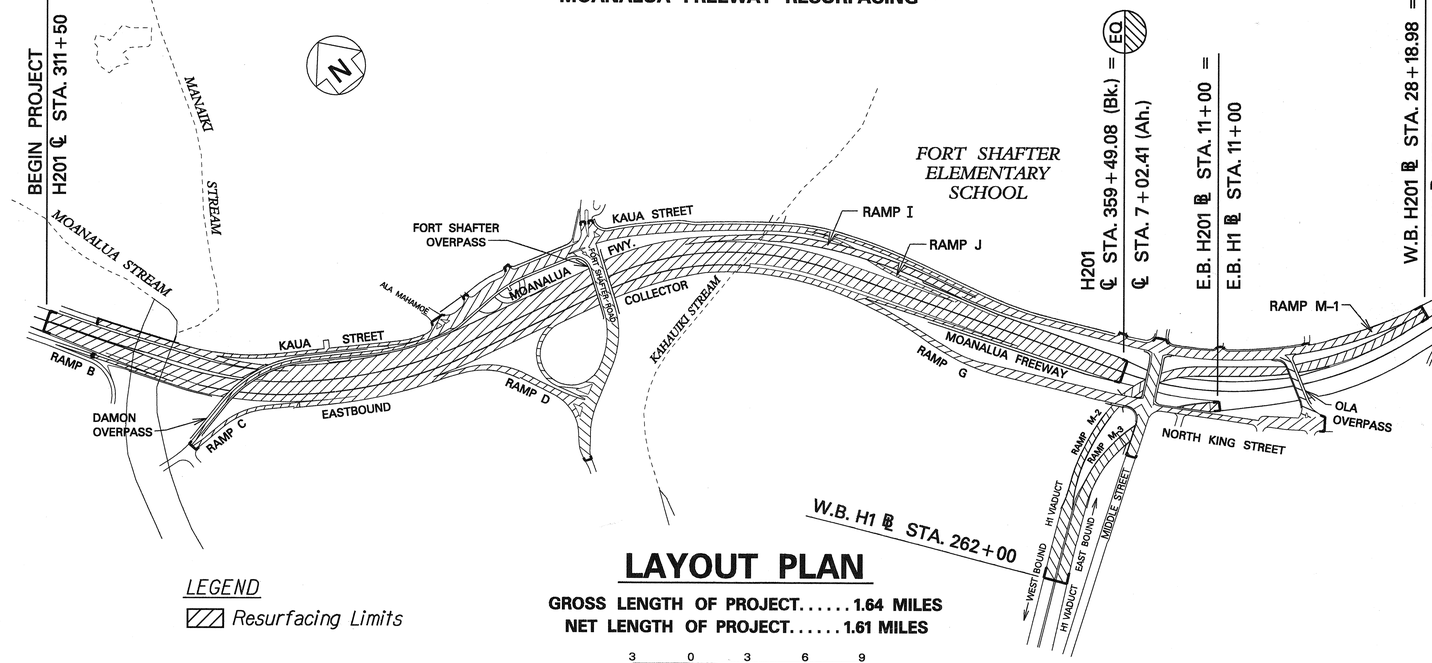

LAYOUT PLAN

GROSS LENGTH OF PROJECT..... 1.64 MILES

NET LENGTH OF PROJECT..... 1.61 MILES

3 0 3 6 9

SCALE IN HUNDRED FEET

LEGEND

▨ *Resurfacing Limits*

FEDERAL AID INTERSTATE PROJECTS PREVIOUSLY CONSTRUCTED OR UNDER CONSTRUCTION

MILE POST 3.19 TO MILE POST 4.83

DESIGN DESIGNATION

ADT (1993)	111,037
ADT (2003)	132,374
DHV	10,379
D	55/45
T	2.0 %
V	50 M.P.H.

CHANGES MADE DURING CONSTRUCTION HAVE BEEN INCORPORATED ON THESE PLANS EXCEPT CHANGES IN THE ORIGINAL THEORETICAL QUANTITIES. FOR ACTUAL QUANTITIES, REFER TO PROJECT LEDGER AND/OR COMPUTATION BOOK.

Sidney S.C. Im — RESIDENT ENGINEER — 4/19/02 DATE

DEPARTMENT OF TRANSPORTATION FEDERAL HIGHWAY ADMINISTRATION	
APPROVED:	
for DIVISION ADMINISTRATOR	5/4/94 DATE

DEPARTMENT OF TRANSPORTATION STATE OF HAWAII	
APPROVED:	
for DIR. OF TRANSPORTATION	5/12/94 DATE

HWY-DD — DESIGNED BY

R. TAKAESU — P. S. & E. BY

587-2249 — PHONE

JUNE, 1993 — DATE

2moadtsht.dgn d:\f4.mal r2-24-94