FED. ROAD DIST. NO.	STATE	PROJ. NO.	FISCAL YEAR	SHEET NO.	TOTAL SHEETS
HAWAII	HAW.	H201A-01-06M	2008	1	64

H201

INDEX TO DRAWINGS

SHEET NO.	DESCRIPTION
1	TITLE SHEET
2	STANDARD PLANS SUMMARY
3	GENERAL NOTES
4	HECO NOTES
5 – 6	NPDES GENERAL NOTES
7 – 14	GUARDRAIL DETAILS
15	TYPICAL SECTIONS AND DETAILS
16 – 25	CURB RAMP NOTES AND DETAILS
26 – 29	ROADWAY PLANS
30 – 57	BRIDGE RAILING & RETAINING WALLS UPGRADE
58 – 64	PAVEMENT MARKING AND SIGNING PLANS

STATE OF HAWAII

DEPARTMENT OF TRANSPORTATION

HIGHWAYS DIVISION

HONOLULU, HAWAII

"AS-BUILT"

PLANS FOR

MOANALUA FREEWAY
NORTH FRONTAGE ROAD RESURFACING

VICINITY OF ALA AOLANI TO ALA KAPUNA

PROJECT NO. H201A-01-06M

DISTRICT OF HONOLULU
ISLAND OF OAHU

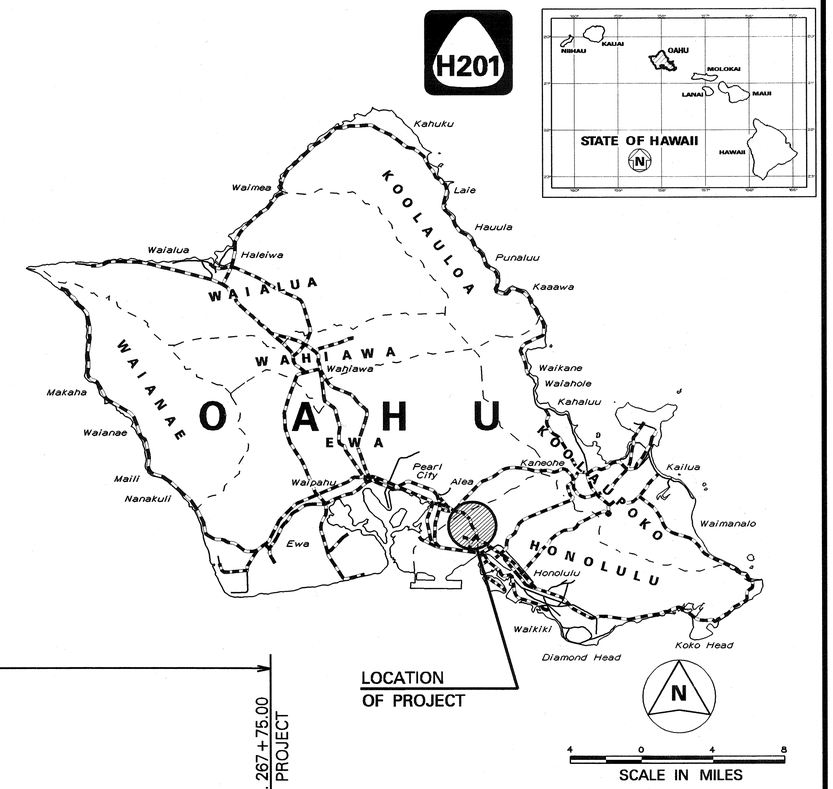

MILE POST 1.50 TO MILE POST 2.27

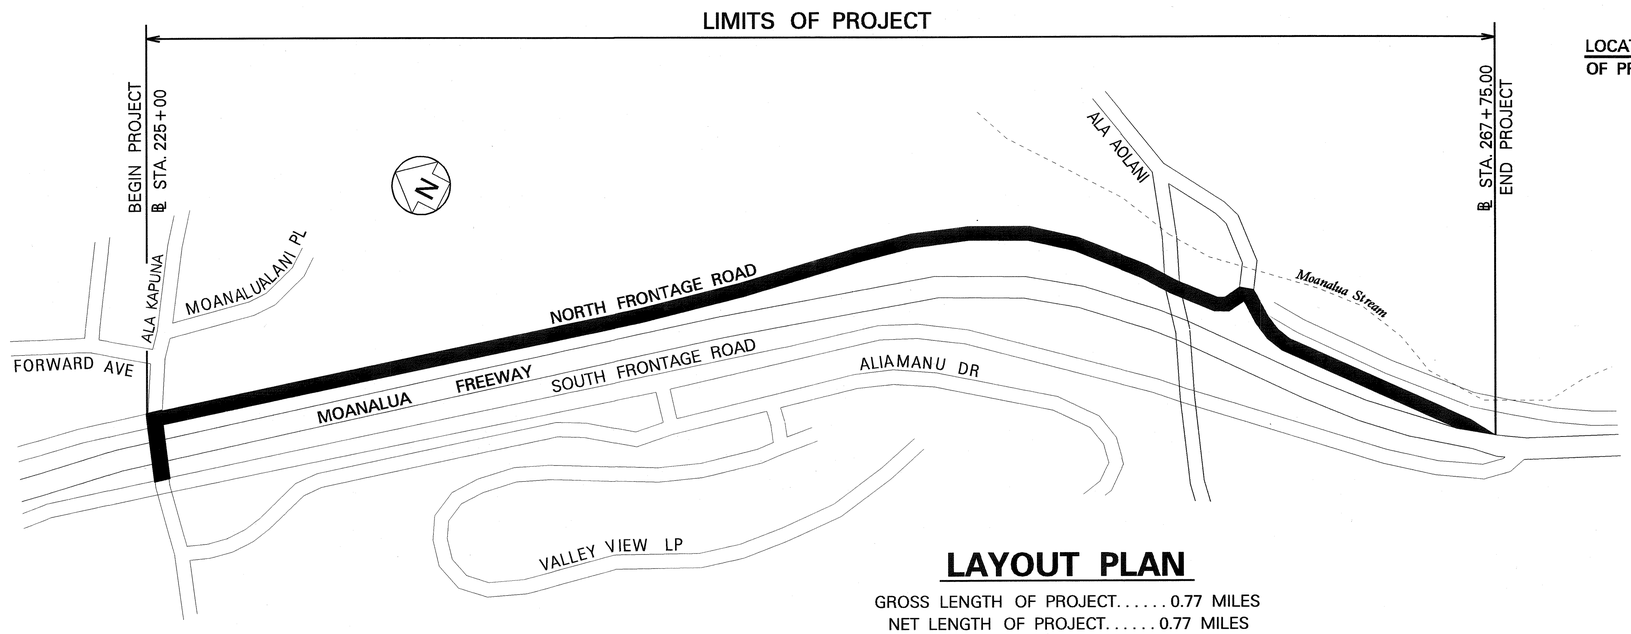

LAYOUT PLAN

GROSS LENGTH OF PROJECT..... 0.77 MILES
NET LENGTH OF PROJECT..... 0.77 MILES

2 0 2 4 6
SCALE IN HUNDRED FEET

CHANGES MADE DURING CONSTRUCTION HAVE BEEN INCORPORATED ON THESE PLANS EXCEPT CHANGES IN THE ORIGINAL THEORETICAL QUANTITIES. FOR ACTUAL QUANTITIES, REFER TO PROJECT LEDGER AND/OR COMPUTATION BOOK.

RESIDENT ENGINEER — DATE 10.12.2012

DEPARTMENT OF TRANSPORTATION
STATE OF HAWAII

APPROVED:

DIR. OF TRANSPORTATION — DATE 5.22.08

HWY – D / DESIGNED BY
HWY – DD / MANAGED BY
692-7570 / PHONE
May, 2008 / DATE