FED. ROAD DIST. NO.	STATE	PROJ. NO.	FISCAL YEAR	SHEET NO.	TOTAL SHEETS
HAWAII	HAW.	HWY-0-07-16	2020	12	22

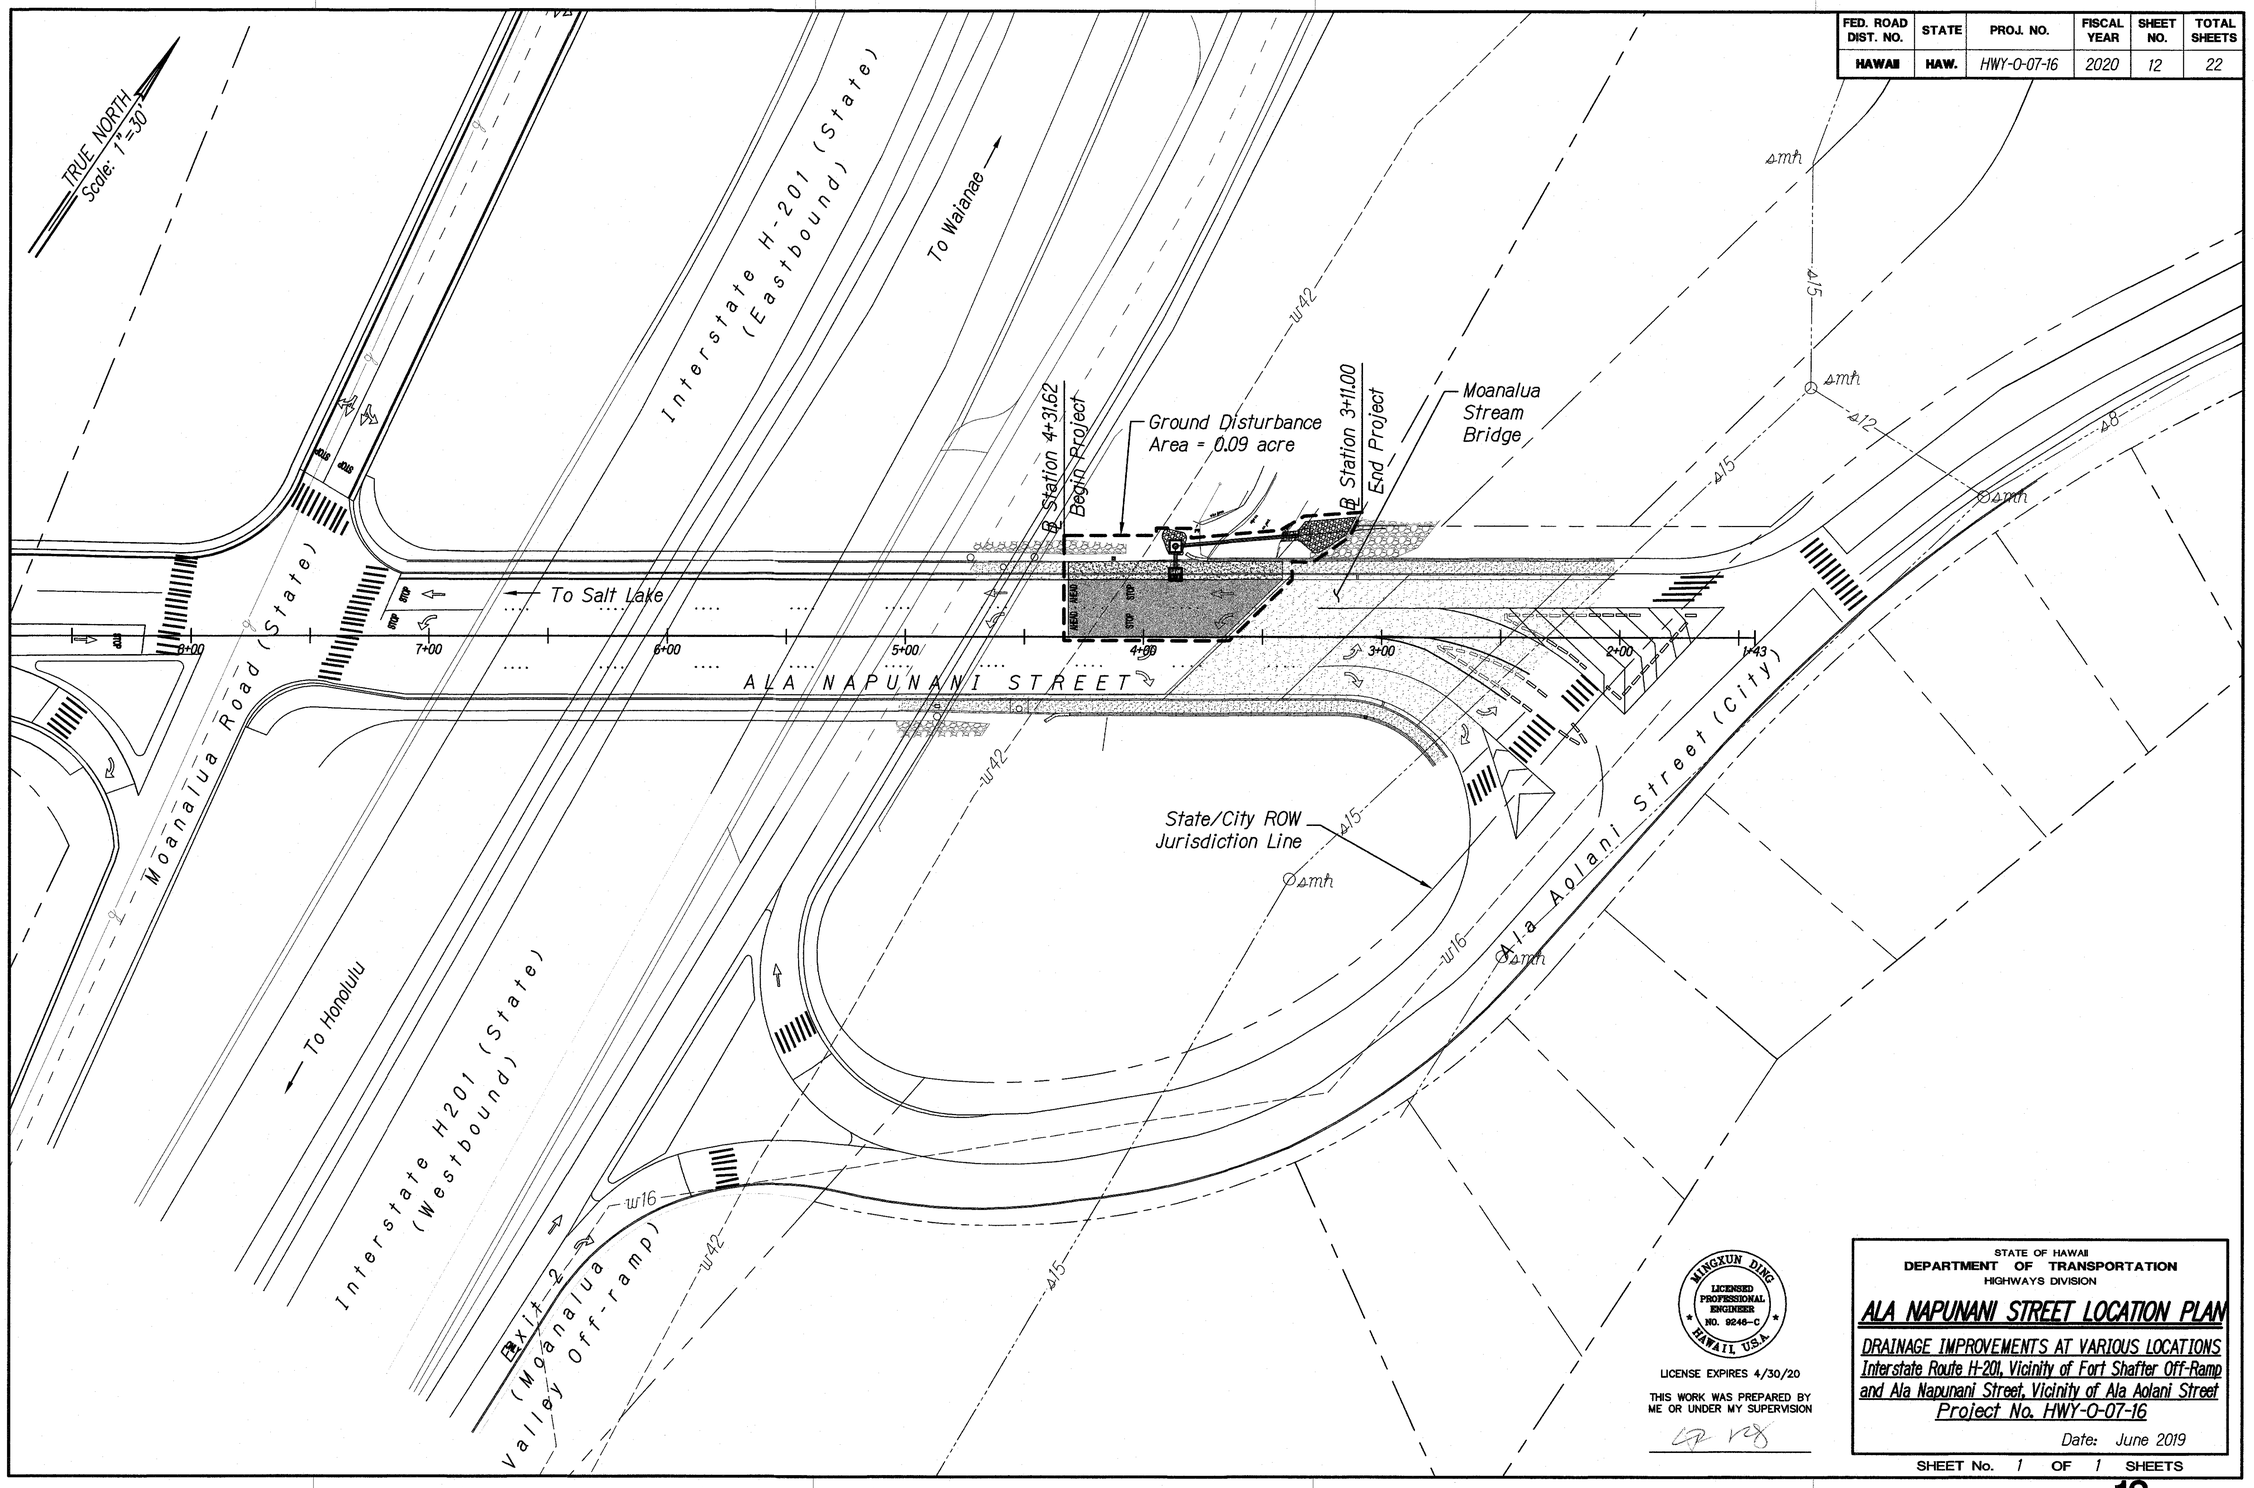

ORIGINAL PLAN	SURVEY PLOTTED BY ____ DATE ____
	DRAWN BY ____
NOTE BOOK	TRACED BY ____
	DESIGNED BY ____
	QUANTITIES BY ____
No. ____	CHECKED BY ____

MINGXUN DING
LICENSED PROFESSIONAL ENGINEER
NO. 9246-C
HAWAII, U.S.A.

LICENSE EXPIRES 4/30/20

THIS WORK WAS PREPARED BY ME OR UNDER MY SUPERVISION

STATE OF HAWAII
DEPARTMENT OF TRANSPORTATION
HIGHWAYS DIVISION

ALA NAPUNANI STREET LOCATION PLAN

DRAINAGE IMPROVEMENTS AT VARIOUS LOCATIONS
Interstate Route H-201, Vicinity of Fort Shafter Off-Ramp
and Ala Napunani Street, Vicinity of Ala Aolani Street
Project No. HWY-0-07-16

Date: June 2019

SHEET No. 1 OF 1 SHEETS

FED. ROAD DIST. NO.	STATE	PROJ. NO.	FISCAL YEAR	SHEET NO.	TOTAL SHEETS
HAWAII	HAW.	HWY-0-07-16	2020	12	22

TRUE NORTH
Scale: 1"=30'

Interstate H-201 (State)
(Eastbound)

To Waianae

Station 4+31.62
Begin Project

Ground Disturbance
Area = ~~0.09 acre~~

Station 3+11.00
End Project

Moanalua
Stream
Bridge

REFER TO SHEET C.O. 13 FOR THE REVISED SCOPE OF WORK

To Salt Lake

6+00 7+00 6+00 5+00 4+00 3+00 2+00 1+43

OMITTED

A L A N A P U N A N I S T R E E T

Scale: 1:30

Moanalua Road (State)

State/City ROW
Jurisdiction Line

Ala Aolani Street (City)

To Honolulu

Interstate H201 (State)
(Westbound)

Exit 2
(Moanalua
Valley Off-ramp)

AS BUILT
HENRY'S EQUIPMENT RENTAL & SALES, INC.
SIGNATURE 9/20/21 DATE

MINGXUN DING
LICENSED PROFESSIONAL ENGINEER
NO. 9246-C
HAWAII, U.S.A.

LICENSE EXPIRES 4/30/20

THIS WORK WAS PREPARED BY ME OR UNDER MY SUPERVISION

STATE OF HAWAII
DEPARTMENT OF TRANSPORTATION
HIGHWAYS DIVISION

ALA NAPUNANI STREET LOCATION PLAN

DRAINAGE IMPROVEMENTS AT VARIOUS LOCATIONS
Interstate Route H-201, Vicinity of Fort Shafter Off-Ramp and Ala Napunani Street, Vicinity of Ala Aolani Street
Project No. HWY-0-07-16

Date: June 2019

SHEET No. 1 OF 1 SHEETS

ORIGINAL PLAN	SURVEY PLOTTED BY	DATE
	DRAWN BY	
NOTE BOOK	TRACED BY	
	DESIGNED BY	
	QUANTITIES BY	
No.	CHECKED BY	