FED. ROAD DIST. NO.	STATE	PROJ. NO.	FISCAL YEAR	SHEET NO.	TOTAL SHEETS
HAWAII	HAW.	HWY-O-07-16	2020	1	22

INDEX TO DRAWINGS

SHEET NO.	DESCRIPTION
1	TITLE SHEET
2	STANDARD PLANS SUMMARY
3-4	GENERAL NOTES, LEGEND & ABBREVIATIONS
5-7	UTILITY NOTES
8-9	WATER POLLUTION & EROSION CONTROL NOTES
10	INTERSTATE H-201 LOCATION PLAN
11	INTERSTATE H-201 SITE PLAN
11-A	PROFILED PAVEMENT MARKING DETAILS
12	ALA NAPUNANI STREET LOCATION PLAN
13	ALA NAPUNANI STREET SITE PLAN
14	ALA NAPUNANI STREET GRADING PLAN
15	TRAFFIC CONTROL NOTES
16-17	H-1/H-201 TRAFFIC CONTROL PLAN
18	ALA NAPUNANI STREET TRAFFIC CONTROL PLAN
19	STRUCTURAL NOTES
20	H-201 TRENCH DRAIN DETAILS
21	ALA NAPUNANI STREET CATCH BASIN DETAILS
22	DRAIN PIPE AND GROUTED RUBBLE PAVING DETAILS
23	DRAIN PIPE AND CRM WALL DETAILS

STATE OF HAWAII

DEPARTMENT OF TRANSPORTATION

HIGHWAYS DIVISION

HONOLULU, HAWAII

PLANS FOR

DRAINAGE IMPROVEMENTS AT VARIOUS LOCATIONS

INTERSTATE ROUTE H-201
VICINITY OF FORT SHAFTER OFF-RAMP AND ALA NAPUNANI STREET
VICINITY OF ALA AOLANI STREET

PROJECT NO. HWY-O-07-16

DISTRICT OF HONOLULU
ISLAND OF OAHU

INTERSTATE H-201

7349

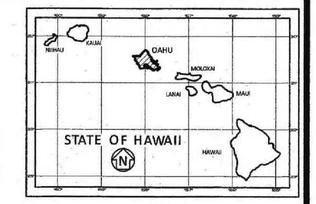

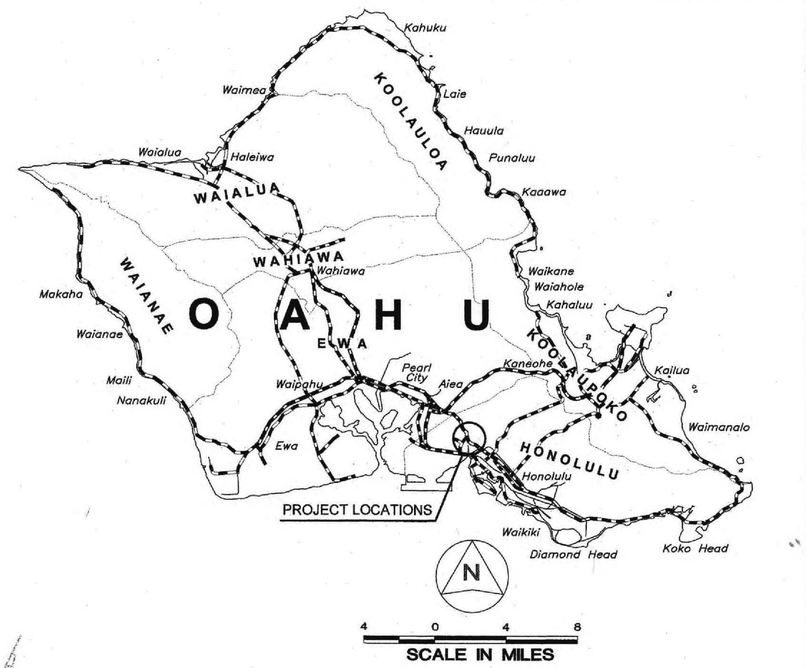

FEDERAL AID PROJECTS PREVIOUSLY CONSTRUCTED OR UNDER CONSTRUCTION

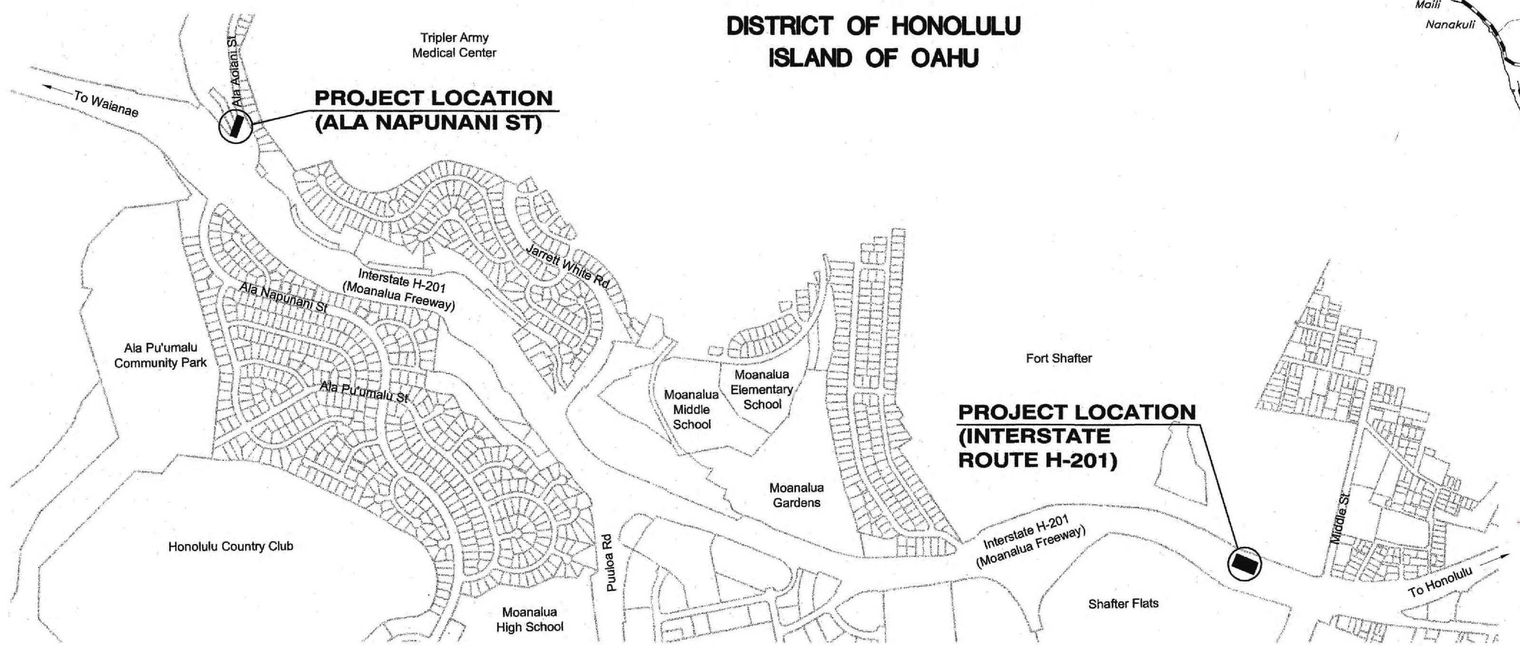

LAYOUT PLAN

NOT TO SCALE

N

CHANGES MADE DURING CONSTRUCTION HAVE BEEN NOTED ON THESE PLANS AND CHECKED BY:

Samuel P. Rombaoa — RESIDENT ENGINEER — Jan 10, 2022 — DATE

AS BUILT
HENRY'S EQUIPMENT RENTAL & SALES, INC.
SIGNATURE — DATE 9/20/21

DEPARTMENT OF TRANSPORTATION
STATE OF HAWAII
APPROVED:
for DIR. OF TRANSPORTATION — DATE 6/28/19

AECOM	HWY-DH	692-7561	JUNE 2019
DESIGNED BY	MANAGED BY	PHONE	DATE