


FED. ROAD DIST. NO.	STATE	FED. AID PROJ. NO.	FISCAL YEAR	SHEET NO.	TOTAL SHEETS
HAWAII	HAW.	I - H3 - 1(52)	1988	23	75

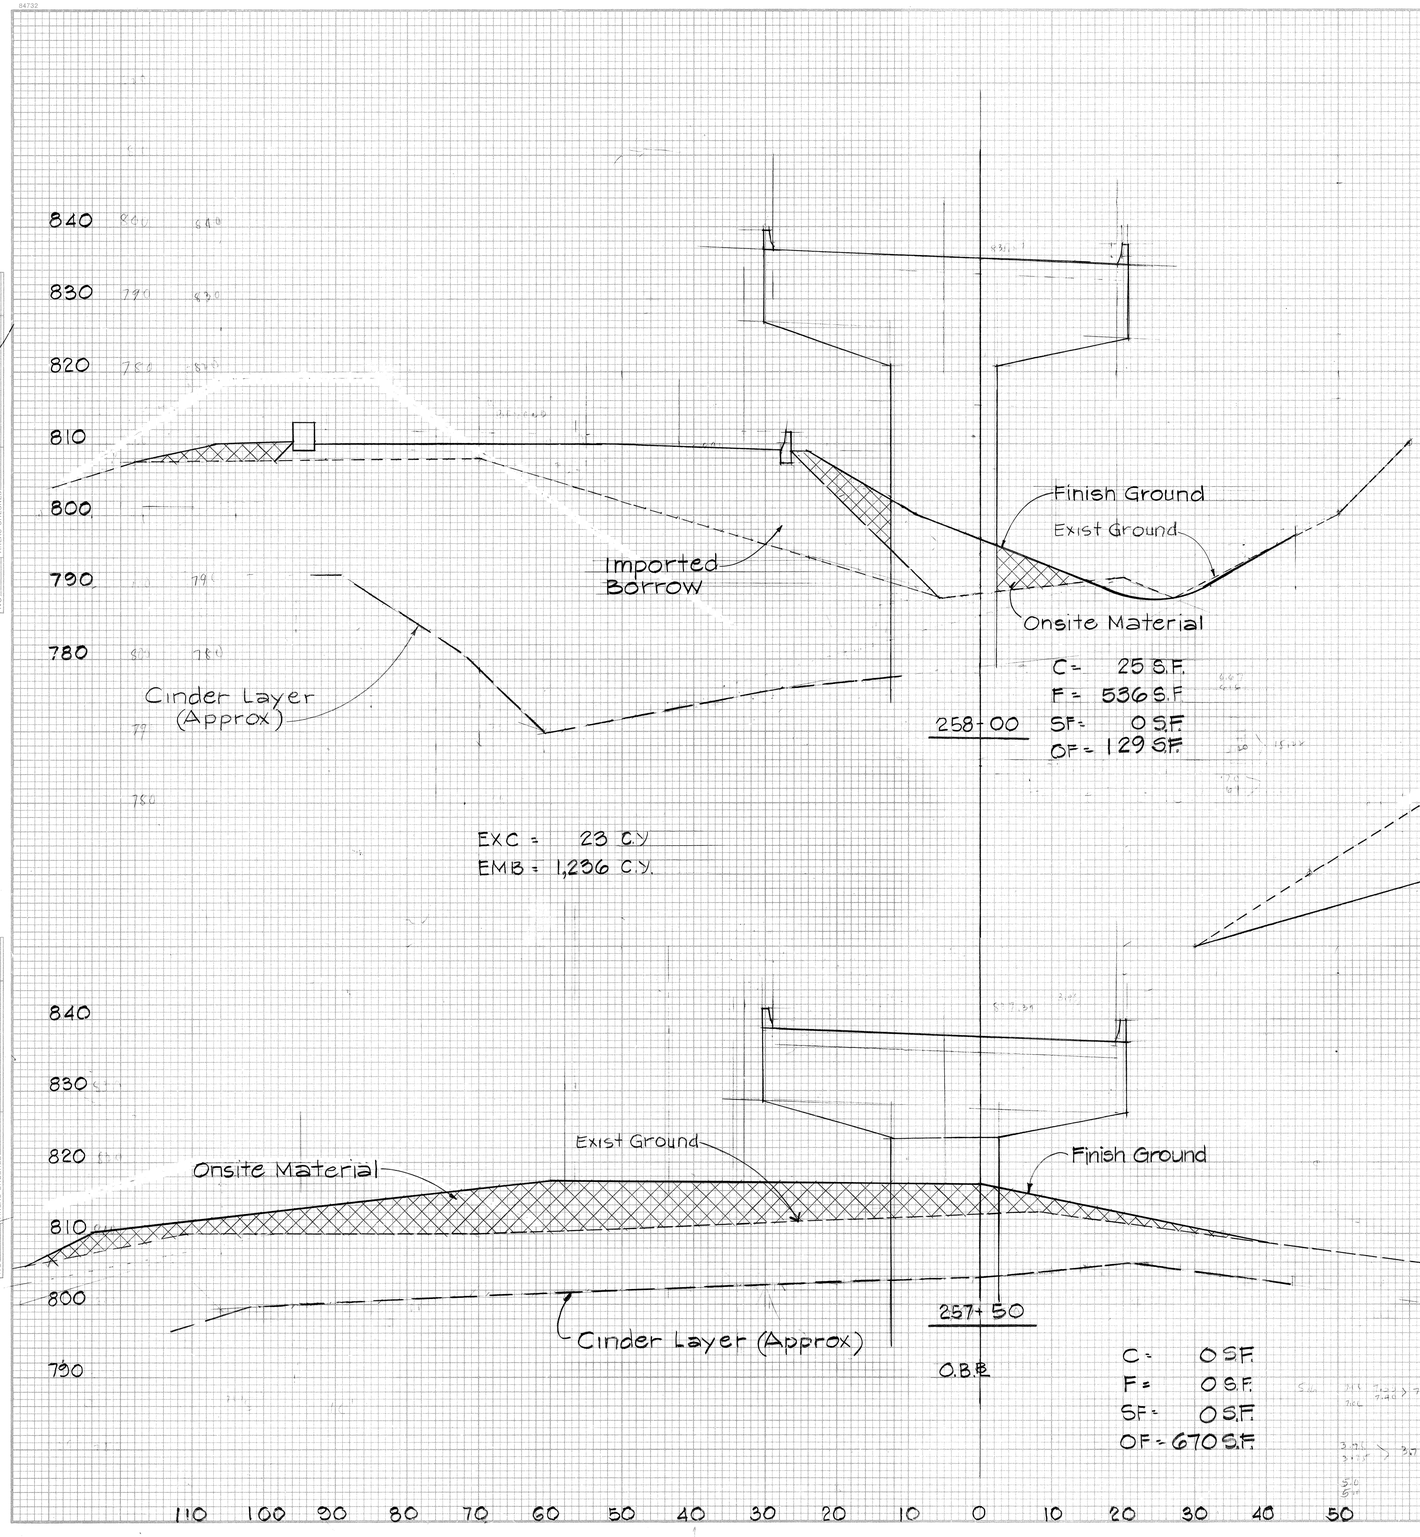

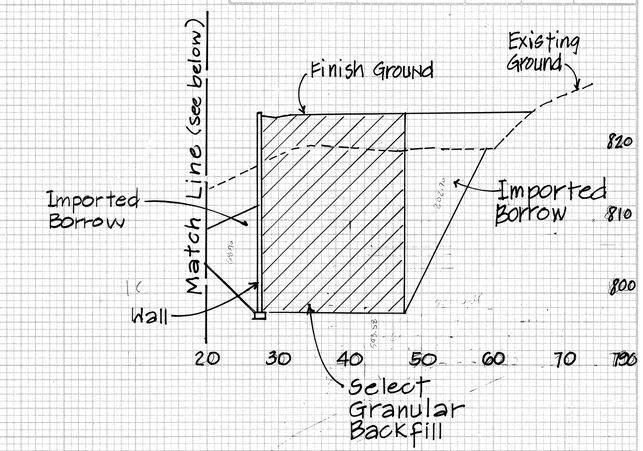

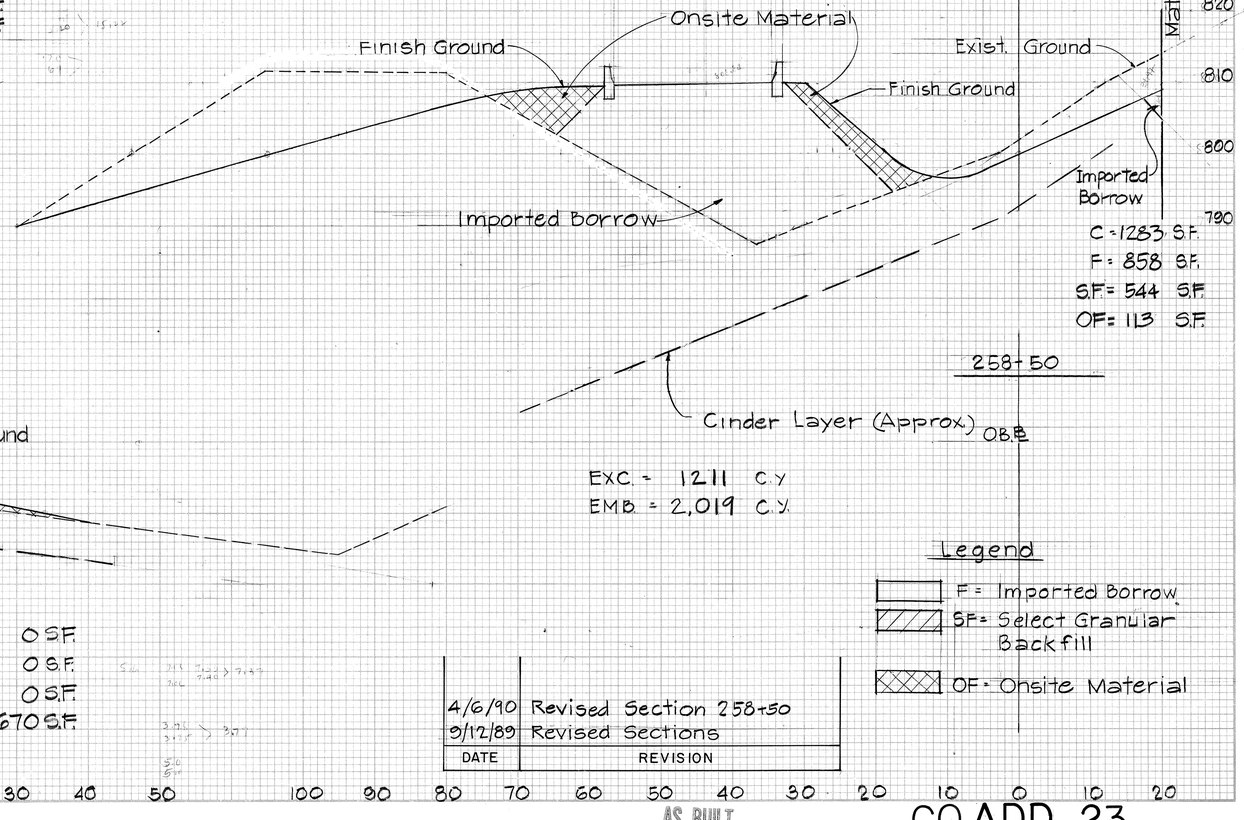

Legend

F = Imported Borrow

SF = Select Granular Backfill

OF = Onsite Material

DATE	REVISION
4/6/90	Revised Section 258+50
9/12/89	Revised Sections


AS BUILT

C.O. ADD. 23

FINAL SURVEY — SURVEYED: PLOTTED: NOTE BOOK: TEMPLATE: AREAS: AREAS CHECKED: NO. — BY — DATE

ORIGINAL SURVEY — SURVEYED: PLOTTED: NOTE BOOK: TEMPLATE: AREAS: AREAS CHECKED: NO. — BY — DATE

FED. ROAD DIST. NO.	STATE	FED. AID PROJ. NO.	FISCAL YEAR	SHEET NO.	TOTAL SHEETS
HAWAII	HAW.	I-H3-1(52)	1988	24	75

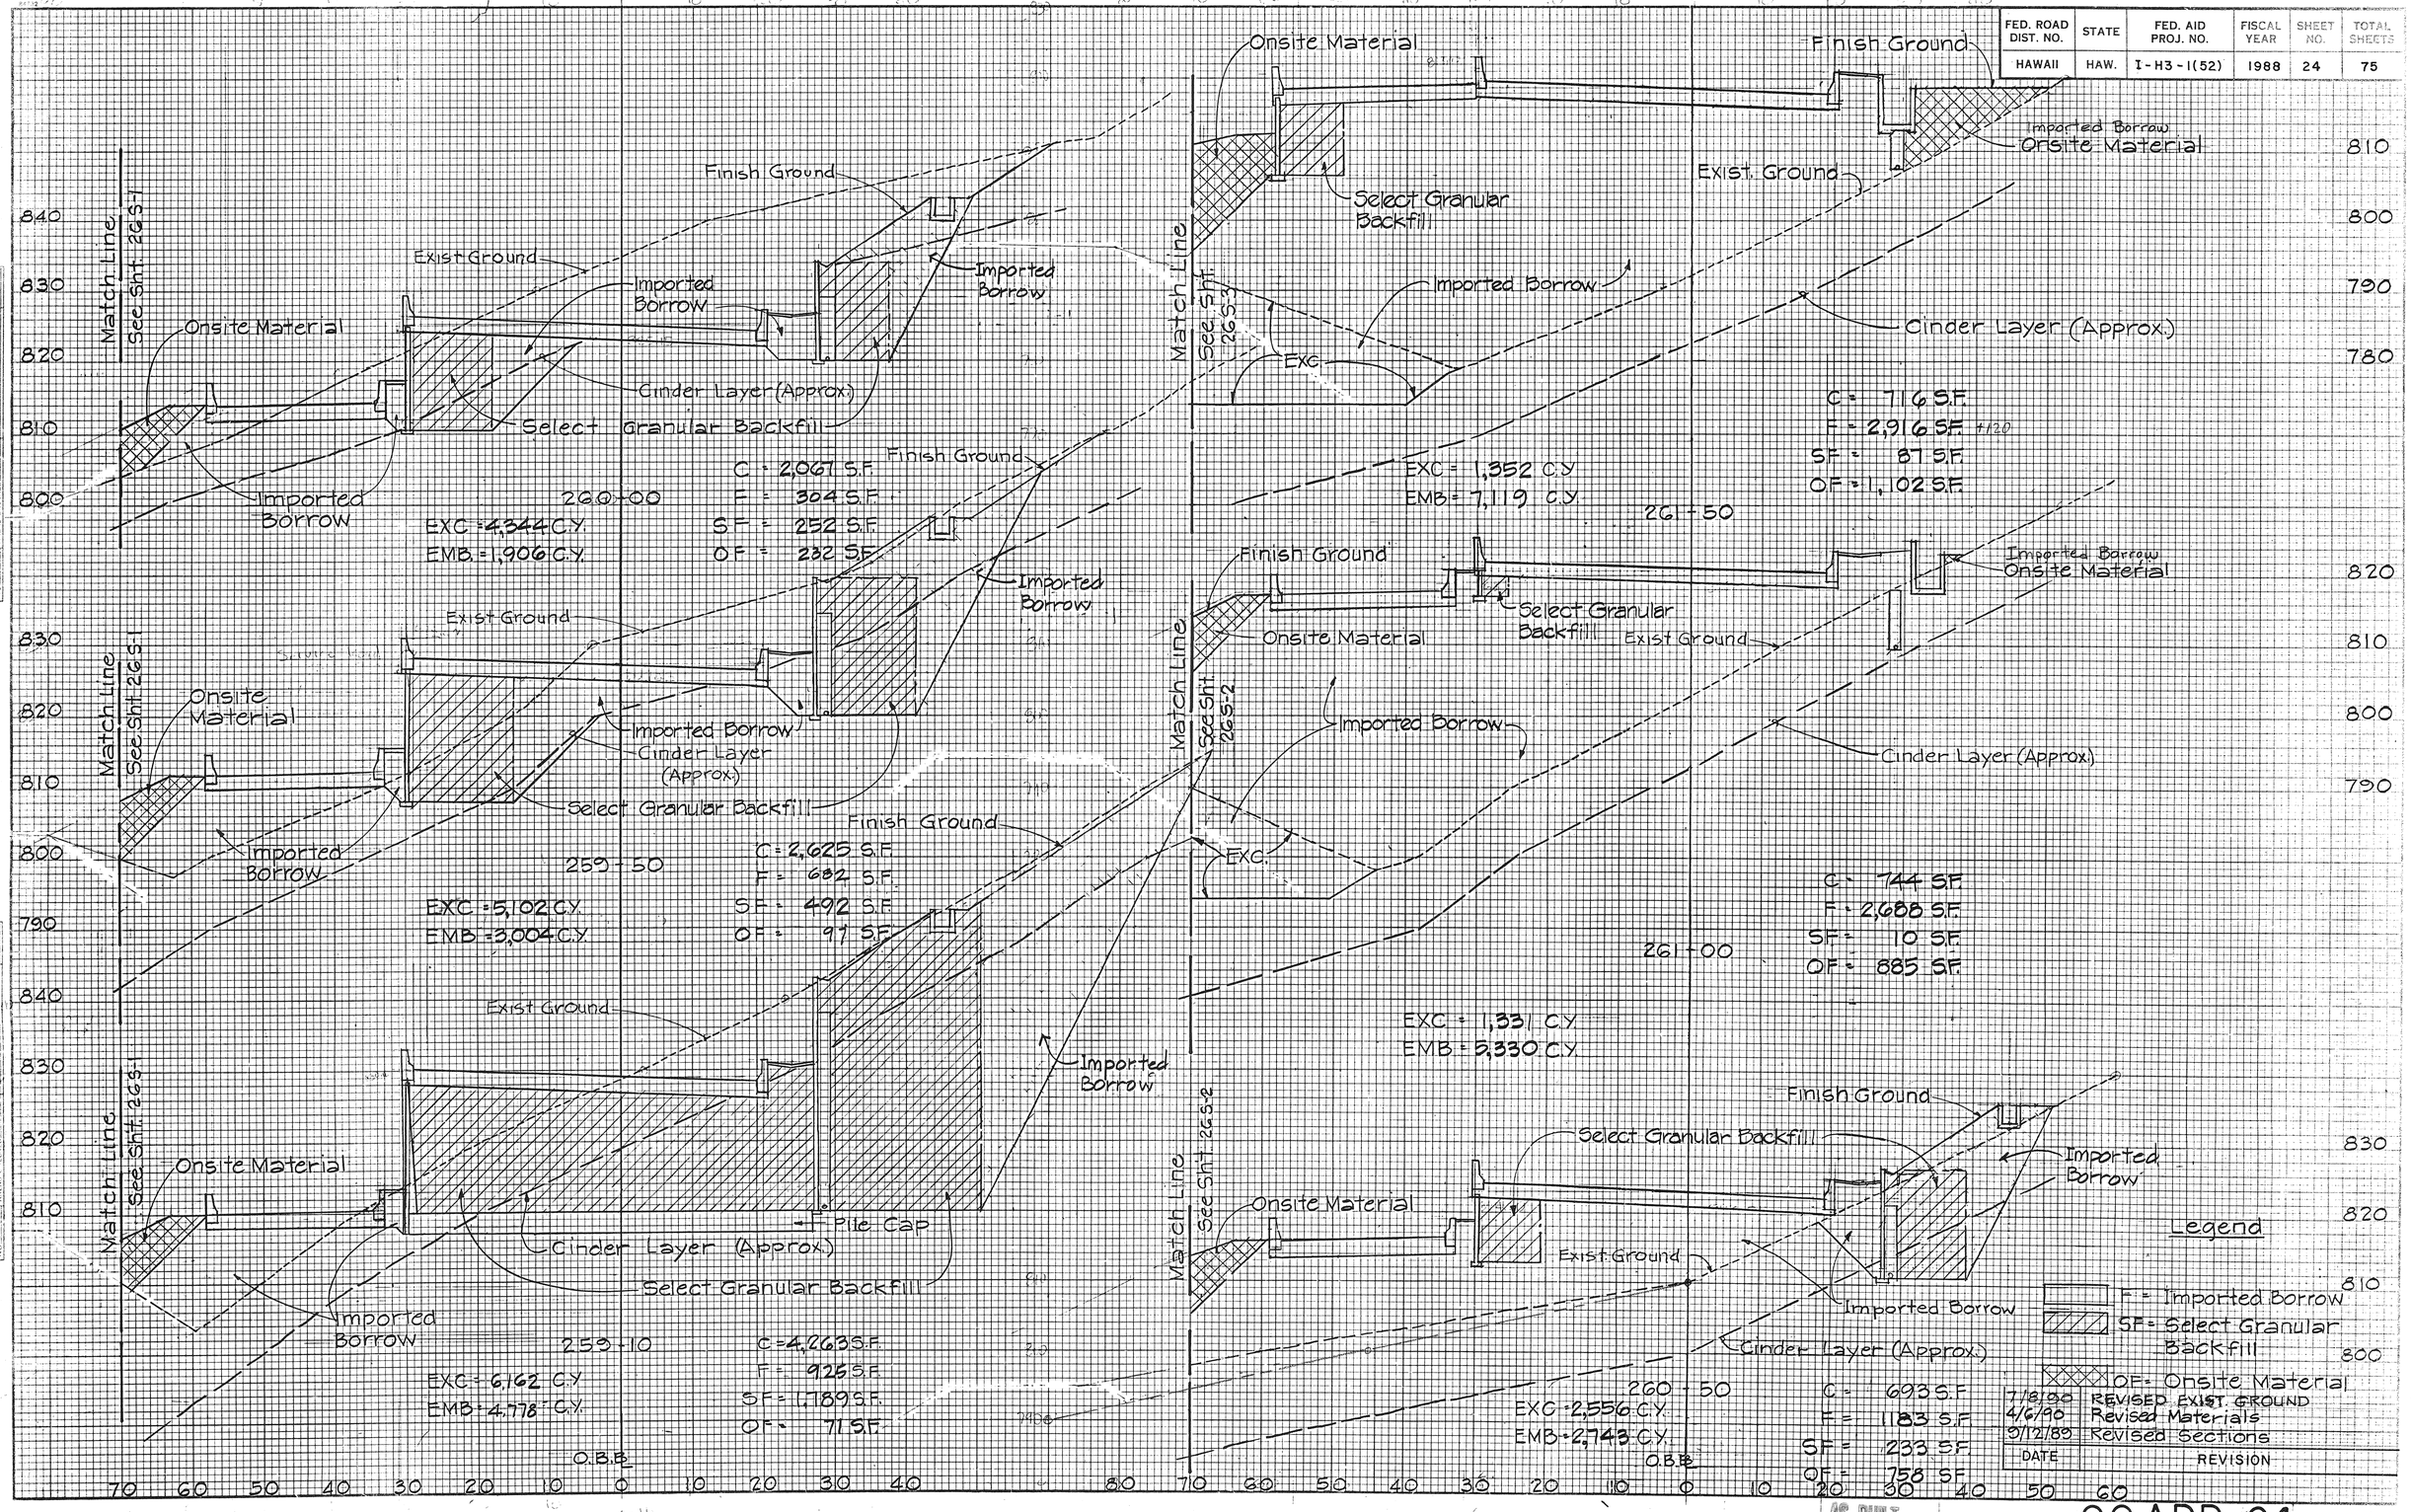

Legend

F = Imported Borrow

SF = Select Granular Backfill

OF = Onsite Material

DATE	REVISION
7/8/90	REVISED EXIST. GROUND
4/6/90	Revised Materials
9/12/89	Revised Sections

AS BUILT

C.O. ADD. 24


FINAL SURVEY — NOTE BOOK — NO — BY — DATE — SURVEYED — PLOTTED — TEMPLATE — AREAS — AREAS CHECKED

ORIGINAL SURVEY — NOTE BOOK — NO — BY — DATE — SURVEYED — PLOTTED — TEMPLATE — AREAS — AREAS CHECKED

FED. ROAD DIST. NO.	STATE	FED. AID PROJ. NO.	FISCAL YEAR	SHEET NO.	TOTAL SHEETS
HAWAII	HAW.	I-H3-1(52)	1988	25	75

FINAL SURVEY — NOTE BOOK — NO. — SURVEYED — PLOTTED — FIELD NOTE — AREAS — AREAS CHECKED — BY — DATE

ORIGINAL SURVEY — NOTE BOOK — NO. — SURVEYED — PLOTTED — FIELD NOTE — AREAS CHECKED — BY — DATE

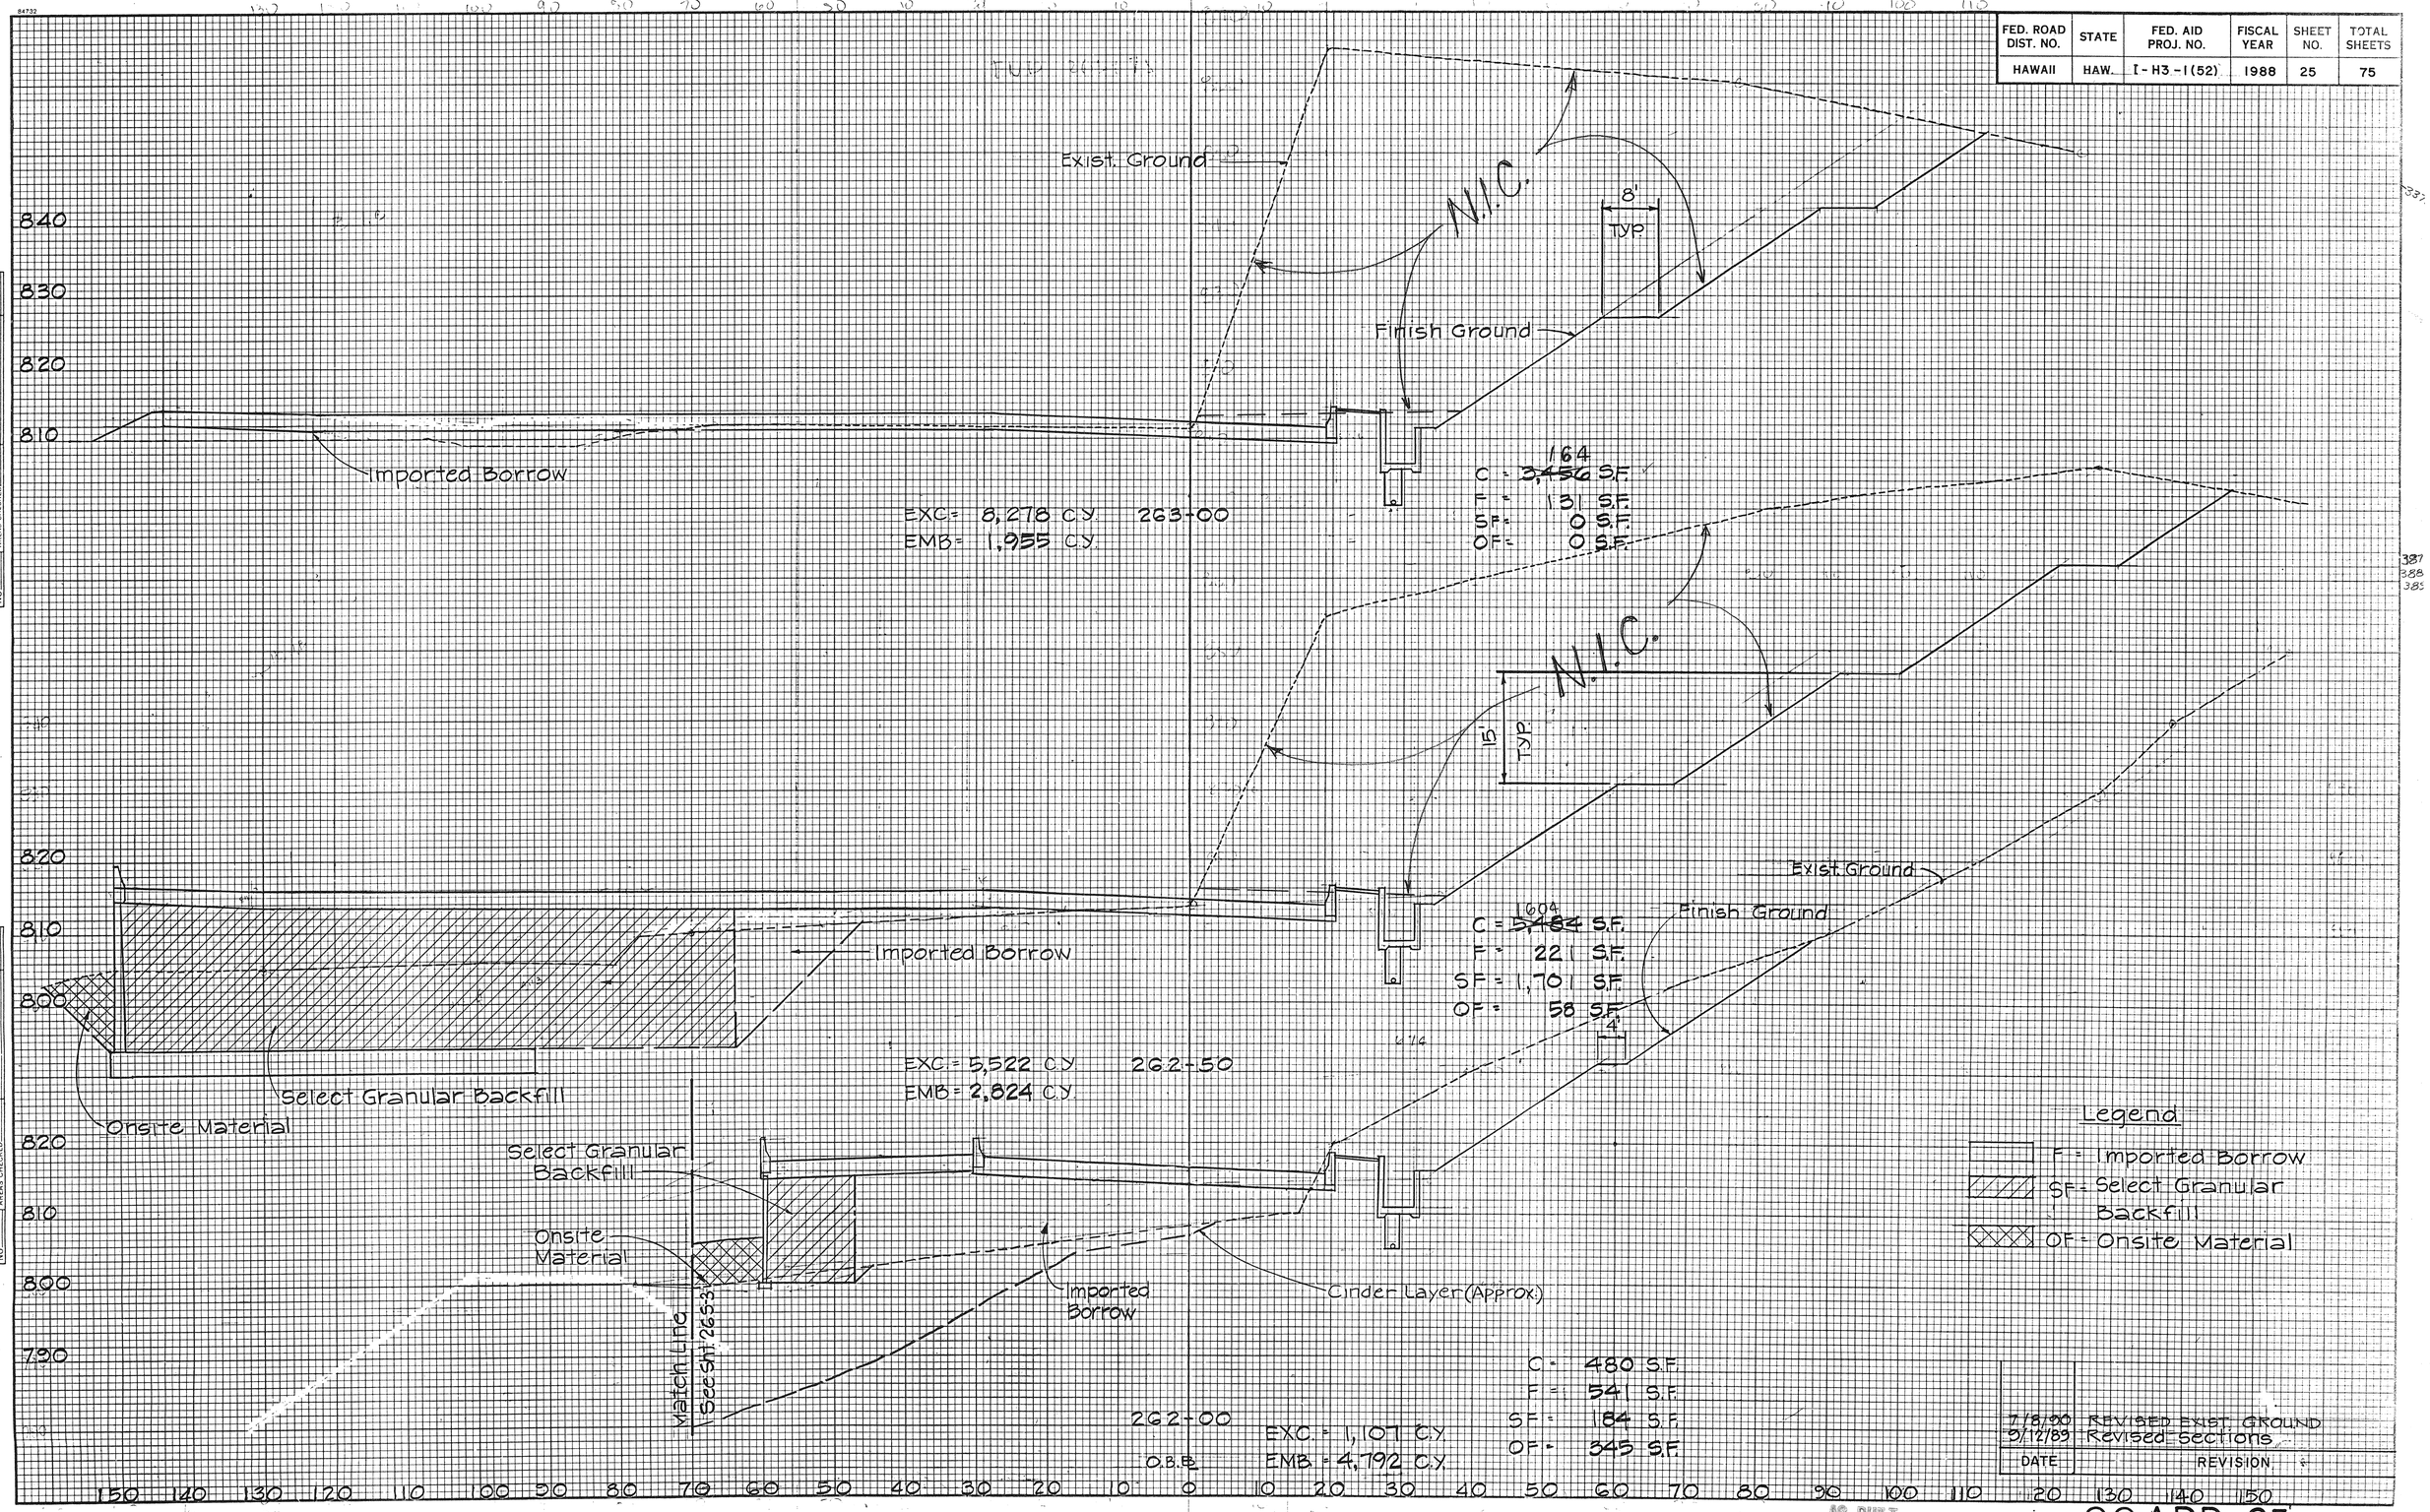

Legend

F = Imported Borrow

SF = Select Granular Backfill

OF = Onsite Material

DATE	REVISION
7/8/90	REVISED EXIST. GROUND
9/12/89	Revised Sections

AS BUILT

C.O. ADD. 25

FED. ROAD DIST. NO.	STATE	FED. AID PROJ. NO.	FISCAL YEAR	SHEET NO.	TOTAL SHEETS
HAWAII	HAW.	I-H3-1(52)	1988	26	75

84732

FINAL SURVEY
NOTE BOOK
NO.
SURVEYED
PLOTTED
TRACED
AREAS
AREAS CHECKED
BY
DATE

840
830
820
810
800
790

Exist Ground

8.1.B

EXC.= 1,455 C.Y.
EMB.= 0 C.Y.

STA 263+75

C= 715 S.F.
F= 0 S.F.
SF= 0 S.F.
OF= 0 S.F.

EARTHWORK SUMMARY

Total Excavation	43,890	C.Y.
Total Embankment	37,827	C.Y.
Select Granular Backfill	9,810	C.Y.
Imported Borrow	20,375	C.Y.

ORIGINAL SURVEY
NOTE BOOK
NO.
SURVEYED
PLOTTED
TRACED
AREAS
AREAS CHECKED
BY
DATE

850
840
830
820
810
800
790

Exist Ground
N.I.C.
Finish Ground

8.1.B. INBOUND

EXC= 5,447 C.Y.
EMB= 21 C.Y.

263+50

C= ~~2,242~~ 497 S.F.
F= 0 S.F.
SF= 0 S.F.
OF= 0 S.F.

0.5.1.B

50 40 30 20 10 0 10 20 30 40 50 60 70 80 90 100 110 120 130

DATE	REVISION
7/8/90	Revised Exist Ground
4/6/90	Revised Quantities
9/12/89	Revised Sections


AS BUILT

C.O. ADD. 26

FED. ROAD DIST. NO.	STATE	FED. AID PROJ. NO.	FISCAL YEAR	SHEET NO.	TOTAL SHEETS
HAWAII	HAW.	I-H3-1(52)	1988	26	75

FINAL SURVEY
NOTE BOOK
NO.
SURVEYED
PLOTTED
TEMPLATE
AREAS
AREAS CHECKED
BY
DATE

ORIGINAL SURVEY
NOTE BOOK
NO.
SURVEYED
PLOTTED
TEMPLATE
AREAS
AREAS CHECKED
BY
DATE

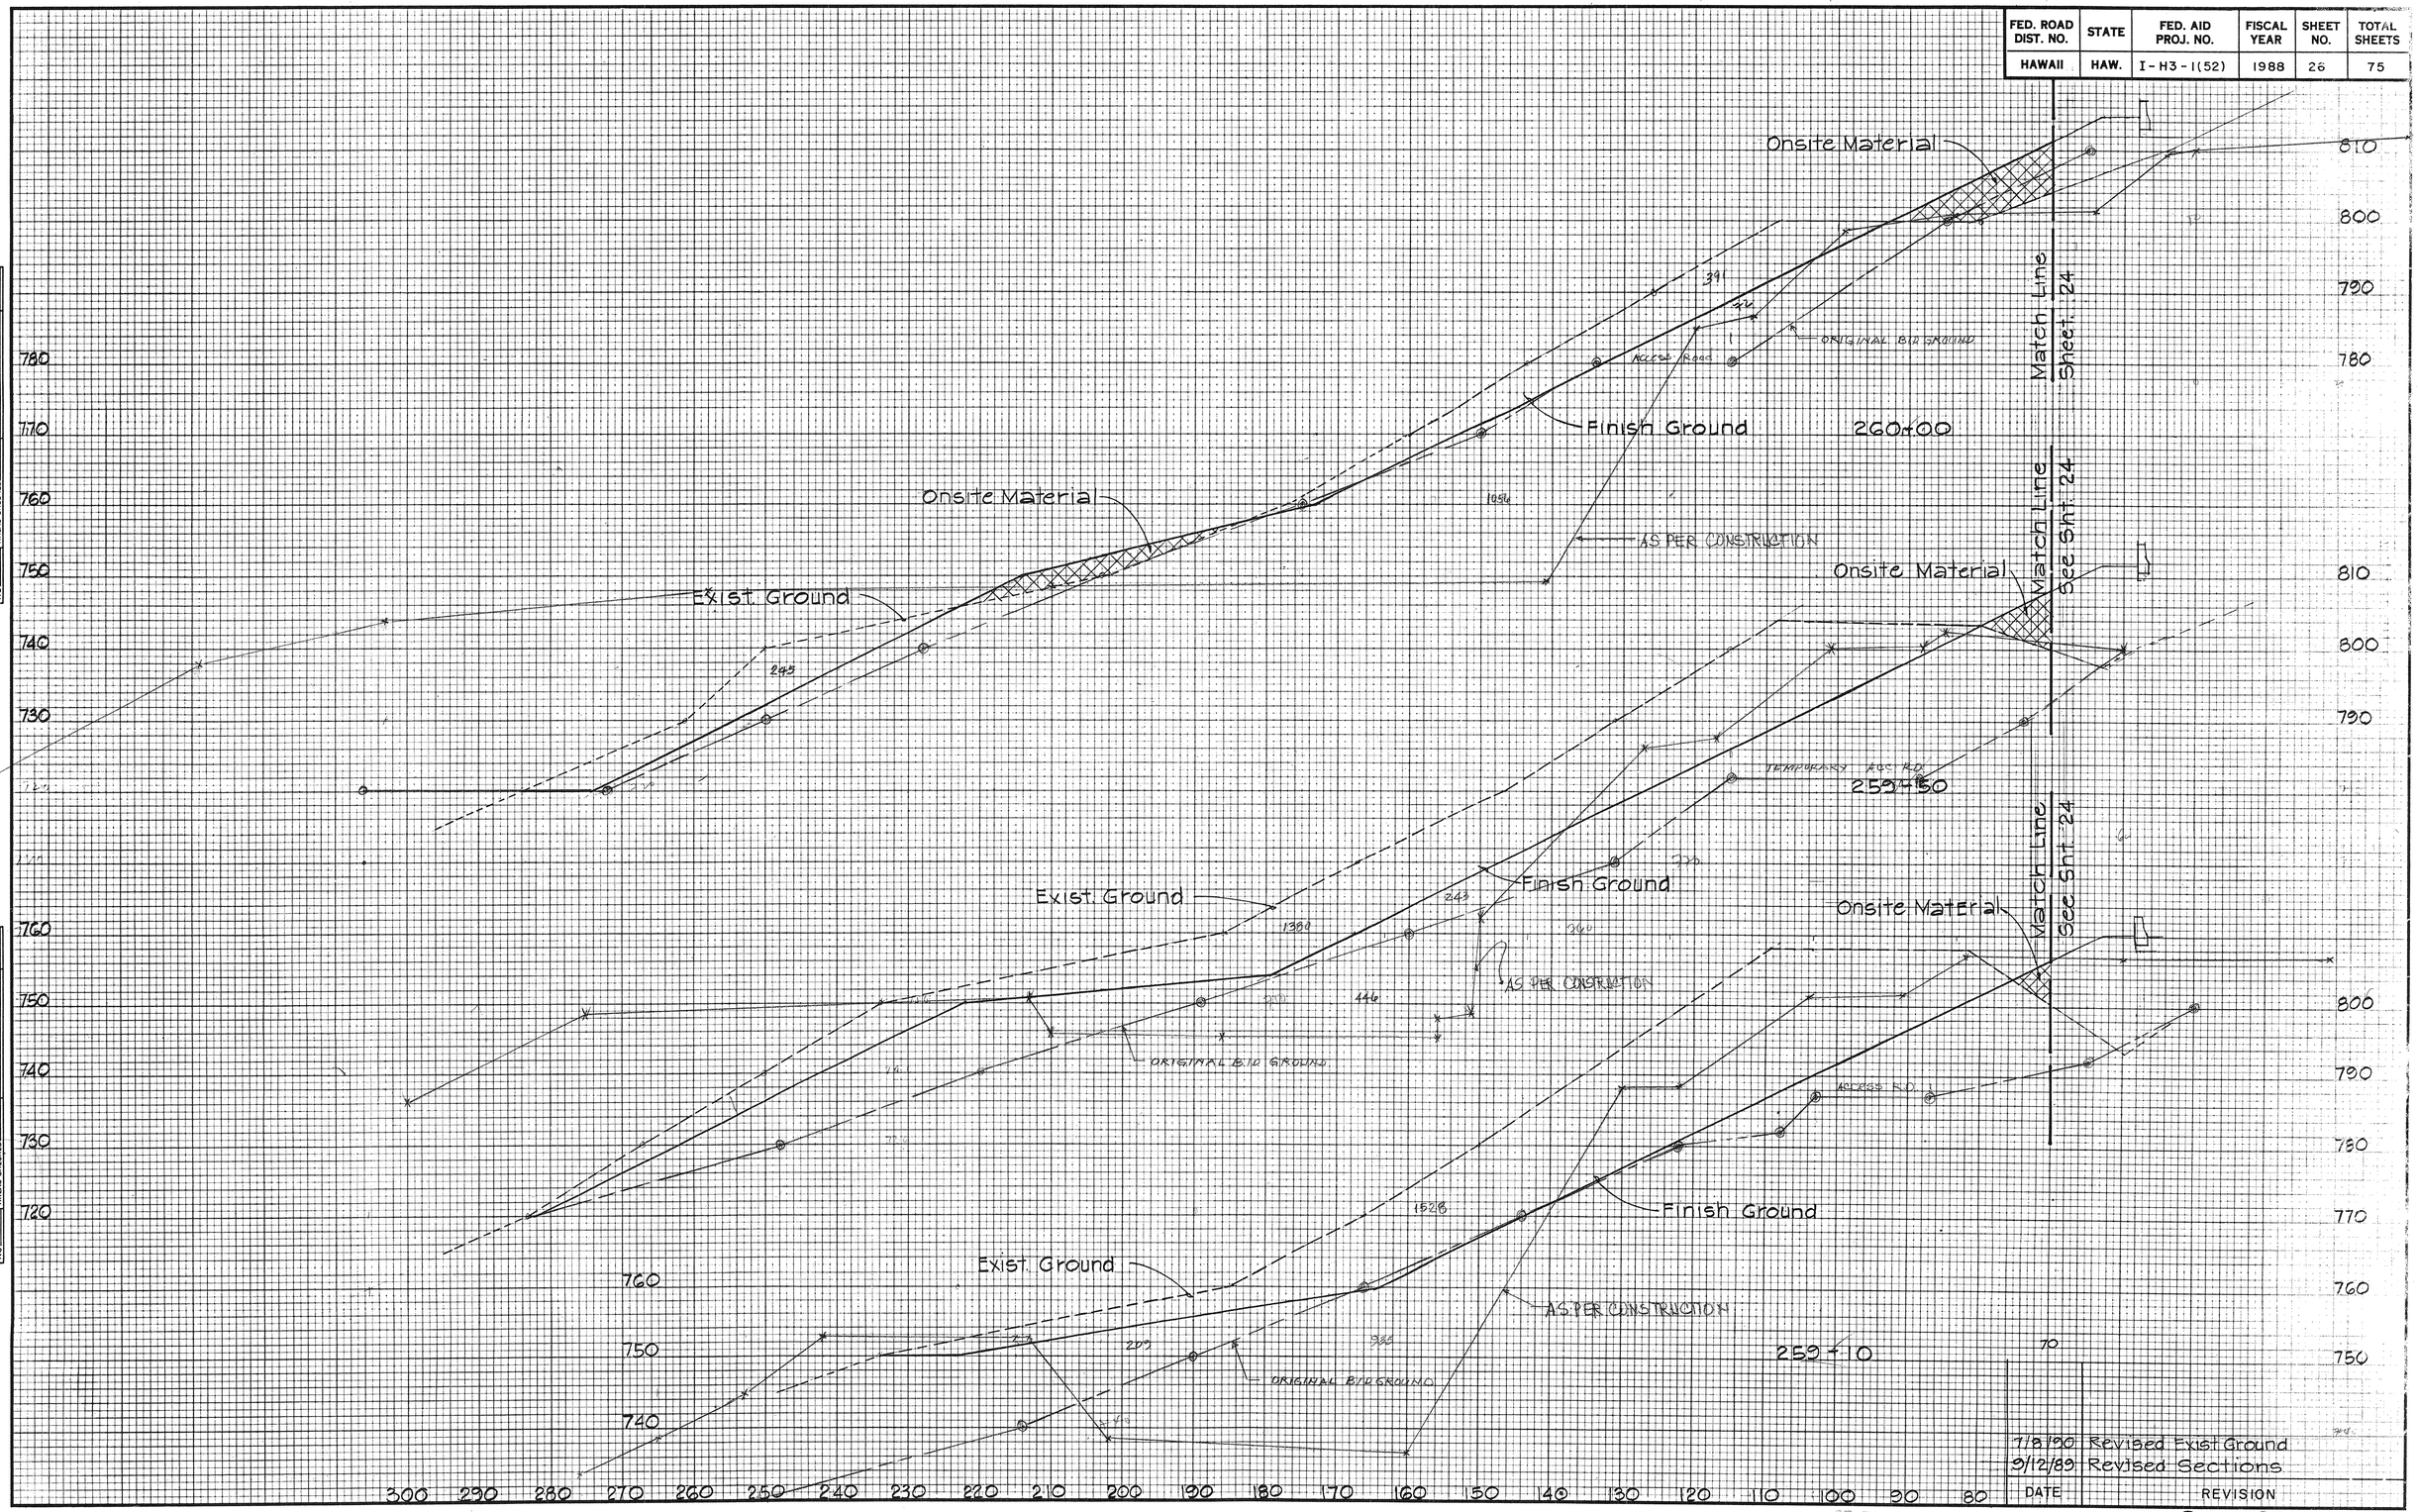

7/8/90 Revised Exist. Ground
9/12/89 Revised Sections
DATE REVISION


AS BUILT

C.O. 26S-1

FED. ROAD DIST. NO.	STATE	FED. AID PROJ. NO.	FISCAL YEAR	SHEET NO.	TOTAL SHEETS
HAWAII	HAW.	I-H3-1(52)	1988	26	75

FINAL SURVEY — NOTE BOOK NO. — SURVEYED, PLOTTED, TEMPLATE, AREAS, AREAS CHECKED — BY — DATE

ORIGINAL SURVEY — NOTE BOOK NO. — SURVEYED, PLOTTED, TEMPLATE, AREAS, AREAS CHECKED — BY — DATE

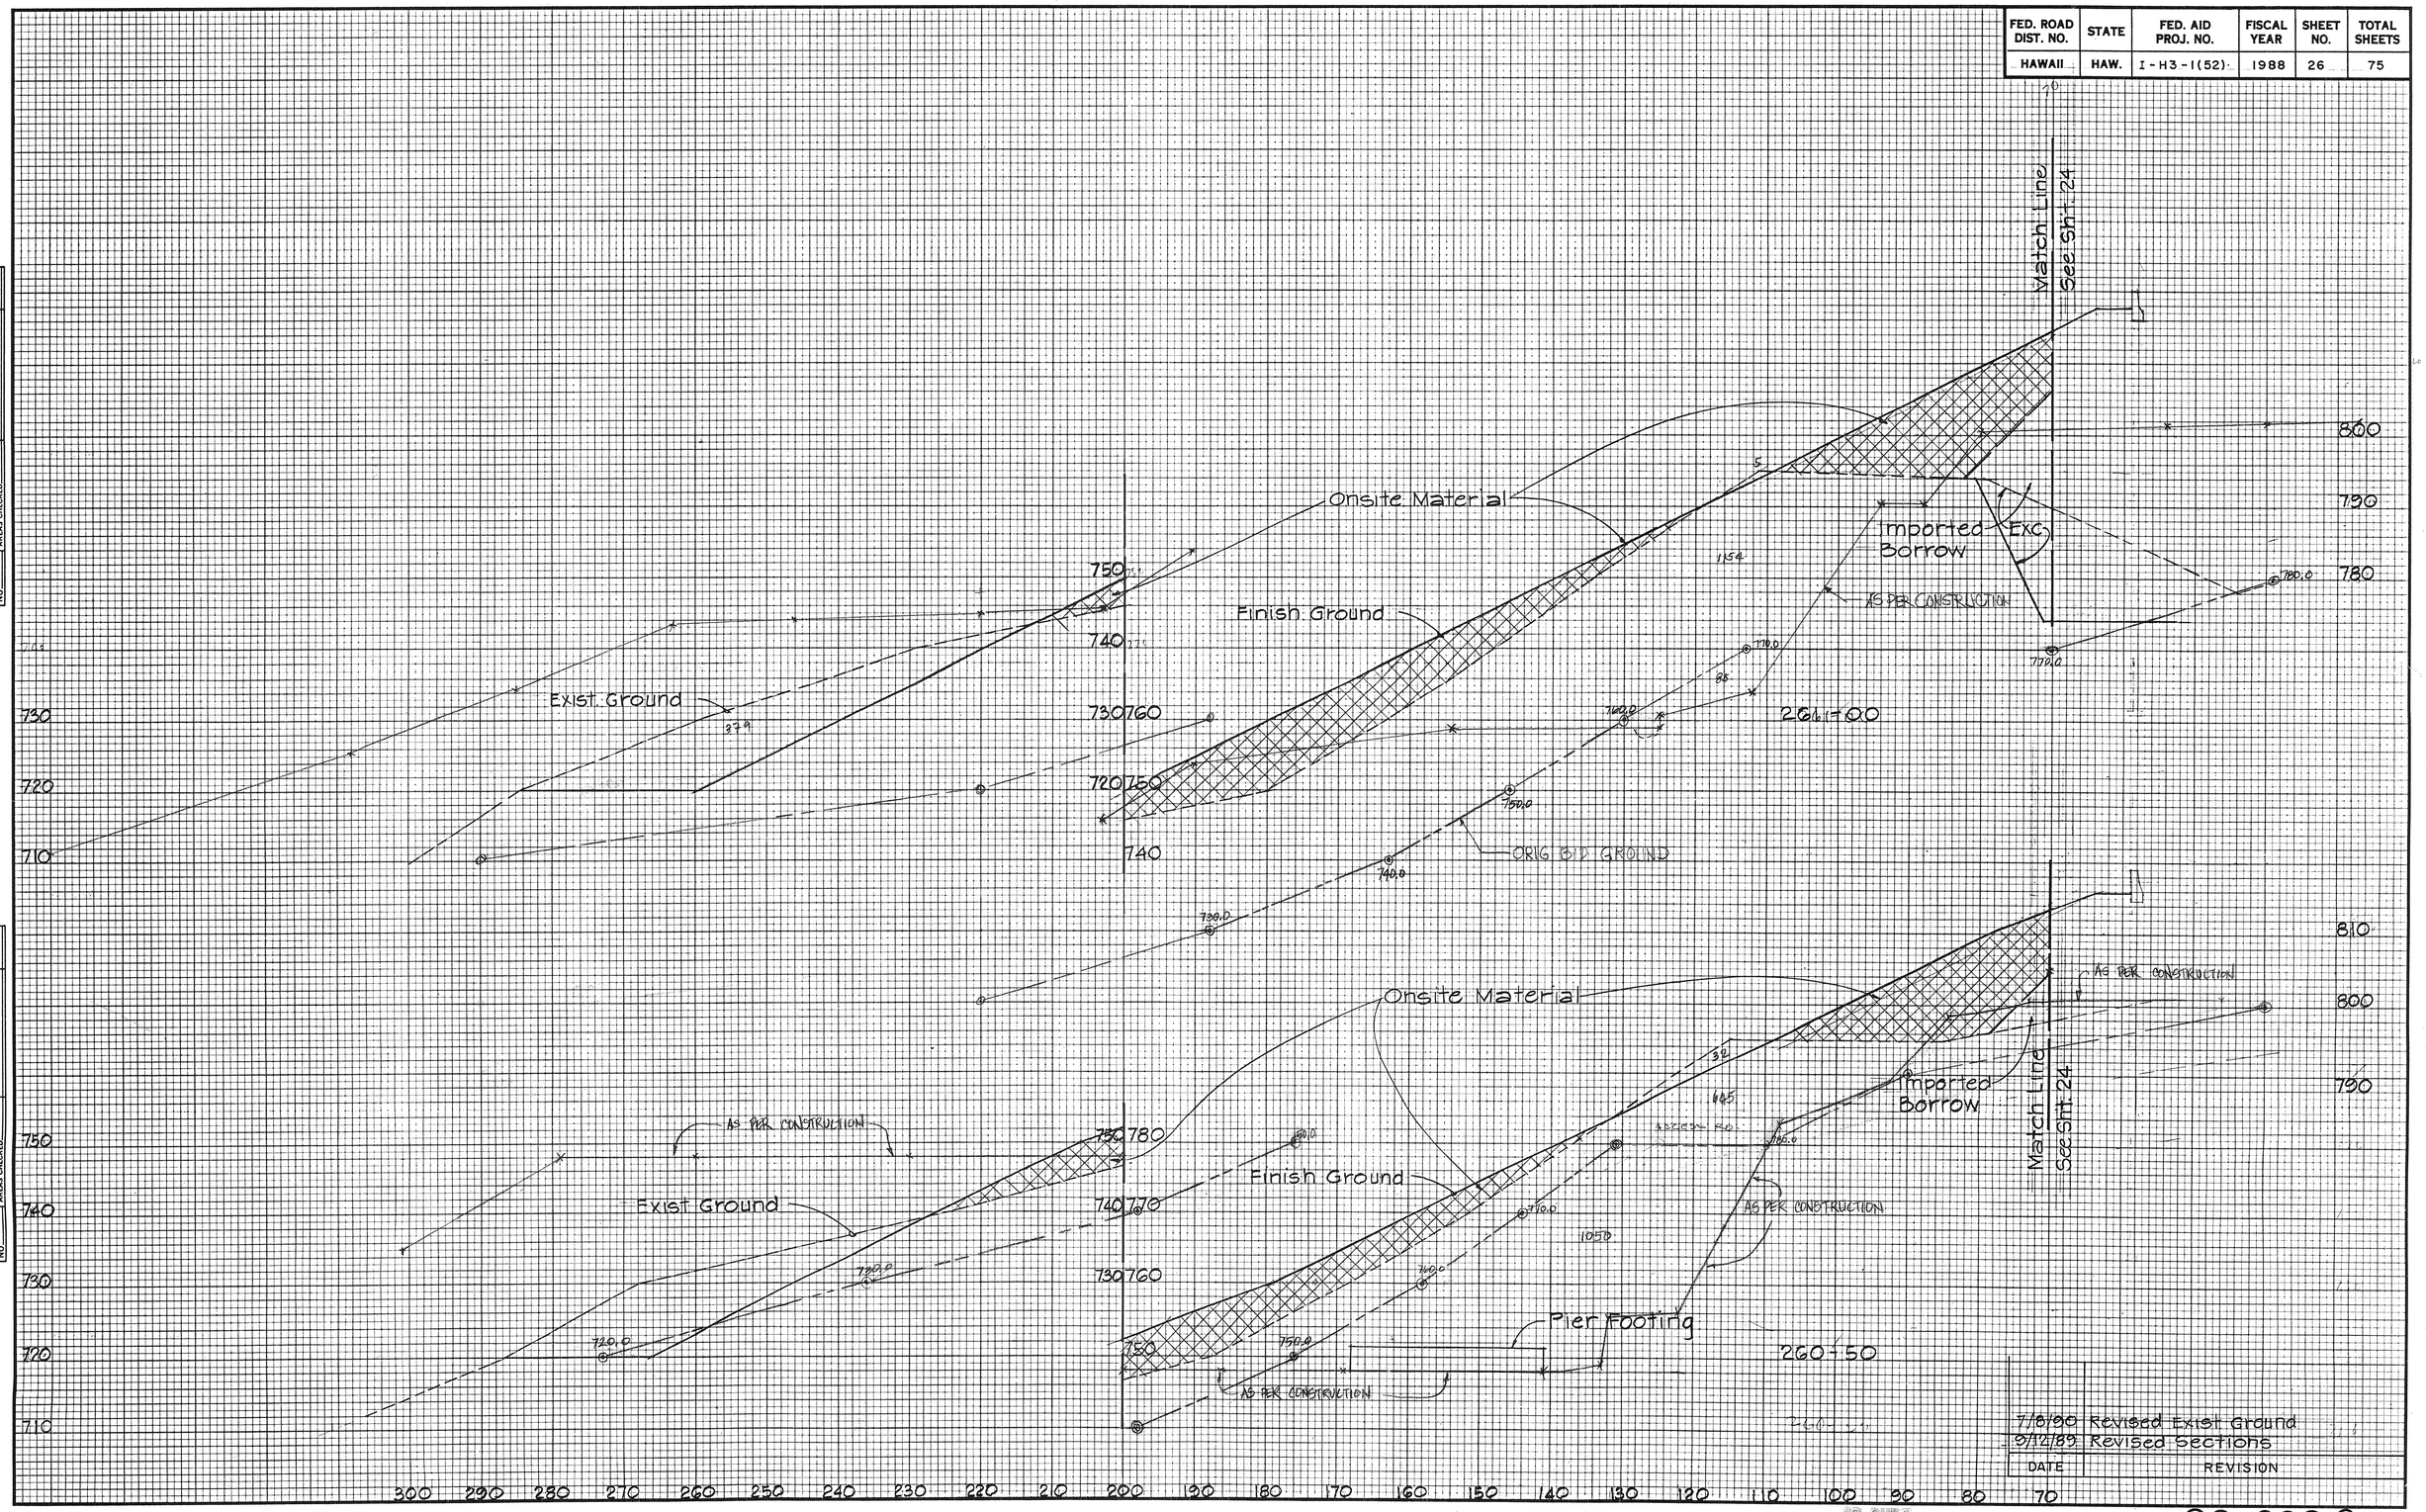

DATE	REVISION
7/8/90	Revised Exist Ground
9/12/89	Revised Sections


AS BUILT

C.O. 26S-2

FED. ROAD DIST. NO.	STATE	FED. AID PROJ. NO.	FISCAL YEAR	SHEET NO.	TOTAL SHEETS
HAWAII	HAW.	I-H3-1(52)	1988	26	75

FINAL SURVEY
NOTE BOOK
NO.
SURVEYED
PLOTTED
TEMPLATE
AREAS
AREAS CHECKED
BY
DATE

ORIGINAL SURVEY
NOTE BOOK
NO.
SURVEYED
PLOTTED
TEMPLATE
AREAS
AREAS CHECKED
BY
DATE

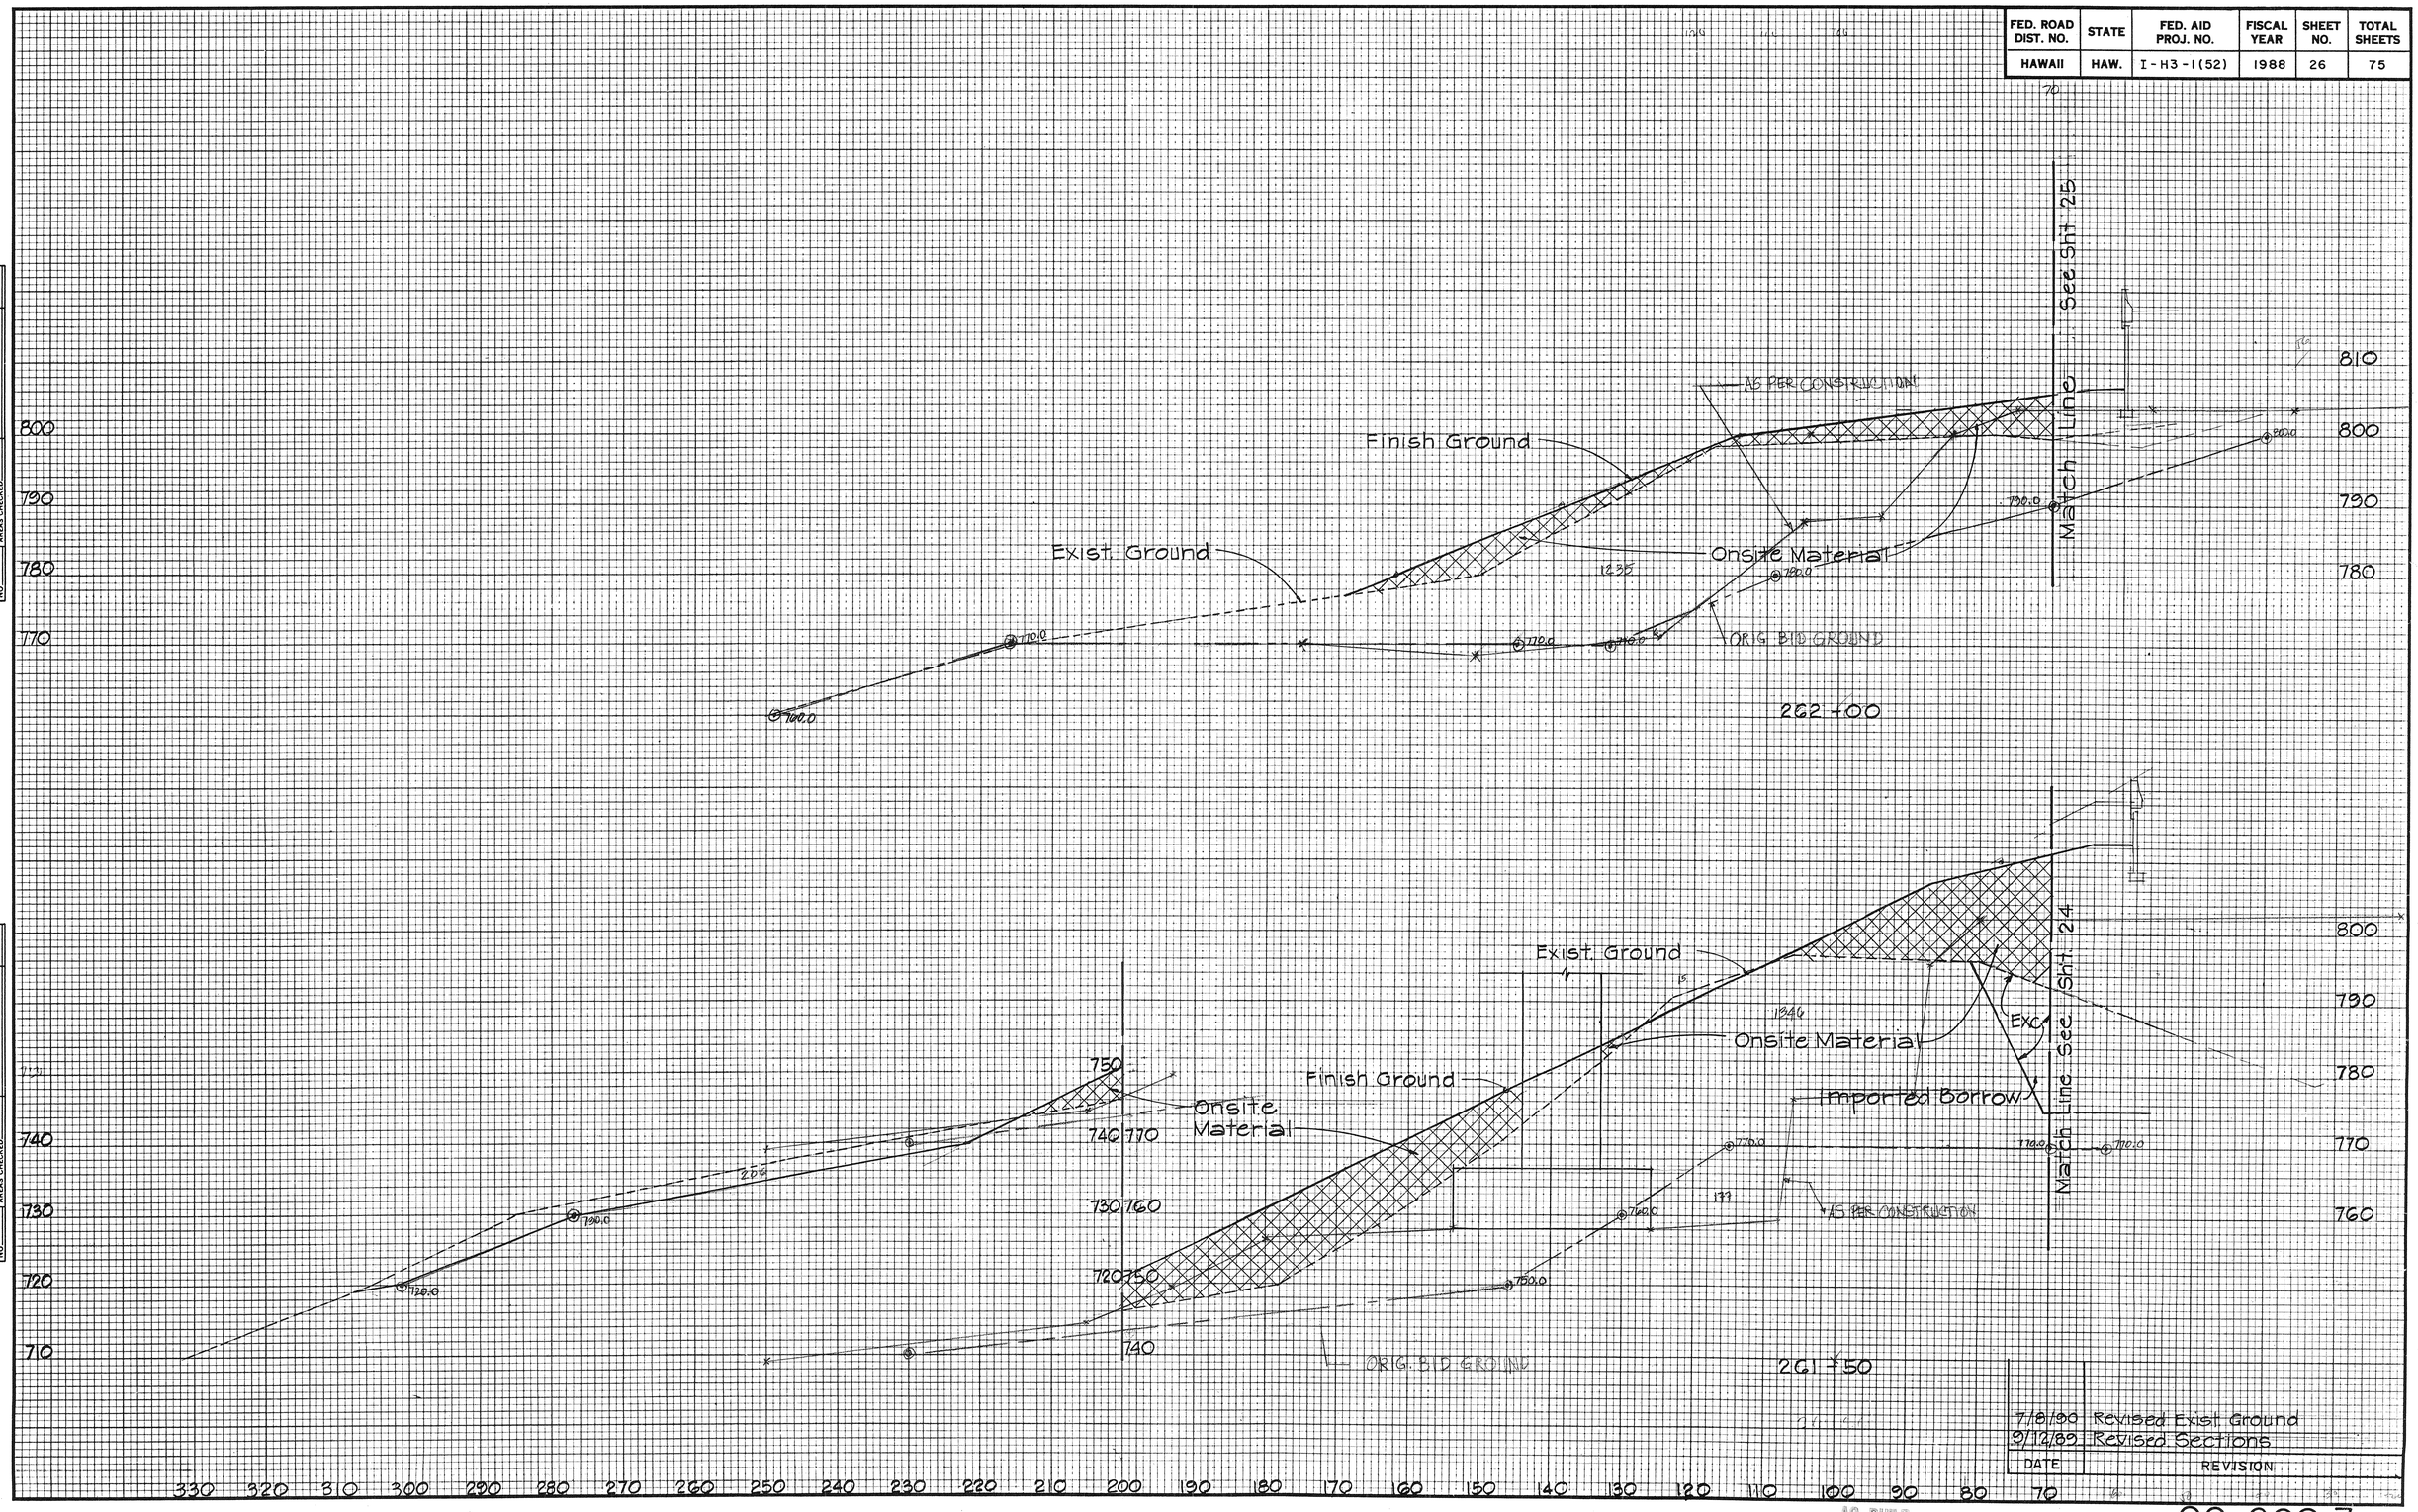


DATE	REVISION
7/8/90	Revised Exist Ground
9/12/89	Revised Sections


C.O. 26S-3

100269

FED. ROAD DIST. NO.	STATE	FED. AID PROJ. NO.	FISCAL YEAR	SHEET NO.	TOTAL SHEETS
HAWAII	HAW.	I-H3-1(52)	1988	26	75

FINAL SURVEY		BY	DATE
	SURVEYED		
	PLOTTED		
NOTE BOOK	TEMPLATE		
	AREAS		
NO	AREAS CHECKED		

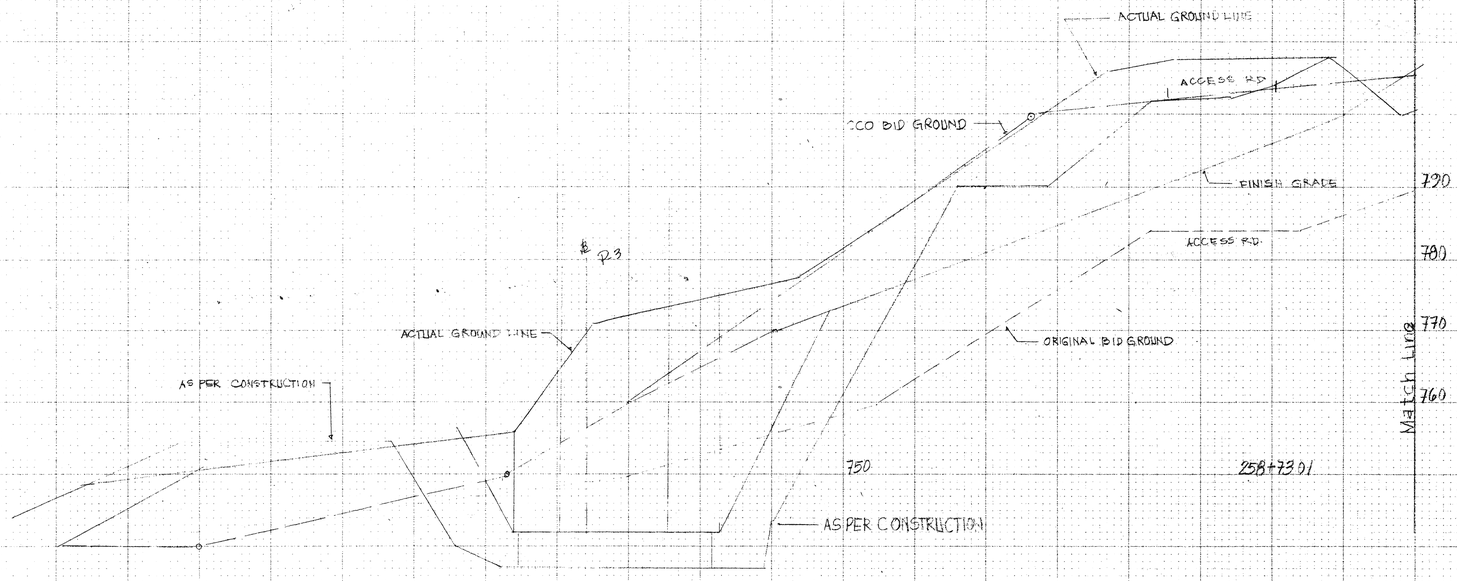

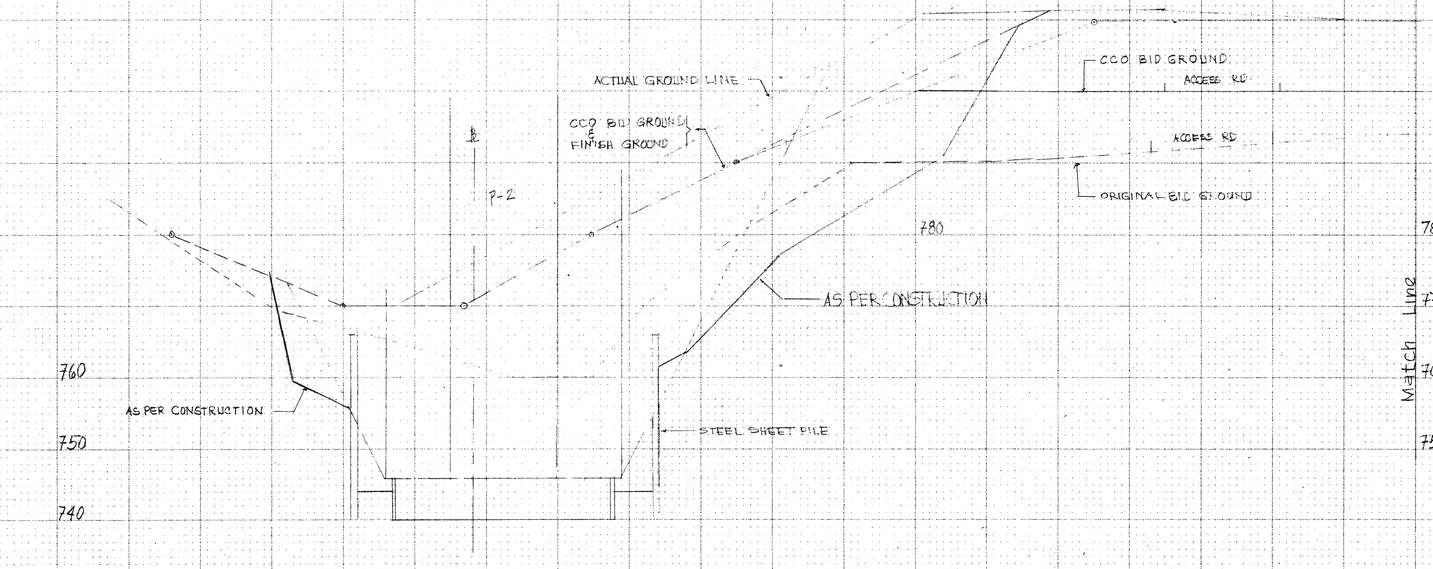

ORIGINAL SURVEY		BY	DATE
	SURVEYED		
	PLOTTED		
NOTE BOOK	TEMPLATE		
	AREAS		
NO	AREAS CHECKED		

AS BUILT


C.O. 26S-4

100269

FED. ROAD DIST. NO.	STATE	FED. AID PROJ. NO.	FISCAL YEAR	SHEET NO.	TOTAL SHEETS
HAWAII	HAW.	I-H3-1(52)	1988	26	75

FINAL SURVEY		DATE
NOTE BOOK	SURVEYED	BY
NO.	PLOTTED	
	TEMPLATE	
	AREAS	
	AREAS CHECKED	

ORIGINAL SURVEY		DATE
NOTE BOOK	SURVEYED	BY
NO.	PLOTTED	
	TEMPLATE	
	AREAS	
	AREAS CHECKED	

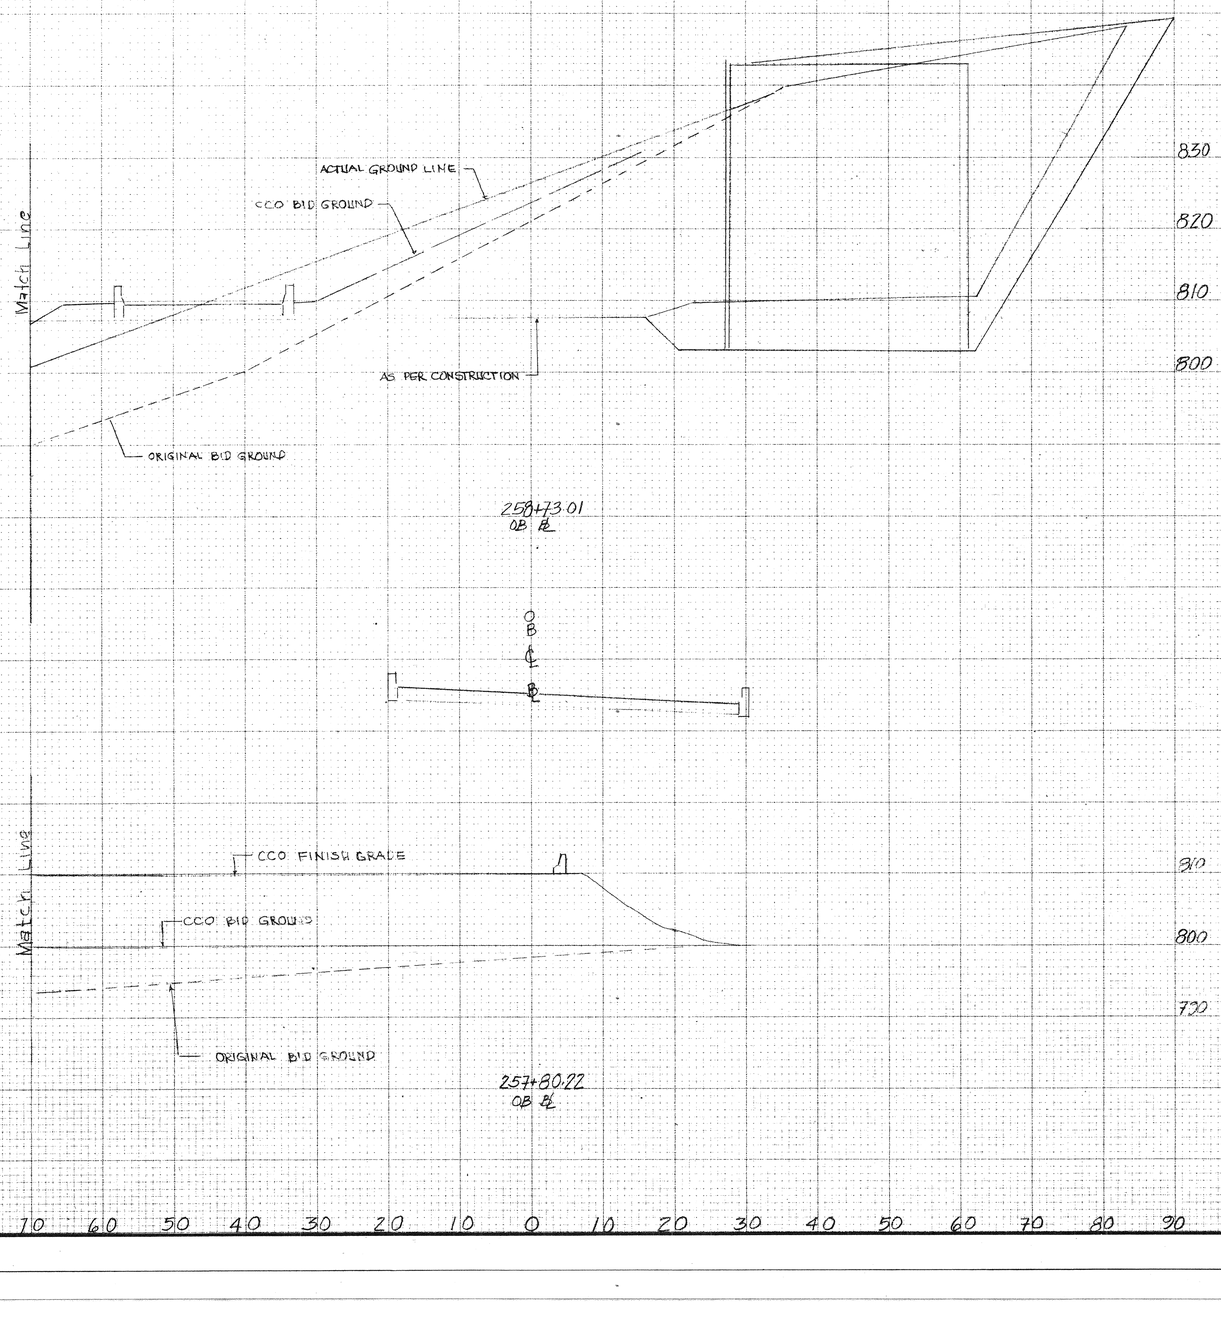

AS BUILT

C.O. 26S-5