FED. ROAD DIST. NO.	STATE	FED. AID PROJ. NO.	FISCAL YEAR	SHEET NO.	TOTAL SHEETS
HAWAII	HAW.	I-H3-1(40)	1989	1	191

INDEX TO DRAWINGS

(SEE SHEET C1 FOR EXPANDED INDEX TO DRAWINGS)

SHEET NO.	DESCRIPTION
1	TITLE SHEET
2-64	C1 THRU C63
65-66	D1 & D2
67-89	L1 THRU L23
90-119	A1 THRU A30
120-158	S1 THRU S39
159-173	M1 THRU M15
174-179	E1 THRU E6
179A	E6A
180-190	E7 THRU E17

STATE OF HAWAII

DEPARTMENT OF TRANSPORTATION

HIGHWAYS DIVISION

HONOLULU, HAWAII

"AS-BUILT"

PLANS FOR

CONSTRUCTION OF A PORTION OF

INTERSTATE ROUTE H-3

ANIMAL QUARANTINE STATION FUNCTIONAL REPLACEMENT

FEDERAL AID INTERSTATE PROJECT NO. I-H3-1(40)

DISTRICT OF EWA

ISLAND OF OAHU

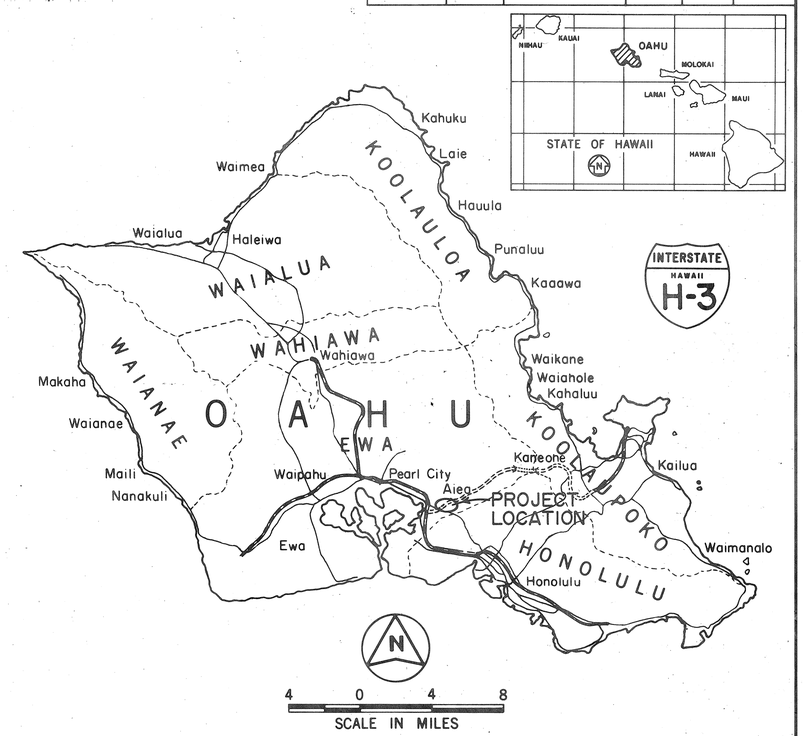

FEDERAL AID INTERSTATE PROJECTS PREVIOUSLY CONSTRUCTED OR UNDER CONSTRUCTION

CHANGES MADE DURING CONSTRUCTION HAVE BEEN INCORPORATED ON THESE PLANS EXCEPT CHANGES IN THE ORIGINAL THEORETICAL QUANTITIES. FOR ACTUAL QUANTITIES, REFER TO PROJECT LEDGER AND/OR COMPUTATION BOOK.

RESIDENT ENGINEER — DATE 9-12-90

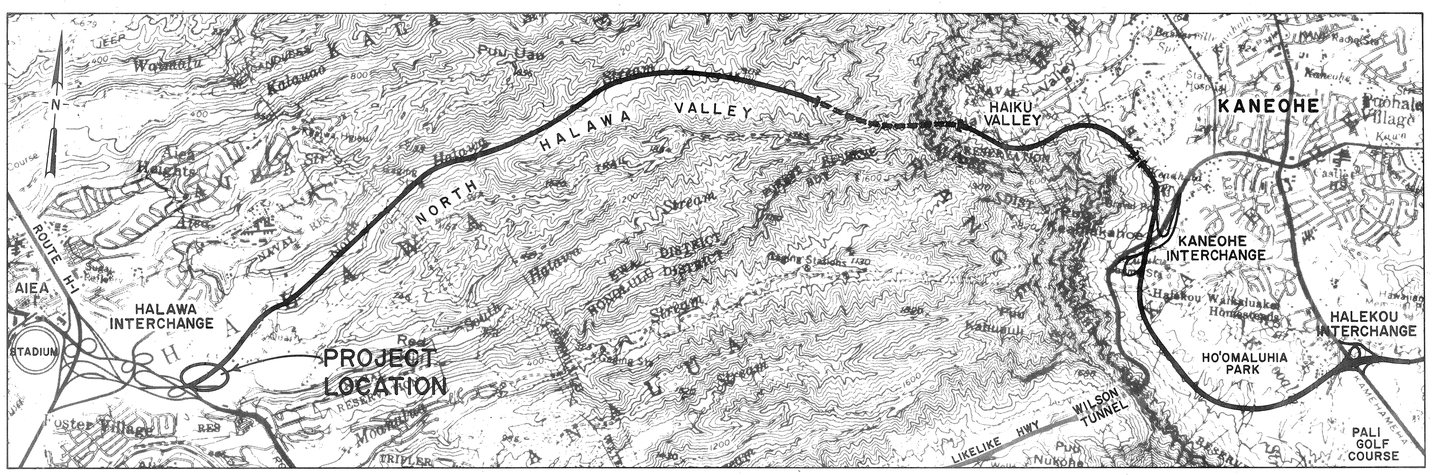

LAYOUT PLAN

DESIGNED BY	P. S. & E. BY	PHONE /	DATE
R. M. SATO & ASSOC.	R. MIKAMI	548-7468	SEPT. 1988

DEPARTMENT OF TRANSPORTATION
FEDERAL HIGHWAY ADMINISTRATION
APPROVED:
for DIVISION ADMINISTRATOR — DATE 9/26/88

DEPARTMENT OF TRANSPORTATION
STATE OF HAWAII
APPROVED:
DIR. OF TRANSPORTATION — DATE 8/13/88

TI

1