

ORIGINAL PLAN	SURVEY PLOTTED BY	DATE
NOTE BOOK	DRAWN BY	
	DESIGNED BY	
	CHECKED BY	


PLANT LIST

QUANTITY	BOTANICAL NAME	COMMON NAME	DESCRIPTION
GROUND COVER AND GRASS			
19,000 #	LOLIUM MULTIFOLIUM	ITALIAN RYE GRASS	SEEDING
19,000 #	WEDELIA TRILOBATA	WEDELIA	1QT, 1"O.C.

GENERAL NOTES:

1. THE CONTRACTOR SHALL BE RESPONSIBLE FOR VERIFYING ALL QUANTITIES, MEASUREMENTS AND SITE CONDITION, INCLUDING LOCATION OF ALL UTILITIES.
2. PLANTING WILL NOT COMMENCE UNTIL THE PLANTING AREA IS PREPARED TO FINISH GRADE.

FED. ROAD DIST. NO.	STATE	FED. AID PROJ. NO.	FISCAL YEAR	SHEET NO.	TOTAL SHEETS
HAWAII	HAW.	I-H3-1(51)	1989	39	106

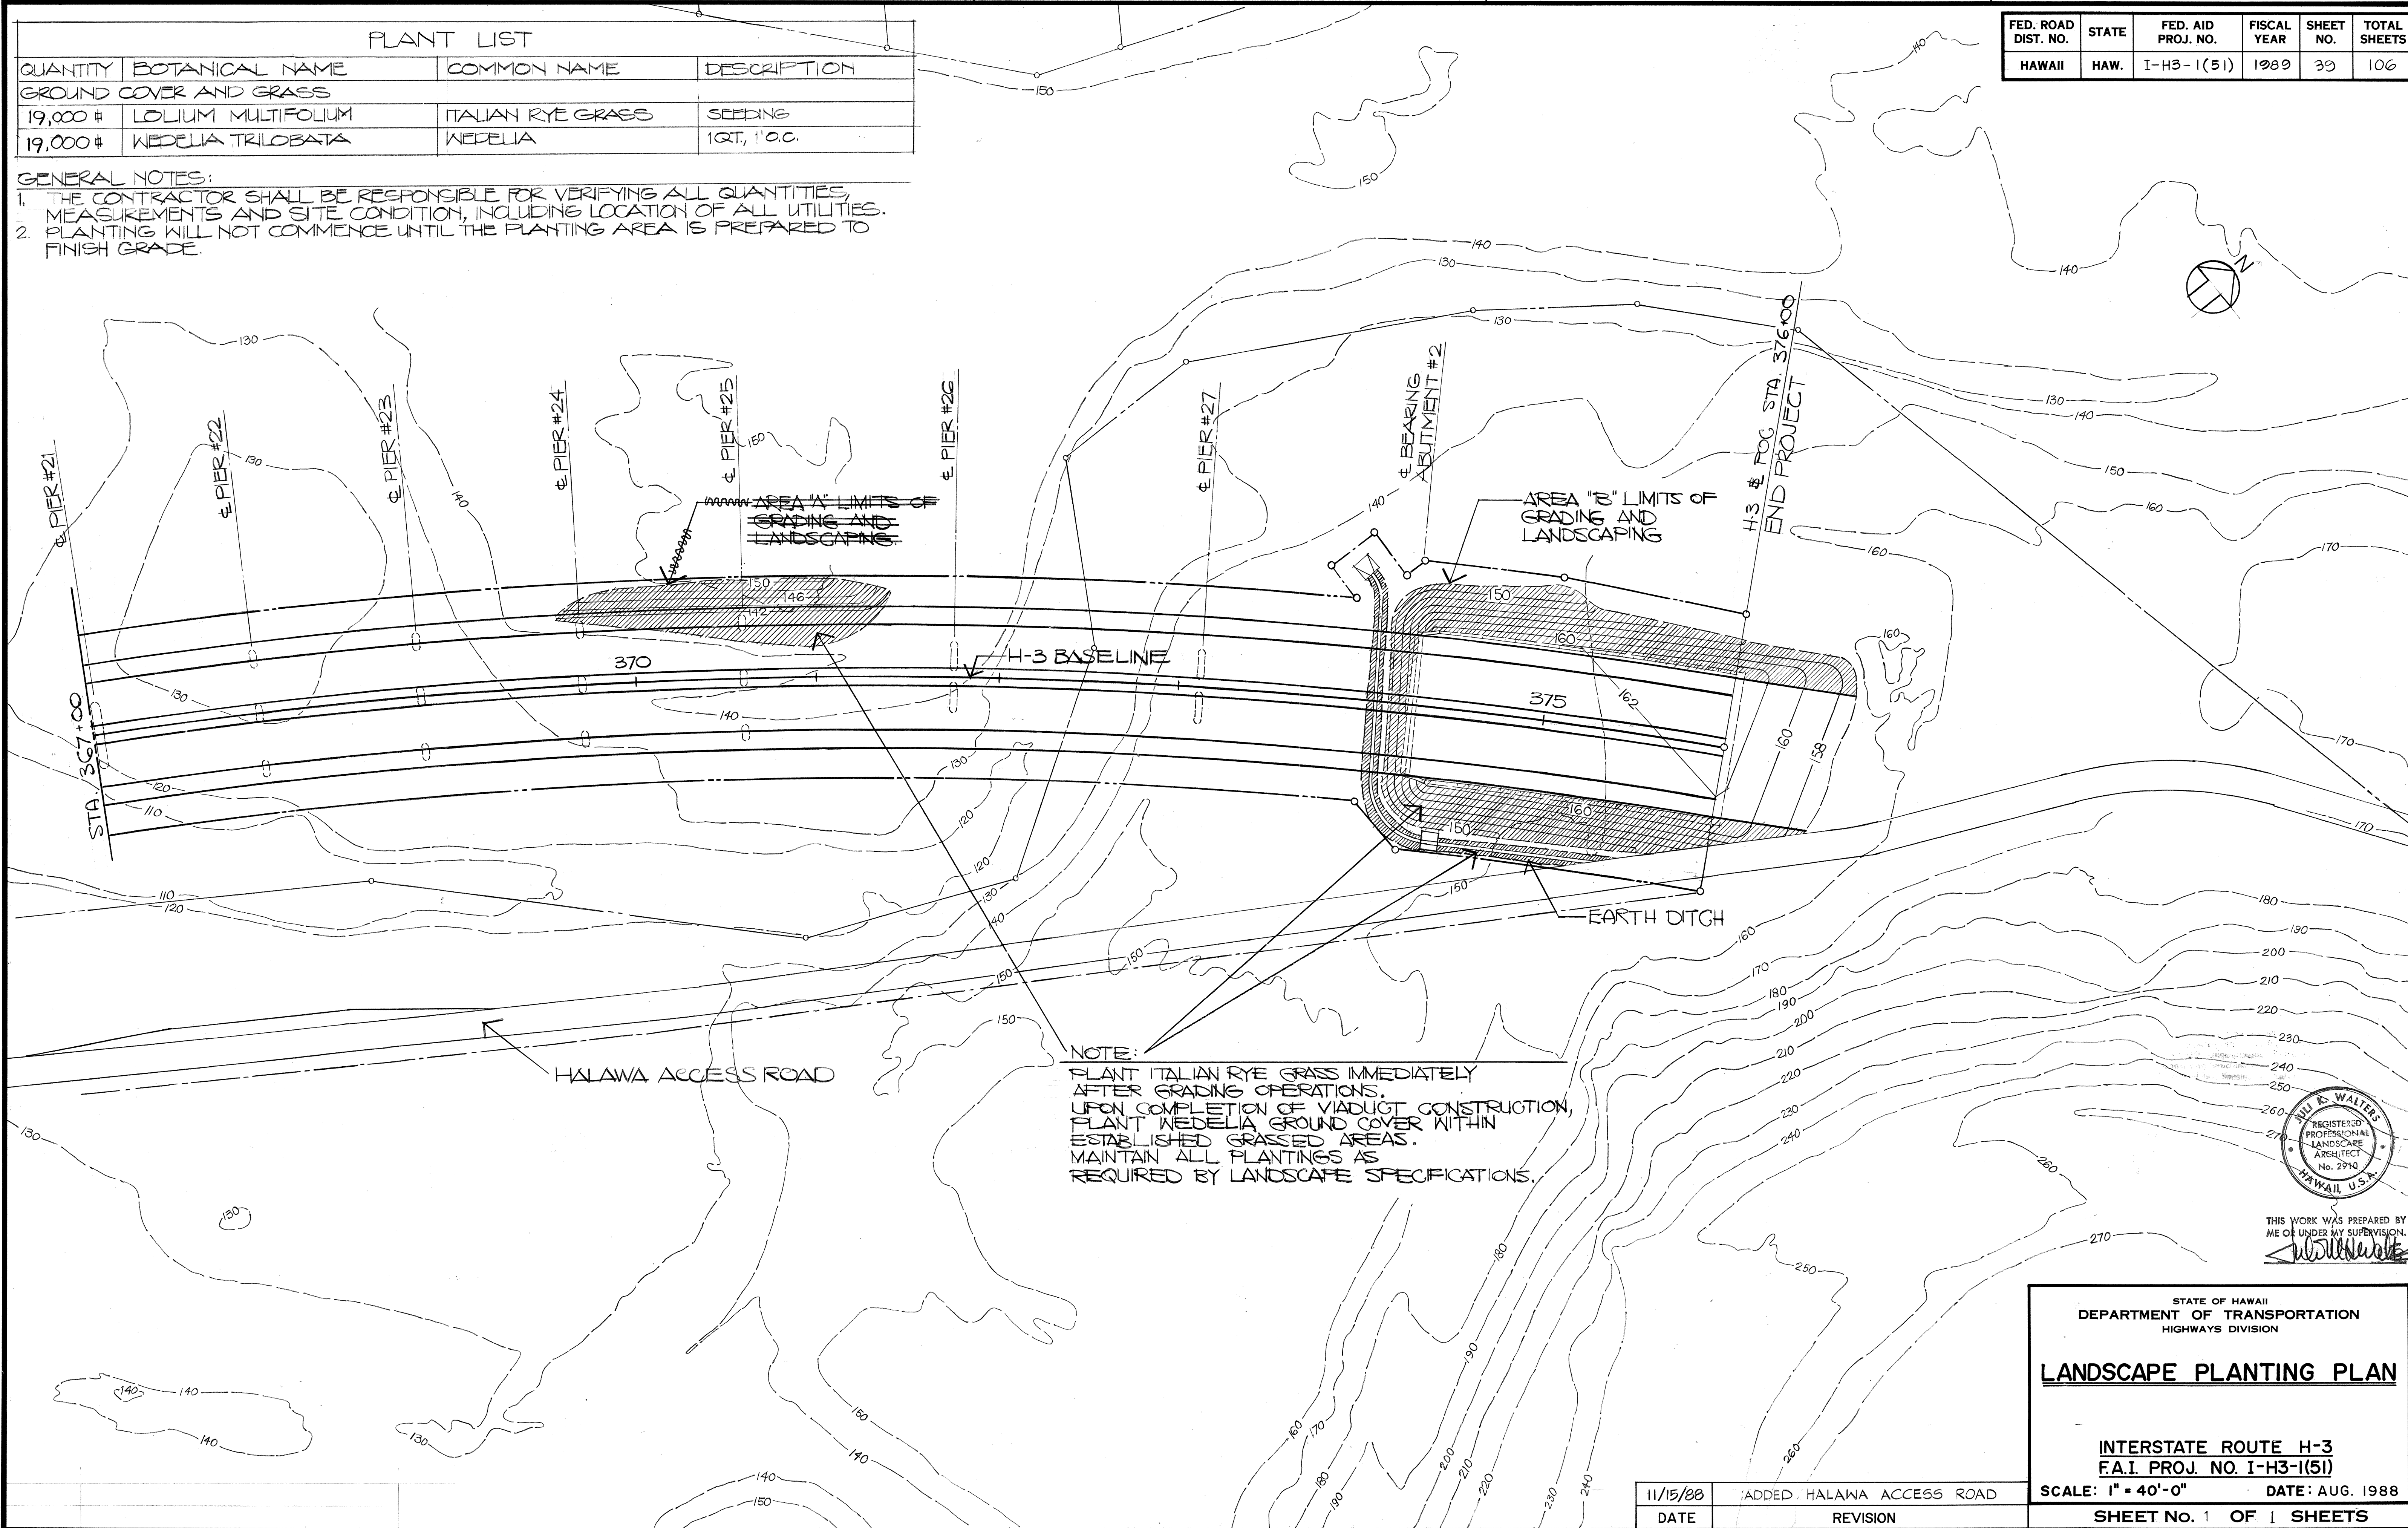

NOTE:
PLANT ITALIAN RYE GRASS IMMEDIATELY AFTER GRADING OPERATIONS.
UPON COMPLETION OF VIADUCT CONSTRUCTION, PLANT WEDELIA GROUND COVER WITHIN ESTABLISHED GRASSED AREAS.
MAINTAIN ALL PLANTINGS AS REQUIRED BY LANDSCAPE SPECIFICATIONS.

STATE OF HAWAII
DEPARTMENT OF TRANSPORTATION
HIGHWAYS DIVISION

LANDSCAPE PLANTING PLAN

INTERSTATE ROUTE H-3
F.A.I. PROJ. NO. I-H3-1(51)

SCALE: 1" = 40'-0" DATE: AUG. 1988

SHEET No. 1 OF 1 SHEETS

11/15/88	ADDED HALAWA ACCESS ROAD
DATE	REVISION