FED. ROAD DIST. NO.	STATE	FED. AID PROJ. NO.	FISCAL YEAR	SHEET NO.	TOTAL SHEETS
HAWAII	HAW.	I-H3-1(75), UNIT VI	1999	1	111

INDEX TO DRAWINGS

SHEET NO.	DESCRIPTION
1	TITLE SHEET
2 - 6	GENERAL
① 7 - 48	SIGN STRUCTURE MODIFICATIONS
49 - 55	LANDSCAPING
② 56 - 57	END TREATMENT MODIFICATIONS
58 - 59	ADDITIONAL ROADSIDE GUARDRAIL
③ 60 - 61	ADDITIONAL HIGHWAY LIGHTING
④ 62 - 76	EMERGENCY CROSSOVER MODIFICATIONS
77	DRAINAGE GRATE REPLACEMENT
78	MEETING ROOM MODIFICATIONS
79 - 86	STATE (GUARDRAIL) POLICY
87 - 111	REFERENCE PLANS

Sheet Nos. ①ADD. 22S-1 through ADD. 22S-14, ADD. 28S-1, ADD. 29S-1, ADD. 32S-1, ADD. 48S-1 through ADD. 48S-11, ②ADD. 57S-1, ADD. 59S-1, ADD. 59S-2, ③ADD. 61S-1, ADD. 61S-2, AND ④ ADD. 67S-1 through ADD. 67S-3 are supplementary sheets to this project. Total sheet count after "As-Built" posting 147 sheets.

STATE OF HAWAII

DEPARTMENT OF TRANSPORTATION

HIGHWAYS DIVISION

HONOLULU, HAWAII

"AS-BUILT"

PLANS FOR

CONSTRUCTION OF A PORTION OF

INTERSTATE ROUTE H-3

H-3 FINISH (UNIT VI)

FEDERAL AID INTERSTATE PROJECT NO. I-H3-1(75), UNIT VI

DISTRICT OF KOOLAUPOKO

ISLAND OF OAHU

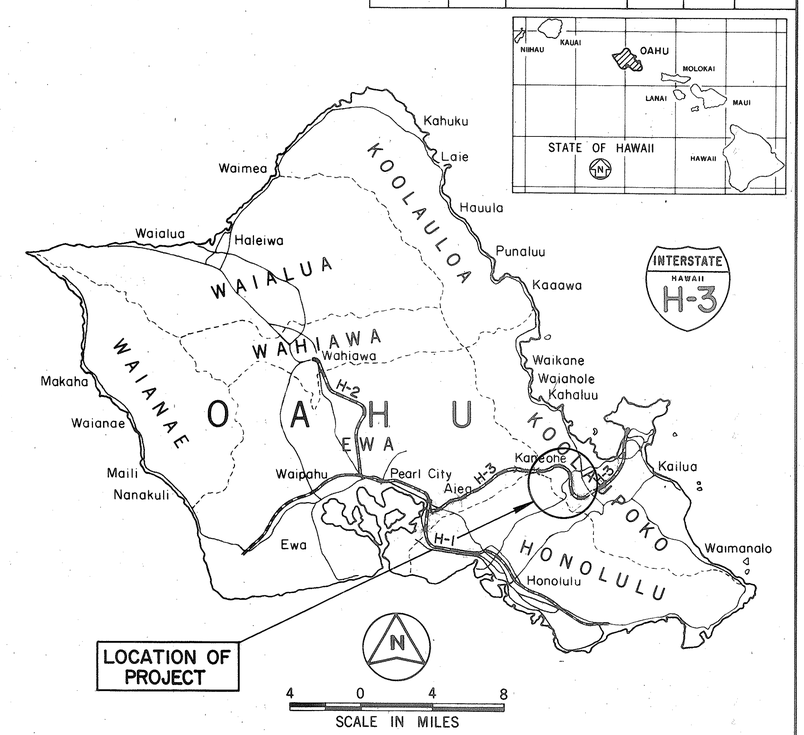

FEDERAL AID INTERSTATE PROJECTS PREVIOUSLY CONSTRUCTED OR UNDER CONSTRUCTION

MILEPOST 5.45 TO MILEPOST 11.00

DESIGN DESIGNATION

ADT (1998)	39,430
DESIGN ADT (2008)	45,220
DHV	4,282
D	76/24
T	2.1%
T_{24}	4.1%
V	60 M.P.H.

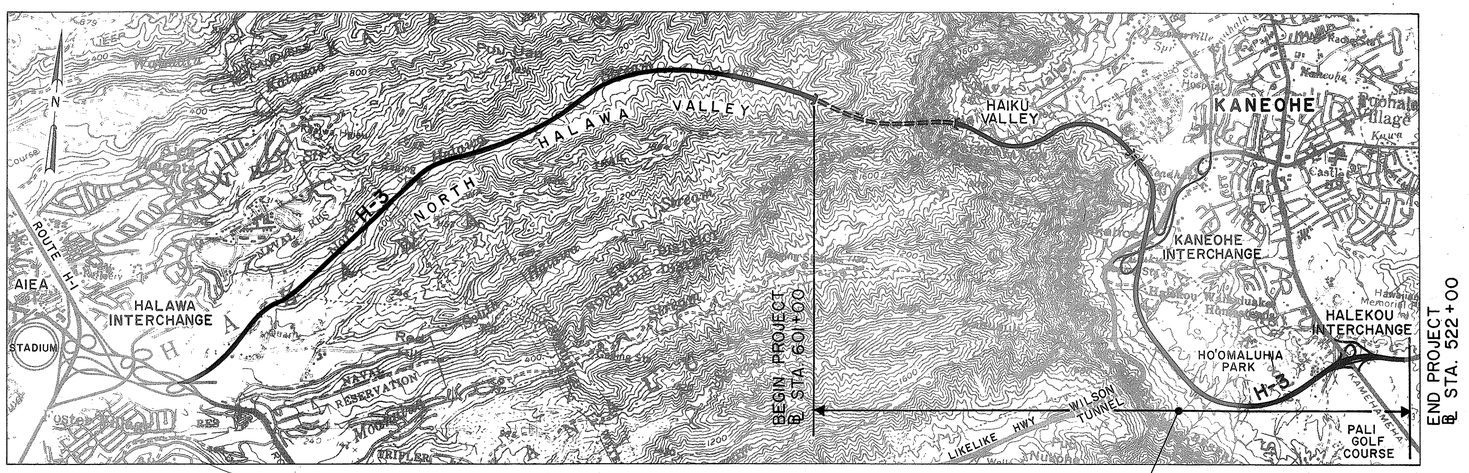

LAYOUT PLAN

LENGTH OF PROJECT 5.55 MILES

PROJECT LIMIT

F.A.I. PROJECT NO. I-H3-1(75), UNIT VI

PBHA	K. CHUN	692-7552	APRIL 1999
DESIGNED BY	P. S. & E. BY	PHONE	DATE

CHANGES MADE DURING CONSTRUCTION HAVE BEEN INCORPORATED ON THESE PLANS EXCEPT CHANGES IN THE ORIGINAL THEORETICAL QUANTITIES. FOR ACTUAL QUANTITIES, REFER TO PROJECT LEDGER AND/OR CONSTRUCTION BOOK.

RESIDENT ENGINEER — DATE 2/27/03

DEPARTMENT OF TRANSPORTATION
STATE OF HAWAII

APPROVED:

DIR. OF TRANSPORTATION — DATE 6/28/99