FED. ROAD DIST. NO.	STATE	FED. AID PROJ. NO.	FISCAL YEAR	SHEET NO.	TOTAL SHEETS
HAWAII	HAW.	I-H3-1(75) UNIT VIII	2003	2	816

INDEX TO DRAWING	
SHEET NO.	DESCRIPTION
2	TITLE SHEET
3 - 24	GENERAL
25-350	CIVIL PLANS
351-413	GEOTECHNICAL PLANS
414-703	STRUCTURAL PLANS
704-770	ELECTRICAL PLANS
771-792	LANDSCAPING PLANS

STATE OF HAWAII
DEPARTMENT OF TRANSPORTATION
HIGHWAYS DIVISION
HONOLULU, HAWAII

"AS-BUILT"

PLANS FOR

INTERSTATE ROUTE H-3
H-3 FINISH (UNIT VIII)
PROJECT NO. I-H3-1(75) UNIT VIII

DISTRICT OF EWA
ISLAND OF OAHU

CHANGES MADE DURING CONSTRUCTION HAVE BEEN INCORPORATED ON THESE PLANS EXCEPT CHANGES IN THE ORIGINAL TRACINGS. FOR ACTUAL QUANTITIES, REFER TO PROJECT LEDGER AND/OR COMPUTATION BOOK.

Kelvin Okazawa 12-10-14
FOR RESIDENT ENGINEER DATE

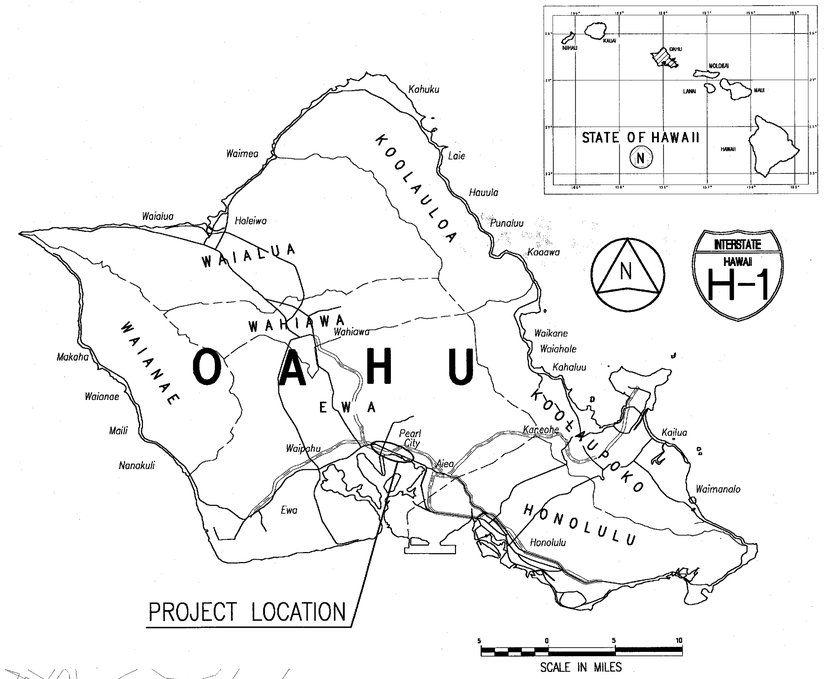

FEDERAL AID INTERSTATE PROJECTS PREVIOUSLY CONSTRUCTED OR UNDER CONSTRUCTION

MILE POST 10.53 TO MILE POST 11.85

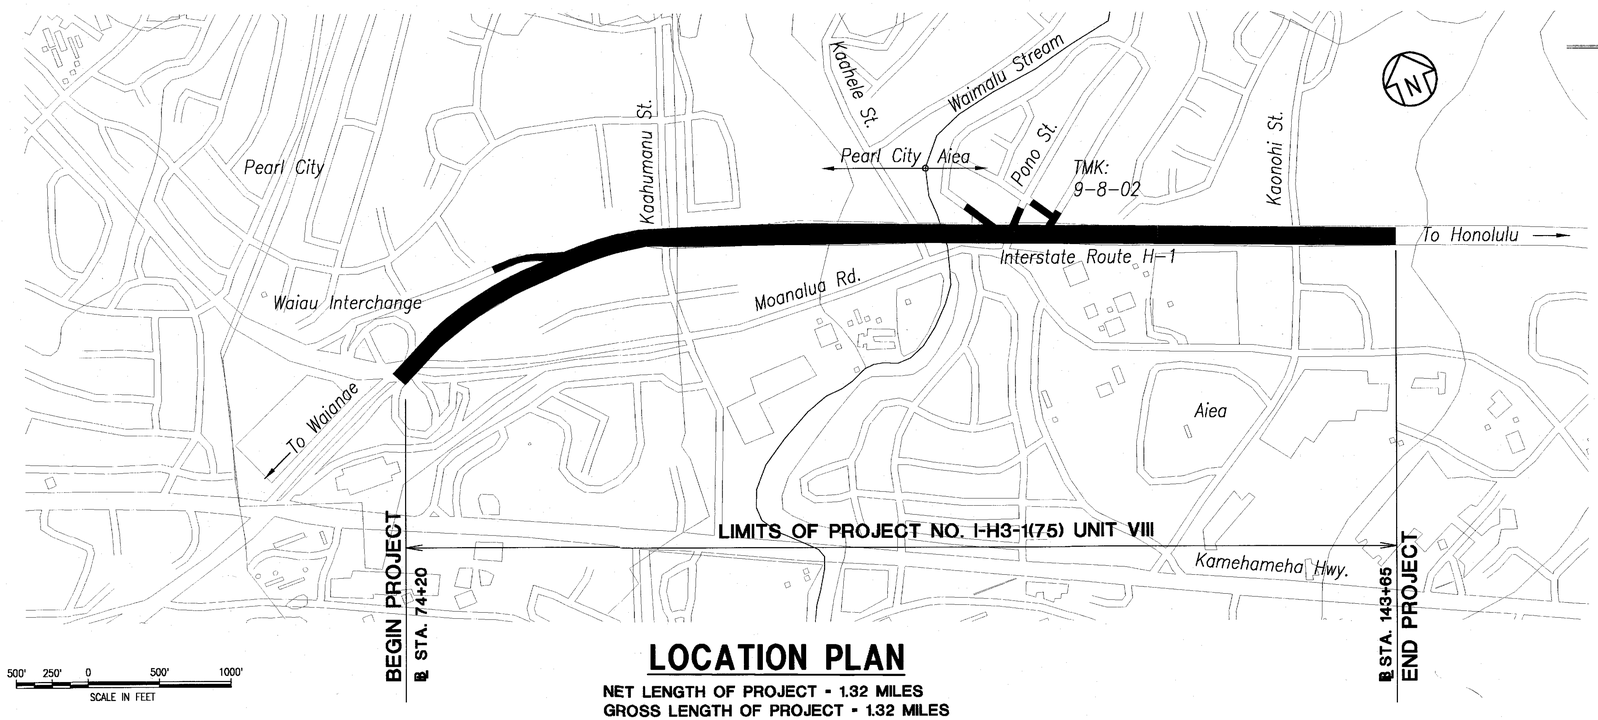

LOCATION PLAN

NET LENGTH OF PROJECT - 1.32 MILES
GROSS LENGTH OF PROJECT - 1.32 MILES

DESIGN DESIGNATION

ADT (2002) 226,000
DESIGN ADT (2022) 283,900
DHV 22,700
D (DESIGN) 75/25
T (DESIGN) 3.0%
T_{24} 3.5%
V .....60 MPH

DEPARTMENT OF TRANSPORTATION
STATE OF HAWAII
APPROVED:
for DIR. OF TRANSPORTATION 3.3.03 DATE

R.M. TOWILL CORPORATION	MAR. 2003	DATE
DESIGNED BY	692-7578	PHONE
GLENN KURASHIMA		
P.S. & E. BY		

ORIGINAL PLAN — SURVEY PLOTTED BY — DRAWN BY — TRACED BY — DESIGNED BY — QUANTITIES BY — CHECKED BY — DATE — NOTE BOOK No.

RMTC JOB NO.: 3-02424-OE