FED. ROAD DIST. NO.	STATE	FEDERAL AID PROJ. NO.	FISCAL YEAR	SHEET NO.	TOTAL SHEETS
HAWAII	HAW.	BR-H3-1(79)	2010	6	37

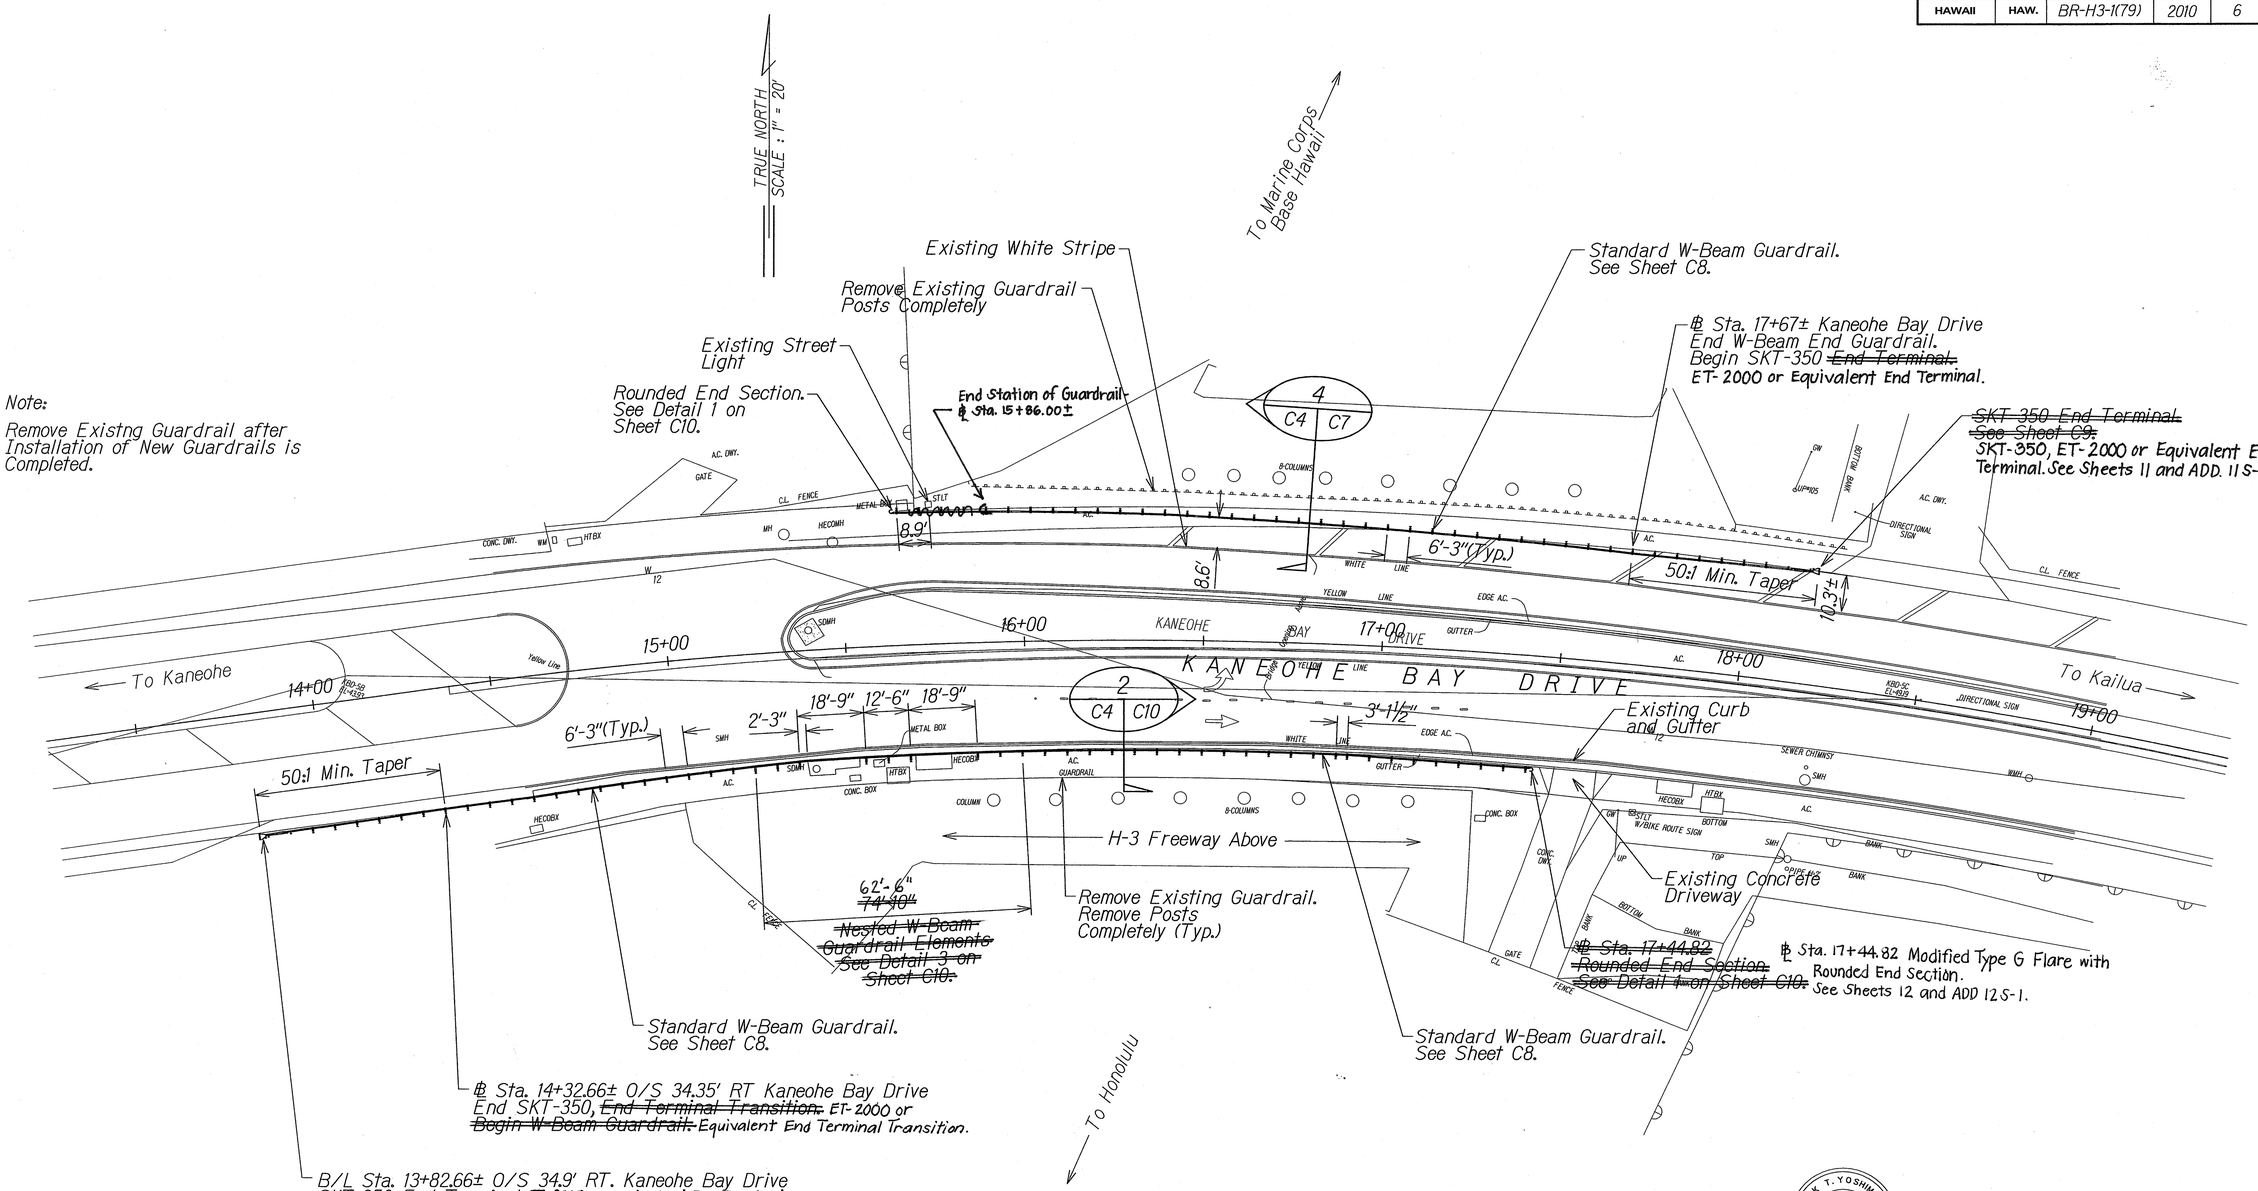

Site Plan

Scale: 1"=20'

ORIGINAL PLAN	SURVEY PLOTTED BY	DATE
	DRAWN BY	
	TRACED BY	
NOTE BOOK	DESIGNED BY	
	QUANTITIES BY	
No.	CHECKED BY	

MARK T. YOSHIMURA
LICENSED PROFESSIONAL ENGINEER
No. 6419-C
HAWAII, U.S.A.

THIS WORK WAS PREPARED BY ME OR UNDER MY SUPERVISION AND CONSTRUCTION OF THIS PROJECT WILL BE UNDER MY OBSERVATION.

Mark T. Yoshimura

EXP DATE: APRIL 2010

STATE OF HAWAII
DEPARTMENT OF TRANSPORTATION
HIGHWAYS DIVISION

SITE PLAN

Interstate Route H-3
Seismic Retrofit of Mokapu Interchange
FEDERAL AID PROJECT NO. BR-H3-1(79)

Scale: 1"=20' Date: April, 2008

SHEET No. C4 OF 11 SHEETS

"AS-BUILT"