


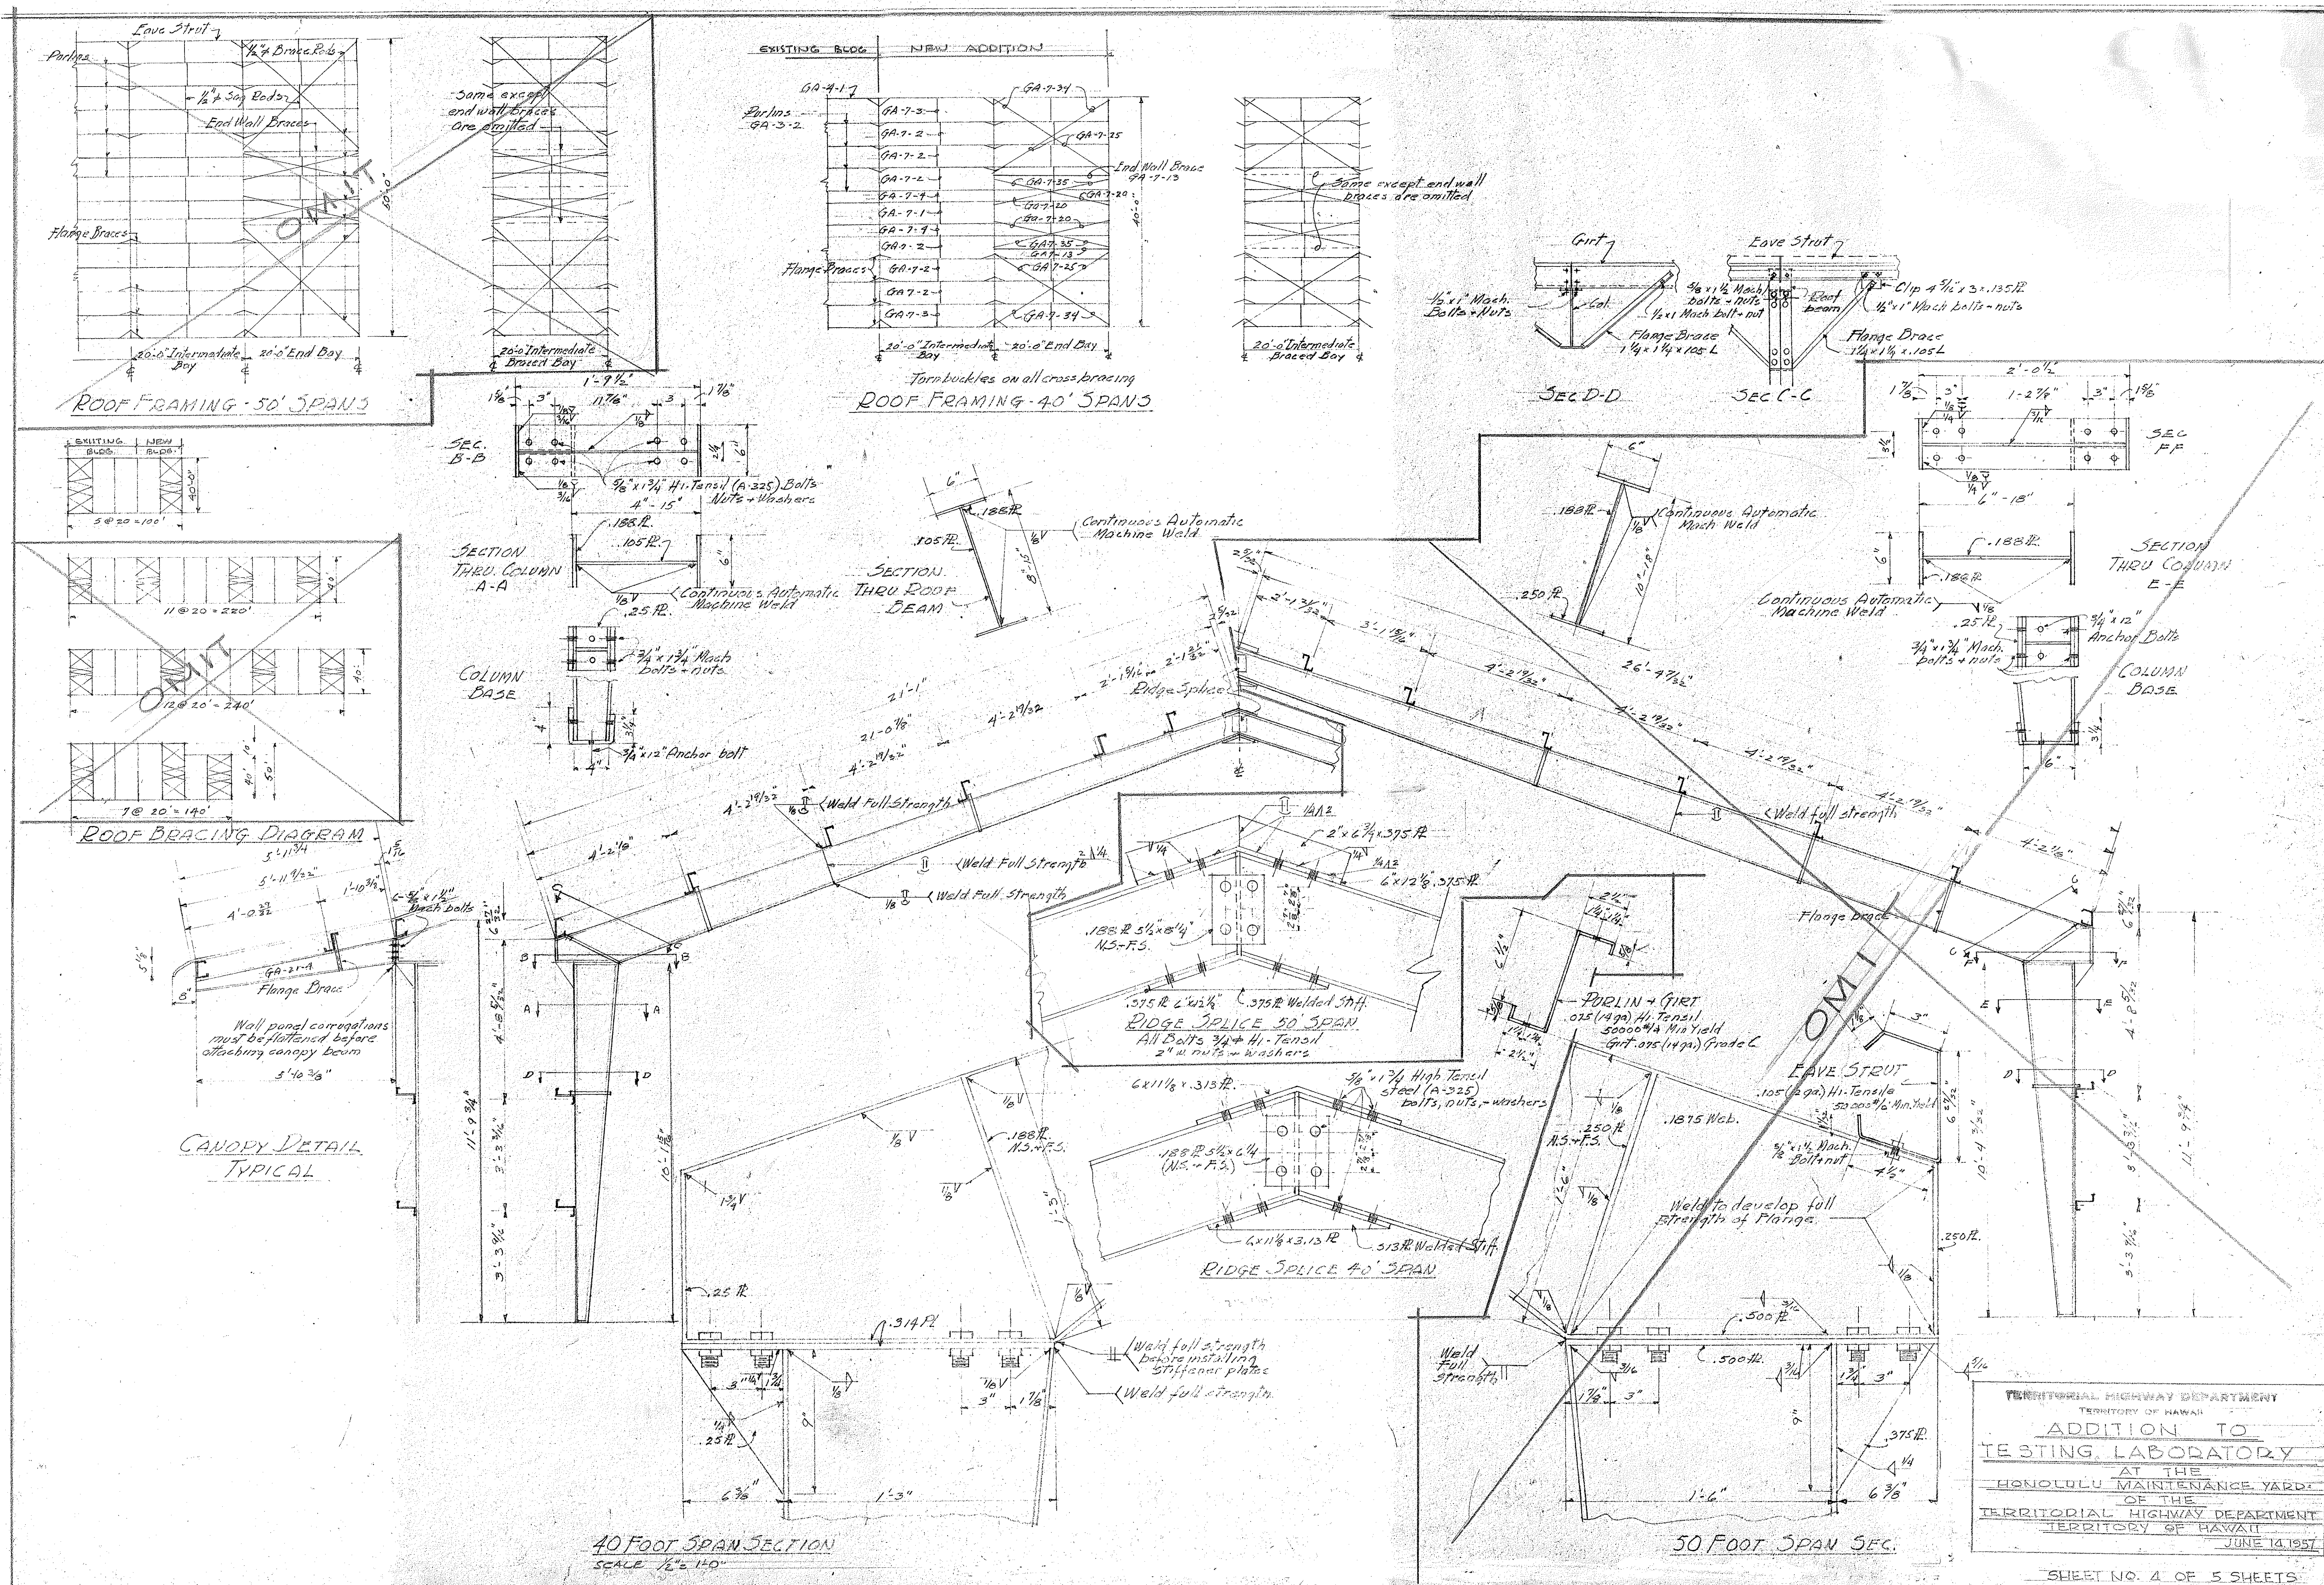

TERRITORIAL HIGHWAY DEPARTMENT
Territory of Hawaii
**ADDITION TO
TESTING LABORATORY**
AT THE
HONOLULU MAINTENANCE YARD
OF THE
TERRITORIAL HIGHWAY DEPARTMENT
Territory of Hawaii
JUNE 14, 1957