FED. ROAD DIST. NO.	STATE	PROJ. NO.	FISCAL YEAR	SHEET NO.	TOTAL SHEETS
HAWAII	HAW.	BD 70-418	1971	3	4

GENERAL NOTES

1. Line drainage ditch with Class B concrete or shotcrete from Sta. 0+00 to Sta. 7+88 - Provide smooth flowing connection to existing concrete lined ditch @ Sta. 7+88.
2. New A.C. ~~to meet~~ existing A.C. driveway - Provide tack coat for bond.
3. Sprinkler system - see D/TB
4. New A.C. paved parking area - Provide tack coat for bond to existing A.C.
5. 13'-4" x 9'-0" x 4" Reinforced concrete ramp - Remove existing temporary unreinforced concrete ramp.
6. 3'-9" x 2'-11" Catch basin - see D/TB State to provide frame and grating - Refinish A.C. swale to meet.
7. 6" Concrete pipe - Minimum cover 18" - Extend to daylight (approximately 90')
8. Elevation of CRM wall - 468.9
   Elevation of A.C. finish - 468.4
9. Elevation of CRM wall - 468.9
   Elevation of A.C. finish - 467.9
   Install 4" Galv. steel pipe in CRM wall for surface drainage
10. Elevation of CRM wall - 468.9
    Elevation of A.C. finish - 468.4
11. Elevation of A.C. finish - 470.6

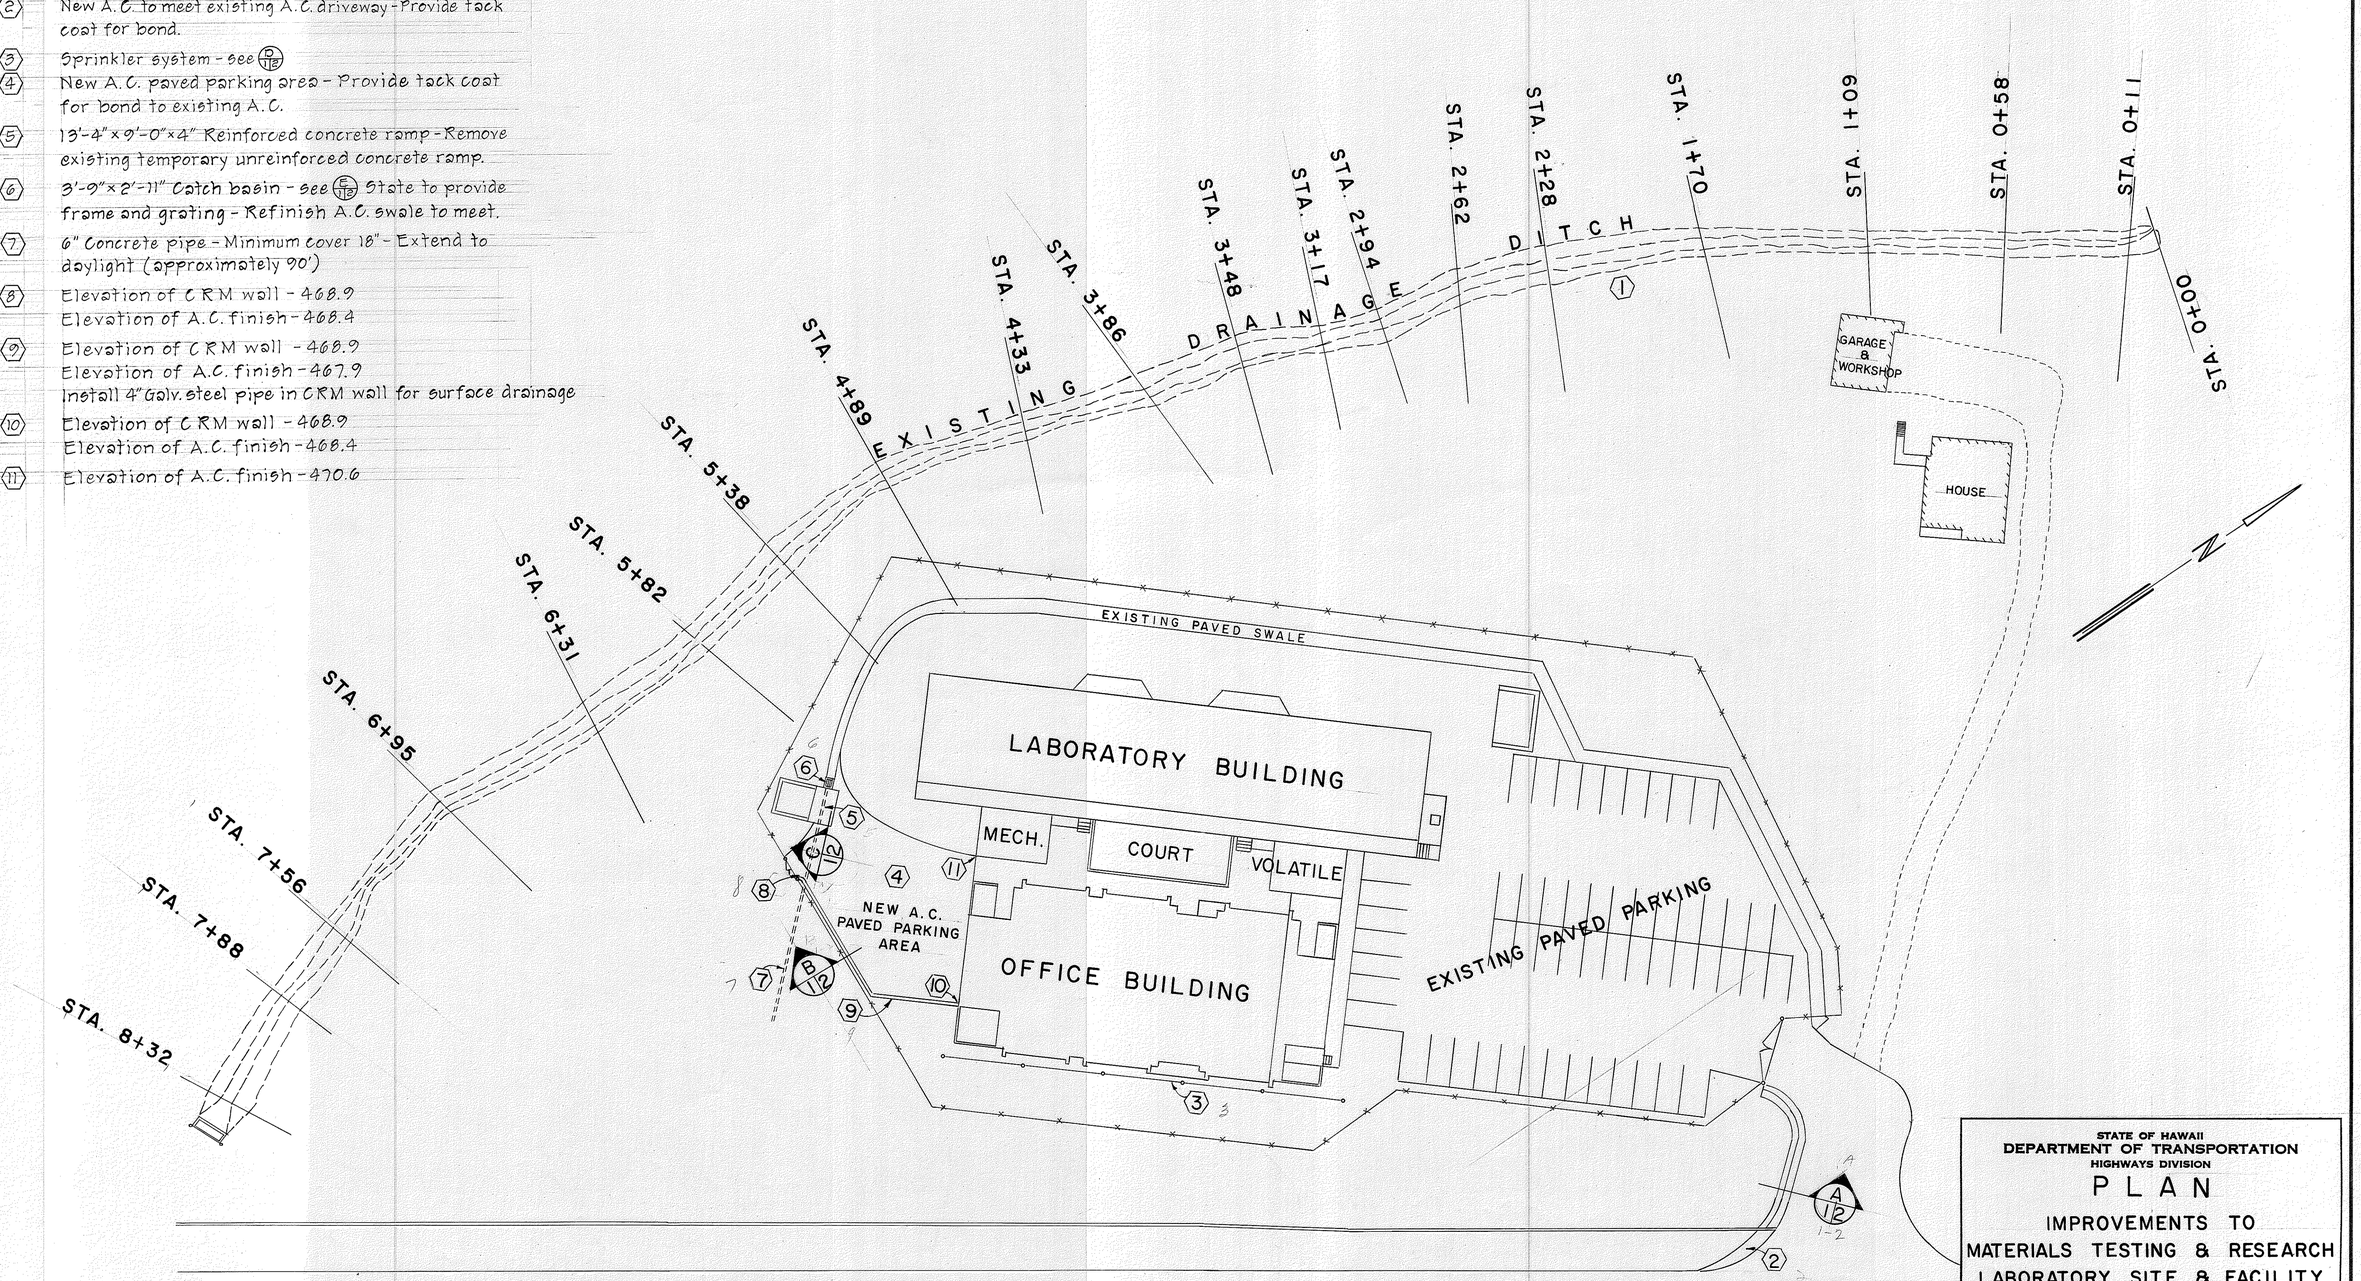

STATE OF HAWAII
DEPARTMENT OF TRANSPORTATION
HIGHWAYS DIVISION

PLAN

IMPROVEMENTS TO
MATERIALS TESTING & RESEARCH
LABORATORY SITE & FACILITY
PROJECT NO. BD 70-418

NOT TO SCALE

SHEET No. / OF / SHEETS

		DATE
ORIGINAL PLAN	SURVEY PLOTTED BY	"
	DRAWN BY	"
	TRACED BY	"
NOTE BOOK	DESIGNED BY	"
	QUANTITIES BY	"
No.	CHECKED BY	"

D-7-1

K+E IMPERIAL™ TRACING CLOTH LA 3207