FED. ROAD DIST. NO.	STATE	PROJ. NO.	FISCAL YEAR	SHEET NO.	TOTAL SHEETS
HAWAII	HAW.	HWY-O-01-00M	2000	1	3

INDEX TO DRAWINGS	
SHEET NO.	DESCRIPTION
1	TITLE SHEET
2	GENERAL NOTES AND LEGEND
⓪3	ELECTRICAL RELAMPING PLAN

SHEET NO. ⓪3S-1 IS A SUPPLEMENTAL SHEET TO THIS PROJECT. TOTAL SHEET COUNT AFTER "AS-BUILT" POSTING 4 SHEETS.

STATE OF HAWAII

DEPARTMENT OF TRANSPORTATION

HIGHWAYS DIVISION

HONOLULU, HAWAII

"AS-BUILT"

PLANS FOR

BUILDING RENOVATIONS - LIGHTS

MATERIAL TESTING AND RESEARCH BRANCH

PROJECT NO. HWY-O-01-00M

2530 LIKELIKE HIGHWAY
HONOLULU, HAWAII
TAX MAP KEY 1-4-22:14

DISTRICT OF HONOLULU
ISLAND OF OAHU

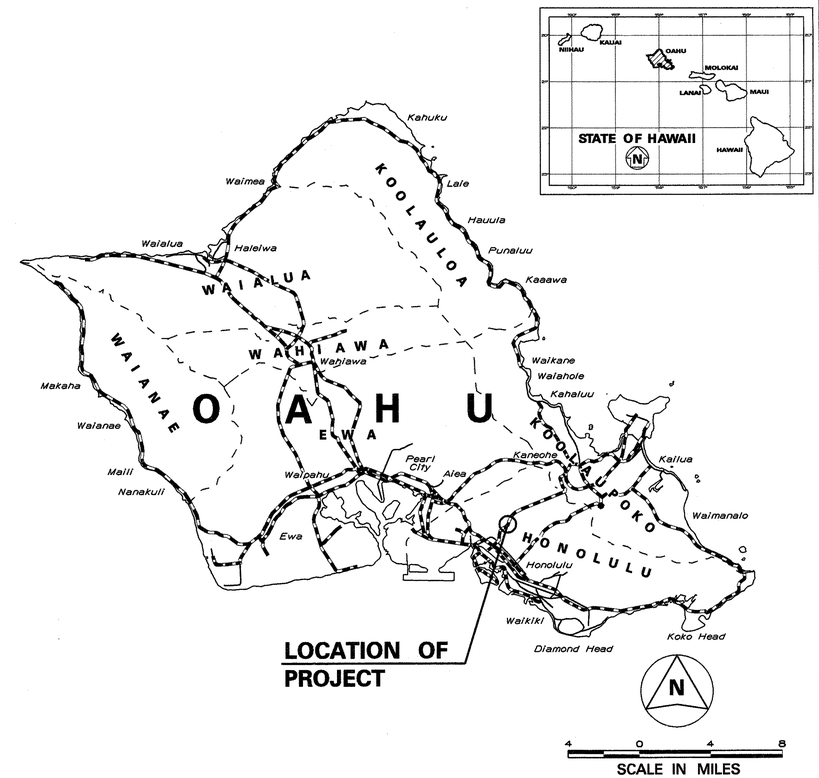

FEDERAL AID PROJECTS PREVIOUSLY CONSTRUCTED OR UNDER CONSTRUCTION

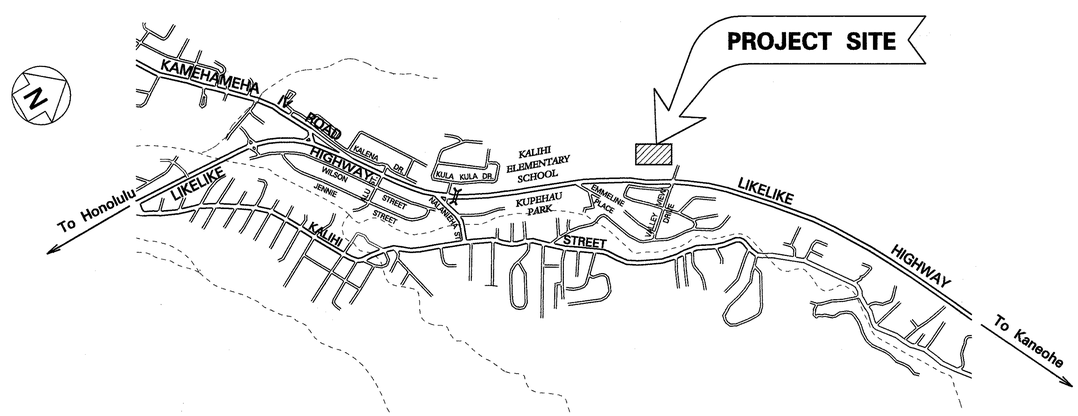

LOCATION PLAN

5 0 5 10 15
SCALE IN HUNDRED FEET

CHANGES MADE DURING CONSTRUCTION HAVE BEEN INCORPORATED ON THESE PLANS EXCEPT CHANGES IN THE ORIGINAL THEORETICAL QUANTITIES. FOR ACTUAL QUANTITIES, REFER TO PROJECT LEDGER AND/OR COMPUTATION BOOK.

Robert Sui — RESIDENT ENGINEER — 12-10-9 DATE

DEPARTMENT OF TRANSPORTATION
STATE OF HAWAII

APPROVED:
Kazu Hayashida — DIR. OF TRANSPORTATION — 5/18/00 DATE

HWY-OD	K. TATSUGUCHI	692-7578	MAY, 2000
DESIGNED BY	P. S. & E. BY	PHONE	DATE